

\*\*\*\*\*  
 WATER WELL ABANDONMENT-SEALING REPORT FORM  
 \*\*\*\*\*

SUBMIT COPIES OF COMPLETED FORM TO:

- \* COUNTY ENVIRONMENTAL AGENCY (contact MDE, WMA if address needed)
- \* WELL OWNER
- \* MDE, WATER MANAGEMENT ADMINISTRATION, WELL PROGRAM

OK  
 12/29/15 SC

DATE WELL ABANDONED: 8-7-2015 (month/day/year)

\* PERMIT NUMBER OF ABANDONED WELL (if any) HO - 73 - 3058

\* PERMIT NUMBER OF REPLACEMENT WELL: none

\* PERSON ABANDONING WELL: Joseph & Mayra WELL DRILLER'S LICENSE NUMBER: MSD 024


CIRCLE: MWD / MSD / MGD

\* OWNER'S NAME: Owen and Patricia Clay Woodward

\* WELL LOCATION:

SITE LOCATION MAP

COUNTY: Howard  
 NEAREST TOWN: Columbia 21046  
 TAX MAP BLOCK PARCEL: 420  
 SUBDIVISION: Holiday Hills / Reverse Edge  
 SECTION: \_\_\_\_\_ LOT: 25  
 STREET ADDRESS: 10715 Moorbergen Ct

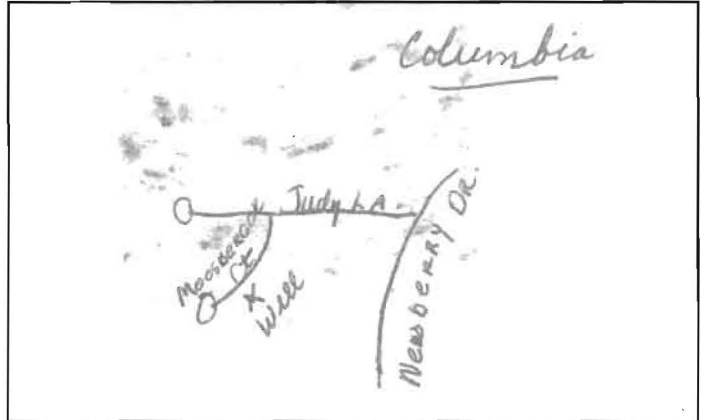

LATITUDE 3 9 . 1 7 5 3 7 -

LONGITUDE 7 6 . 8 8 9 6 0 -

\* TYPE OF WELL BEING ABANDONED:

- DRILLED  JETTED
- BORED  HAND DUG
- OTHER (specify) \_\_\_\_\_

LOG OF SEALING MATERIAL

\* USE CODE:

- DOMESTIC  MUNICIPAL/PUBLIC
- IRRIGATION  INDUSTRIAL
- TEST/OBSERVATION  GEOTHERMAL

\* TYPE OF CASING:

- STEEL  PLASTIC
- CONCRETE  OTHER (specify) \_\_\_\_\_

MATERIAL	FEET	
	FROM	TO
Cement + gravel mixed	0	140'

SIZE OF CASING: 6 INCHES IN DIAMETER

DEPTH OF WELL: 140 FEET DEEP

WAS ANY CASING REMOVED?  YES  NO  
 If yes, length removed, in feet: 2

WAS CASING RIPPED OR PERFORATED?  YES  NO

VOLUME OF MATERIAL USED

SIGNATURE-MASTER WELL DRILLER OR SUPERVISING SANITARIAN Joseph & Mayra LICENSE# MSD 024 CIRCLE ONE MWD / MSD / MGS DATE 8-10-2015

COUNTY