

WATER WELL ABANDONMENT-SEALING REPORT FORM

SUBMIT COPIES OF COMPLETED FORM TO:

- * COUNTY ENVIRONMENTAL AGENCY (contact MDE, WMA if address needed)
- * WELL OWNER
- * MDE, WATER MANAGEMENT ADMINISTRATION, WELL PROGRAM

OK
12/29/15 JC

DATE WELL ABANDONED: 10/8/2014 (month/day/year)

* PERMIT NUMBER OF ABANDONED WELL (if any) _____

* PERMIT NUMBER OF REPLACEMENT WELL: _____

* PERSON ABANDONING WELL: Richard A. Cunniff WELL DRILLER'S LICENSE NUMBER: WP0014

CIRCLE: MWD / MSD / MGD


* OWNER'S NAME: MICHAEL BALAKIRSKY

* WELL LOCATION:
 COUNTY: HOWARD
 NEAREST TOWN: CLARKSVILLE
 TAX MAP _____ BLOCK _____ PARCEL _____
 SUBDIVISION: _____
 SECTION: _____ LOT: _____
 STREET ADDRESS: 5626 OAKLAND MILL RD

LATITUDE 39.6

LONGITUDE 76.839390

SITE LOCATION MAP

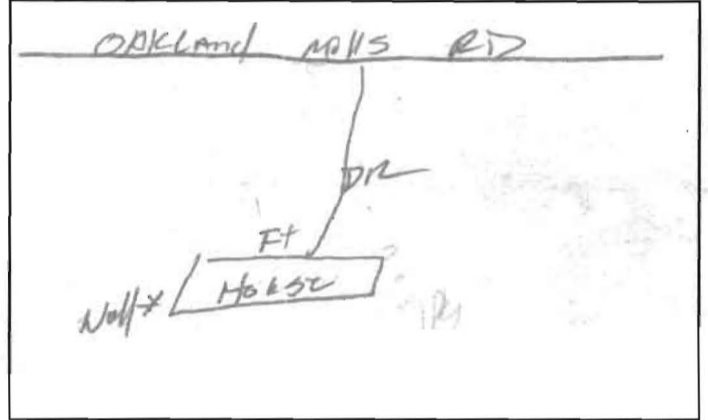

- * TYPE OF WELL BEING ABANDONED:
 DRILLED JETTED
 BORED HAND DUG
 OTHER (specify) _____

- * USE CODE:
 DOMESTIC MUNICIPAL/PUBLIC
 IRRIGATION INDUSTRIAL
 TEST/OBSERVATION GEOTHERMAL

- * TYPE OF CASING:
 STEEL PLASTIC
 CONCRETE OTHER (specify) _____

SIZE OF CASING: 6 INCHES IN DIAMETER

DEPTH OF WELL: 70 FEET DEEP

WAS ANY CASING REMOVED? YES NO
 If yes, length removed, in feet: _____

WAS CASING RIPPED OR PERFORATED? YES NO

SIGNATURE: George F. Eustenberg LICENSE# 040

LOG OF SEALING MATERIAL

MATERIAL	FEET	
	FROM	TO
Bentonite	70	5
well pit	3	0
VOLUME OF MATERIAL USED		
<u>8 Bag of Bentonite</u>		

MWD / MSD / MGS 10-15-14
 CIRCLE ONE DATE

-COUNTY