
 WATER WELL ABANDONMENT-SEALING REPORT FORM

SUBMIT COPIES OF COMPLETED FORM TO:

- * COUNTY ENVIRONMENTAL AGENCY (contact MDE, WMA if address needed)
- * WELL OWNER
- * MDE, WATER MANAGEMENT ADMINISTRATION, WELL PROGRAM

OK
 12/31/15 SC

DATE WELL ABANDONED: July 3 2015 (month/day/year)

* PERMIT NUMBER OF ABANDONED WELL (if any) N/A

* PERMIT NUMBER OF REPLACEMENT WELL: N/A

* PERSON ABANDONING WELL: Ralph E. Mayne


WELL DRILLER'S LICENSE NUMBER: 117

CIRCLE: MWD / MSD / MGD

* OWNER'S NAME: Land Design & Development

* WELL LOCATION:
 COUNTY: Howard
 NEAREST TOWN: WOODBINE
 TAX MAP BLOCK PARCEL
 SUBDIVISION: N/A
 SECTION: N/A LOT: N/A
 STREET ADDRESS: 15100 Old Fred. Rd

SITE LOCATION MAP

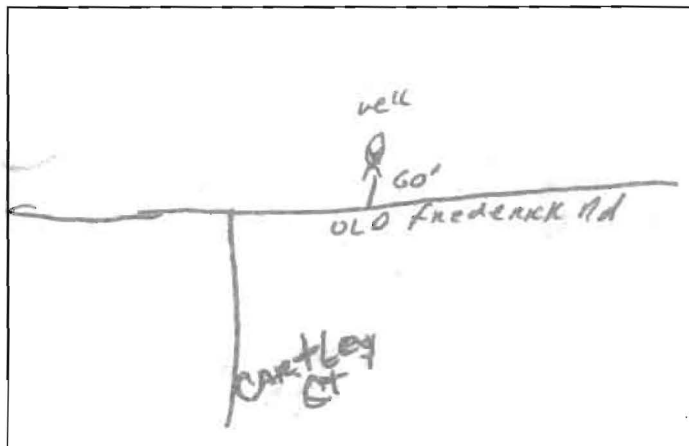

LATITUDE 3 9.33959

LONGITUDE 7 7.04152

* TYPE OF WELL BEING ABANDONED:
 DRILLED JETTED
 BORED HAND DUG
 OTHER (specify) _____

LOG OF SEALING MATERIAL

MATERIAL	FEET	
	FROM	TO
Cement	55	5
Top Soil	5	0
VOLUME OF MATERIAL USED		

* USE CODE: DOMESTIC
 IRRIGATION MUNICIPAL/PUBLIC
 TEST/OBSERVATION INDUSTRIAL
 _____ GEOTHERMAL

* TYPE OF CASING:
 STEEL PLASTIC
 CONCRETE OTHER (specify) _____

SIZE OF CASING: 6 INCHES IN DIAMETER

DEPTH OF WELL: 60 FEET DEEP

WAS ANY CASING REMOVED? YES NO
 If yes, length removed, in feet: _____

WAS CASING RIPPED OR PERFORATED? YES NO

COUNTY

