

05-383884
PERMIT

SEWAGE DISPOSAL SYSTEM

MARYLAND STATE DEPARTMENT OF HEALTH

HOWARD COUNTY

ELLICOTT CITY

DISTRICT 5th

DATE March 16, 1981

INDEXED

Mr. James W. Keatts & Bros., Inc.

IS PERMITTED TO INSTALL X ALTER

ADDRESS 5819 Washington Blvd., Baltimore, Md

PHONE 796-2585

SUBDIVISION Allnut Farm Estates

ROAD 13440 Allnut Lane LOT 1 Sec.2

PROPERTY OWNER William Turner

ADDRESS 1012 Montrose Ave, Laurel, Md 20810

SPECIFICATIONS 4 Bedrooms

SEPTIC TANK CAPACITY 1250 GALLONS

**Drywell
and Trench**

DRAIN FIELD _____ DEPTH _____ FEET. BOTTOM AREA _____ SQ. FT.

DEEP TRENCH _____ DEPTH _____ FEET. BOTTOM AREA _____ SQ. FT.

SEEPAGE PITS X ABSORBENT SIDE-WALL AREA 360 SQ. FT. per 3 bedroom 3

INLET PIPE 3 FT. BELOW ORIGINAL GRADE. MAXIMUM DEPTH 10 FT. BELOW ORIGINAL GRADE

EFFECTIVE DEPTH AT _____ FT. BELOW ORIGINAL GRADE.

LOCATE DISPOSAL AREA 10 FT. FROM left LOT LINE AND 110 FT. FROM front LOT LINE AS SEEN WHEN
FACING LOT FROM Allnut Lane.

Trench to run on contour parallel to Allnut Drive north 120' from road.

Note: LEAVE 5 FT. EARTH BUFFER BETWEEN DRY WELL AND TRENCH. CALL FOR TWO INSPECTIONS
BEFORE AND AFTER GRAVEL IS INSTALLED.

PLANS APPROVED BY David J. O'Neill - Fred Frommelt

DATE 2/6/78 - 3/16/81

COVER NO WORK UNTIL INSPECTED AND APPROVED.

NEITHER THE HOWARD COUNTY COUNCIL NOR THE HEALTH DEPARTMENT IS RESPONSIBLE FOR THE SUCCESSFUL OPERATION OF ANY SYSTEM.

NOTE: IF TRENCH IS USED CALL FOR INSPECTION BEFORE PLACING GRAVEL IN TRENCH.

NOTE: NO DRY WELL SHALL EXCEED 16 FOOT IN DIAMETER.

NOTE: ALL PIPE FROM HOUSE TO DISPOSAL AREA MUST BE CAST IRON.

PERMIT VOID AFTER THREE YEARS.

NOTE: INSTALL STAND PIPE ON SEPTIC TANK AND DRY WELL. STAND PIPES MUST BE 8 INCHES IN DIAMETER. CAST IRON, CONCRETE OR TERRA
COTTA ACCEPTED.

*INSTALLER IS RESPONSIBLE FOR OBTAINING FINAL APPROVAL ON THIS PERMIT.


APPROVED
3/20/81
P 31231
A 24686

4800/4 B.R.

for 4 B.R. 13'x13'x10' deep drywell 21" dia @ 5' plus 18' long trench 3' wide 10' deep 5' from under pipe

24686

MR & MRS WILLIAM TURNER
1012 MONTROSE AVE
LAUREL, MD 20810

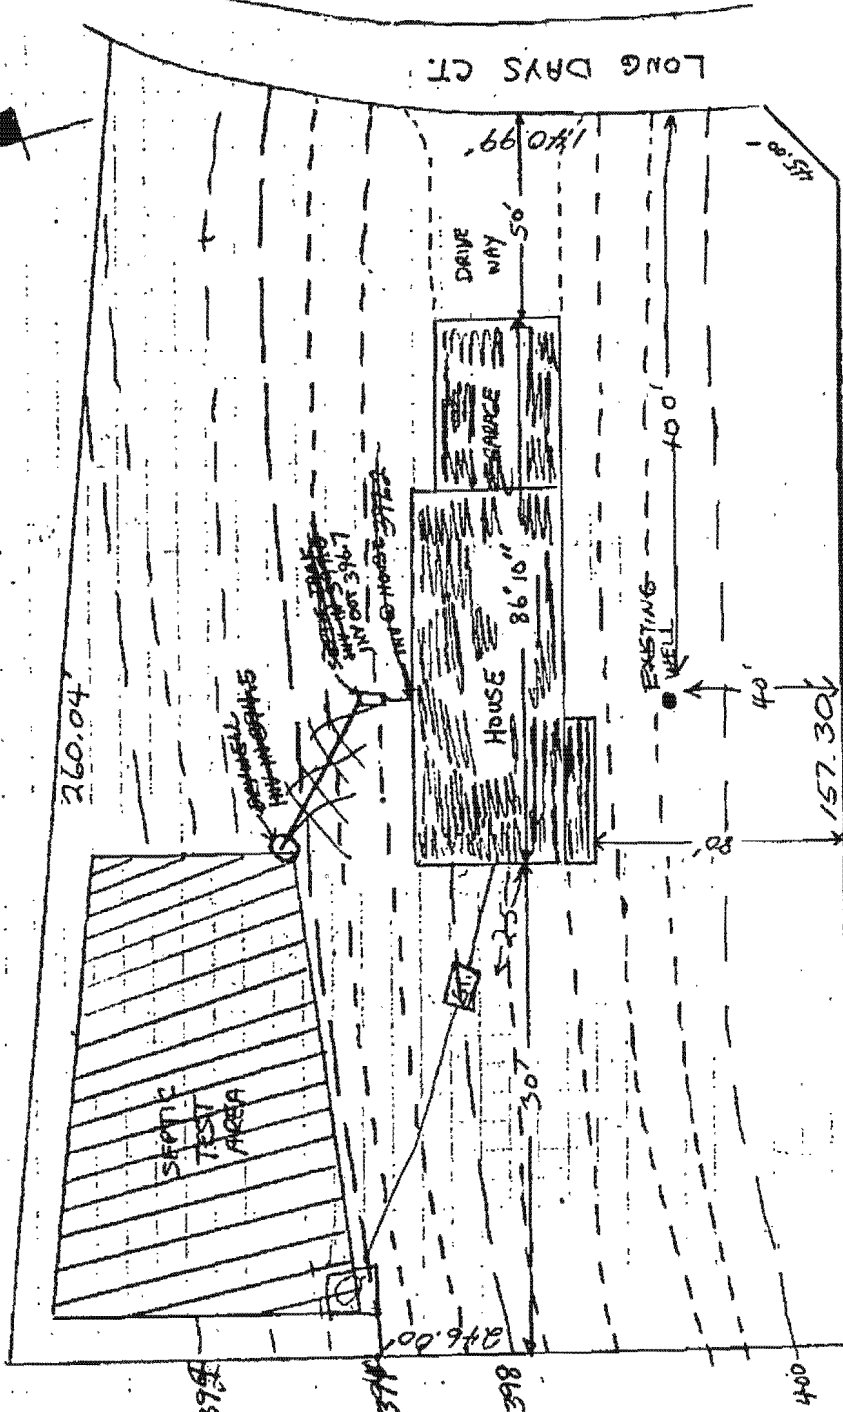

LOT ①
5TH ELECTION DISTRICT
HOWARD COUNTY, MARYLAND

Elev.

Back - 393'

FF - 402'

House INV. - 392'

ST. INV. - 391.5'

ST. ELEV - 396'

D.W. ELEV - 394'

D.W. INV - 391'

WELL - 398'

Radio tower 11/21/80

11/21/80 Shuter

O.K.

regranted 10/20/80