

# APPLICATION

## SEWAGE DISPOSAL TESTING

STATE OF MARYLAND · DEPARTMENT OF HEALTH AND MENTAL HYGIENE

HOWARD COUNTY HEALTH DEPARTMENT  
ENVIRONMENTAL HEALTH SERVICES

P. O. BOX 476, ELLICOTT CITY, MARYLAND 21043  
TELEPHONE: 465-5000, EXT. 356

DISTRICT Fifth

DATE 9/9/76

TO: THE COUNTY HEALTH OFFICER  
ELLICOTT CITY, MARYLAND

I, HEREBY, APPLY FOR THE NECESSARY TEST IN ORDER TO CONSTRUCT (OR RECONSTRUCT) A SEWAGE DISPOSAL SYSTEM.

PROPERTY OWNER Mr. and Mrs. Smith W. Allnutt, Jr.

ADDRESS 13288 Highland Road  
Highland, Maryland 20777 PHONE 988-9303

PROPERTY LOCATION:

SUBDIVISION H1 - Land Farm Estates LOT NO. 1

ROAD AND DESCRIPTION Highland Road and Road "A"

SIZE OF LOT 0.95 Ac. TYPE BLDG. 3 or 4 bedroom  
NUMBER OF BEDROOMS

IF NOT SINGLE RESIDENCE DESCRIBE \_\_\_\_\_

THE SYSTEM INSTALLED UNDER THIS APPLICATION IS ACCEPTABLE ONLY UNTIL PUBLIC FACILITIES BECOME AVAILABLE.

SIGNATURE OF APPLICANT /s/ Margaret G. Allnutt


APPROVED BY \_\_\_\_\_ FOR \_\_\_\_\_ DATE \_\_\_\_\_  
(KIND OF SYSTEM)

REJECTED BY \_\_\_\_\_ FOR \_\_\_\_\_ DATE \_\_\_\_\_  
(KIND OF SYSTEM)

HOLD PENDING FURTHER TESTS \_\_\_\_\_ DATE \_\_\_\_\_

REASONS FOR REJECTION OR HOLDING \_\_\_\_\_

# THIS IS NOT A PERMIT

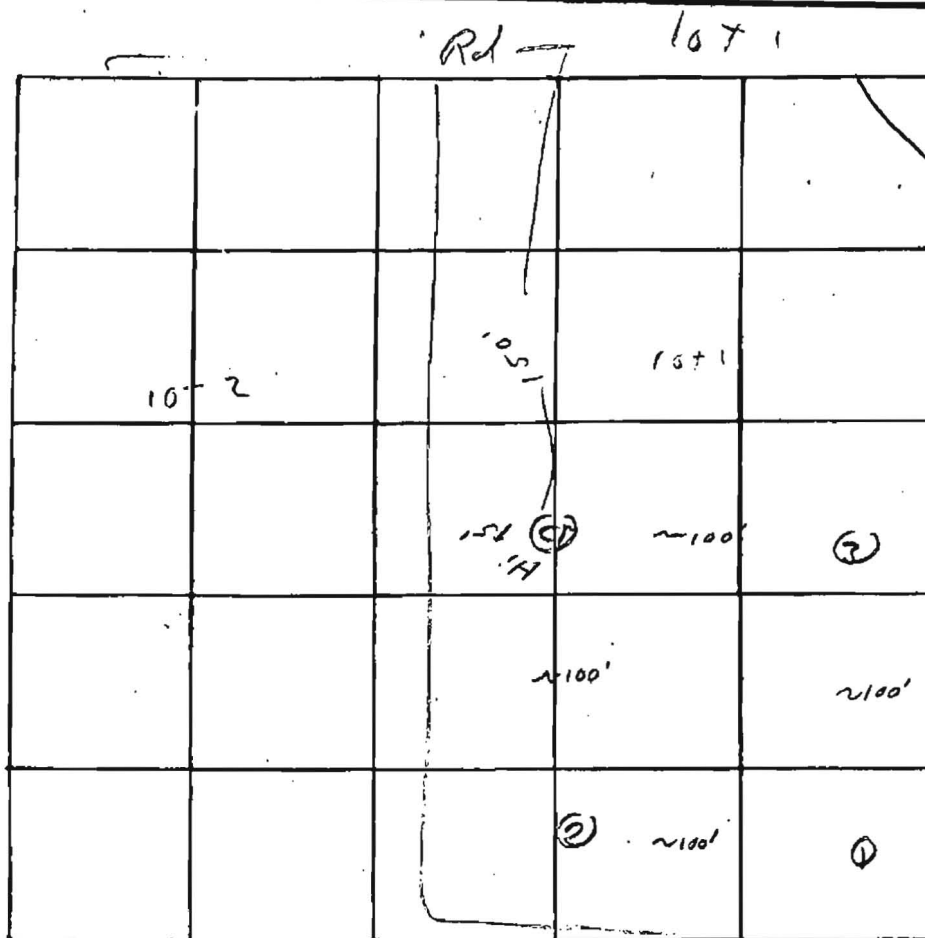

| DATE   | TEST NO. | DEPTH  | PRE-WET                        |      | TEST - 1" DROP |      | TIME |
|--------|----------|--------|--------------------------------|------|----------------|------|------|
|        |          |        | START                          | STOP | START          | STOP |      |
| 9/1/94 | 15       | 13'    | 334                            | 340  | 346            | 403  | 15   |
|        | d        | 12'    | 334                            | 336  | 336            | 340  | 41   |
|        | 35       | 4'     | 339                            | 340  | 340            | 346  | 6    |
|        | d        | 13'    | 339                            | 340  | 340            | 356  | 16   |
|        | 45       | 3 1/2' | 343                            |      |                | 350  |      |
|        | d        | 13'    | 355                            | 351  | 351            | 353  | 3    |
|        | 2        | 12'    | Visual 4-12' Reddish Clay loam |      |                |      |      |
|        |          |        | 14 S. turn & OK                |      |                |      |      |
|        |          |        |                                |      |                |      |      |
|        |          |        |                                |      |                |      |      |
|        |          |        |                                |      |                |      |      |

REMARKS \_\_\_\_\_

TYPE OF SOIL \_\_\_\_\_

TESTED BY \_\_\_\_\_ ALSO PRESENT: \_\_\_\_\_

45  
0.899/2  
No Soil Descriptions