

THE ASSOCIATION


(MAIN NOT A

LOT 9
52,490 Sq.Ft.±

LOT 7
46,663 Sq.Ft

LOT 8
48,928 Sq.Ft.±

10/30/00
New well
Site OK
as shown
H

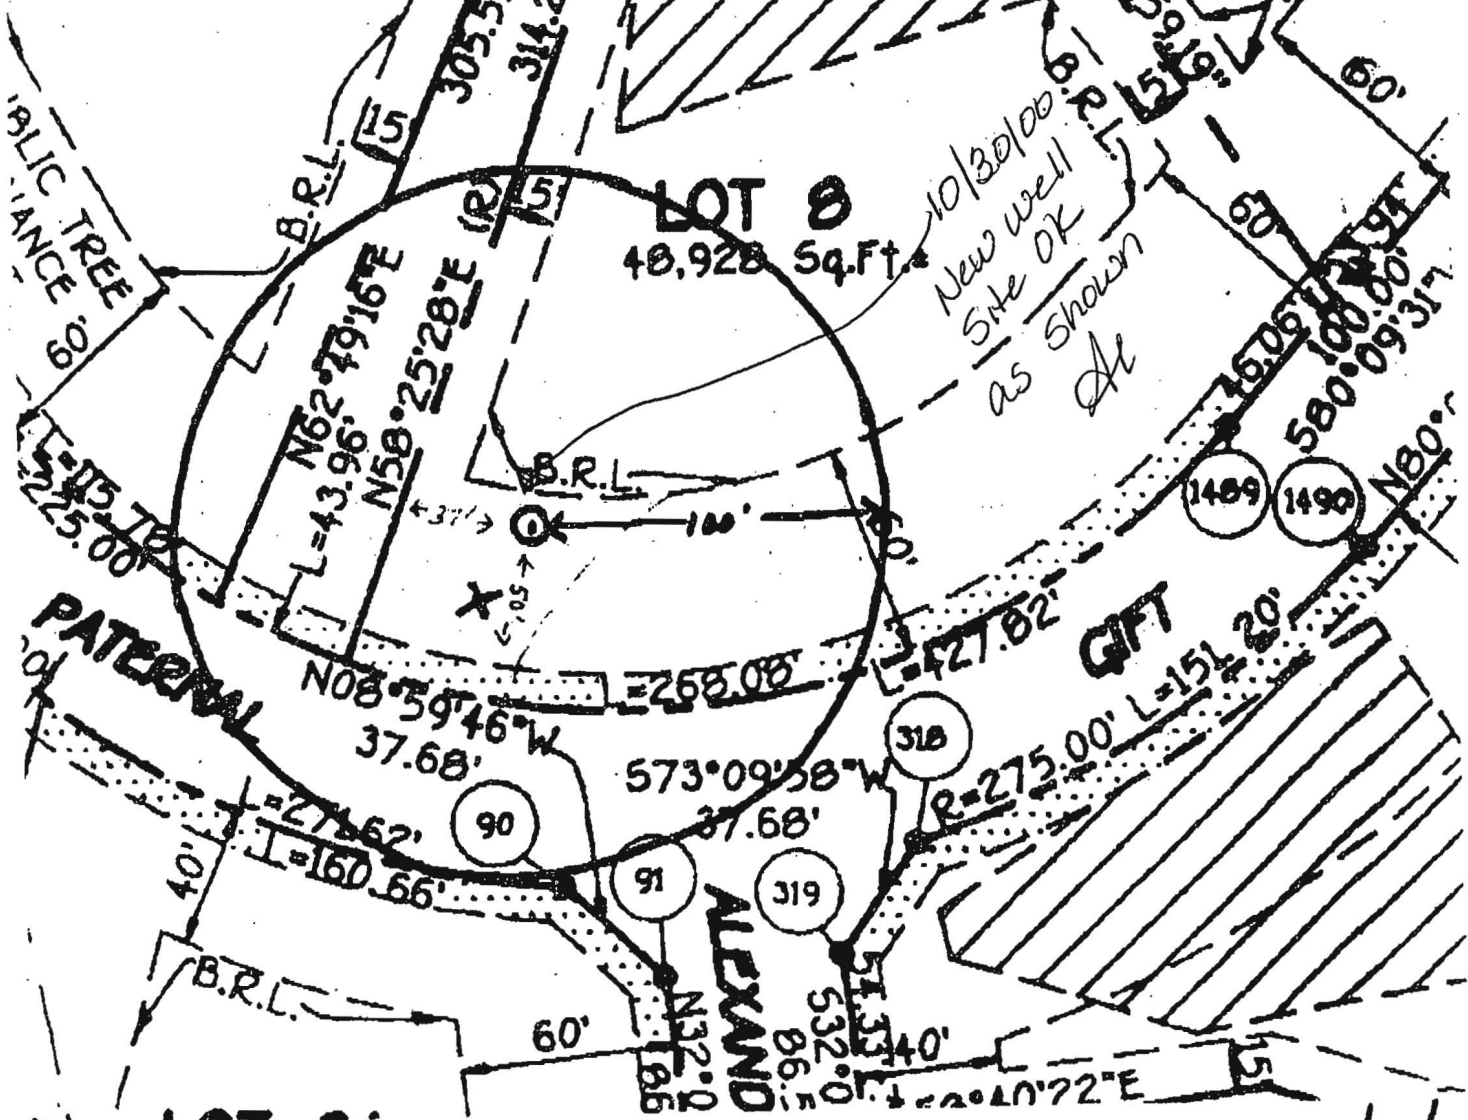

Scale 1" = 50'

Lot 8

Final Plan

New Site 10/27/00