

RECORDED

# APPLICATION

A 10906

SEWAGE DISPOSAL TESTING

P \_\_\_\_\_

MARYLAND STATE DEPARTMENT OF HEALTH

HOWARD COUNTY

ELLICOTT CITY

*Septic tank - 1,000 gal.*  
*Drywell - 520 sq. ft. absorbent, sidewalk area below the inlet pipe.*  
*Locate drywell 245 ft. from front lot line and 260 ft. from the left side line as lot is seen when facing it from Day Rd.*

DISTRICT 3

DATE 9/11/65

TO: THE COUNTY HEALTH OFFICER  
ELLICOTT CITY, MARYLAND

130  
520

I, HEREBY, APPLY FOR THE NECESSARY TESTS IN ORDER TO CONSTRUCT (OR RECONSTRUCT) A SEWAGE DISPOSAL SYSTEM.

PROPERTY OWNER Clarence Bagley

ADDRESS Day Rd., Sykesville, Maryland PHONE 480.4467

PROPERTY LOCATION:

SUBDIVISION \_\_\_\_\_ LOT NO. \_\_\_\_\_

ROAD AND DESCRIPTION Day Rd. - 3 miles from Rt. 40 North - 1 mile on left off Rt. 32 on Day Rd.

OCCUPANT \_\_\_\_\_ PHONE \_\_\_\_\_

PERSON TO CONSTRUCT SYSTEM \_\_\_\_\_

ADDRESS \_\_\_\_\_ PHONE \_\_\_\_\_

SIZE OF LOT 10 acres TYPE BLDG. 4 NUMBER OF BEDROOMS \_\_\_\_\_

IF NOT SINGLE RESIDENCE DESCRIBE \_\_\_\_\_

SIGNATURE OF APPLICANT Joan P. Bassler


APPROVED BY R.A. [Signature] FOR Drywell DATE 9/21/65  
(KIND OF SYSTEM)

REJECTED BY \_\_\_\_\_ FOR \_\_\_\_\_ DATE \_\_\_\_\_  
(KIND OF SYSTEM)

HOLD PENDING FURTHER TESTS \_\_\_\_\_ DATE \_\_\_\_\_

REASONS FOR REJECTION OR HOLDING \_\_\_\_\_

## THIS IS NOT A PERMIT

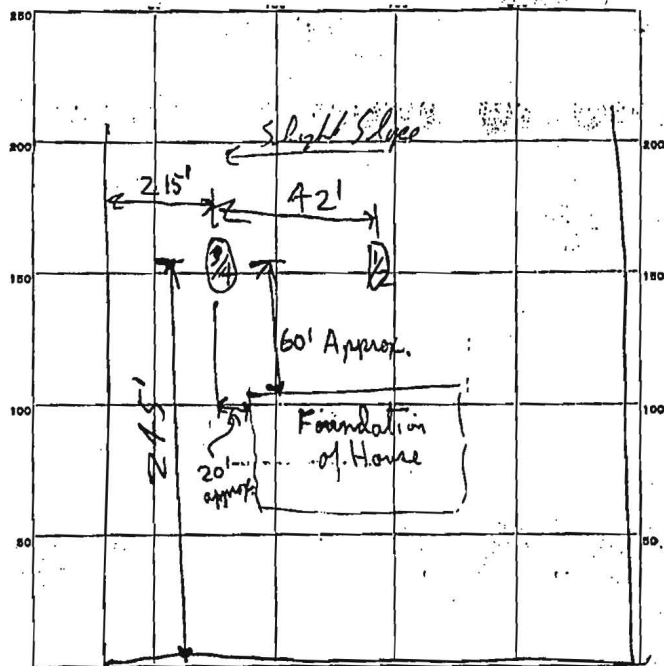

215  
48  
---  
167

To ←  
Rt. 32  
7/2 mile

Day Rt.

DATE	TEST NO.	DEPTH	PRE-WET		TEST - 1" DROP		TIME
			START	STOP	START	STOP	
9/2/65	1	9 ft	10:02	10:04	10:04	10:08	4 mins.
	2	5 ft	10:04	10:07	10:07	10:17	10 mins.
	3	9 ft	10:07	10:19	10:39	10:37	18 mins.
	4	5 ft	10:08	10:19	10:19	10:40	21 mins.

14  
39  
---  
453  
13 min

130  
---  
520

(2) 11.8

SOIL AUGER FINDING 1st 3 ft. clay in hole #2 - (1st 3/4 clay in hole #1)

TESTED BY R.P.F. 9/2/65

REMARKS Pre upper hole #1/2