

PRELIMINARY

# APPLICATION

A 26619

P \_\_\_\_\_

SEWAGE DISPOSAL TESTING

STATE OF MARYLAND - DEPARTMENT OF HEALTH AND MENTAL HYGIENE

HOWARD COUNTY HEALTH DEPARTMENT  
ENVIRONMENTAL HEALTH SERVICES  
P. O. BOX 476, ELLICOTT CITY, MARYLAND 21043  
TELEPHONE: 465-5000, EXT. 356

DISTRICT 5th

DATE 8/16/77

TO: THE COUNTY HEALTH OFFICER  
ELLICOTT CITY, MARYLAND

I, HEREBY, APPLY FOR THE NECESSARY TEST IN ORDER TO CONSTRUCT (OR RECONSTRUCT) A SEWAGE DISPOSAL SYSTEM.

PROPERTY OWNER William Mitchell Trinity Builders

ADDRESS \_\_\_\_\_ PHONE Paul Kottis 421-9433

PROPERTY LOCATION:

SUBDIVISION Dayton Meadows LOT NO. 2 ~~Block B~~

ROAD AND DESCRIPTION Green Bridge Road 13814 Dayton Meadows Court

SIZE OF LOT 40,000 sq. ft. TYPE BLDG. 3 or 4 bedrooms  
NUMBER OF BEDROOMS \_\_\_\_\_

IF NOT SINGLE RESIDENCE DESCRIBE \_\_\_\_\_

THE SYSTEM INSTALLED UNDER THIS APPLICATION IS ACCEPTABLE ONLY UNTIL PUBLIC FACILITIES BECOME AVAILABLE.

SIGNATURE OF APPLICANT /s/ Paul Kottis

APPROVED BY \_\_\_\_\_ FOR \_\_\_\_\_ DATE \_\_\_\_\_  
(KIND OF SYSTEM)


REJECTED BY \_\_\_\_\_ FOR \_\_\_\_\_ DATE \_\_\_\_\_  
(KIND OF SYSTEM)

HOLD PENDING FURTHER TESTS \_\_\_\_\_ DATE \_\_\_\_\_

REASONS FOR REJECTION OR HOLDING \_\_\_\_\_

BLDG. PERMIT SIGNED  
AND RETURNED 8/15/77  
Serial # 99716 - SFD  
4 Bedrooms

# THIS IS NOT A PERMIT

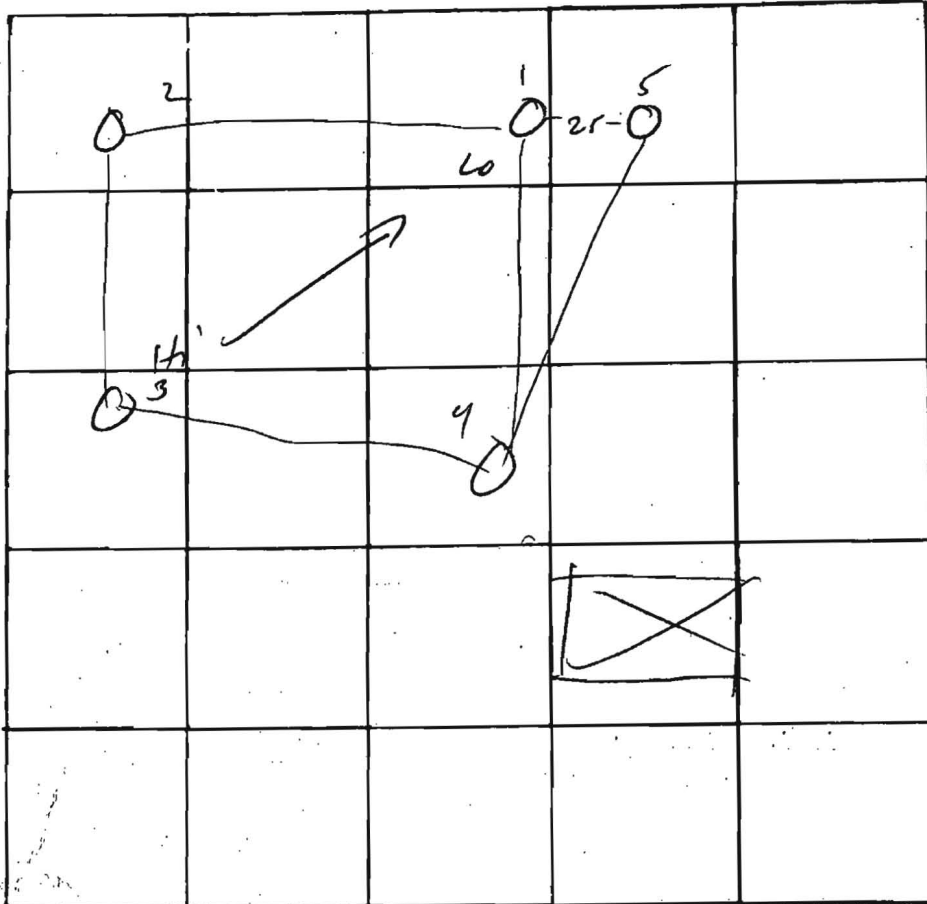

2B

①  
 0  
 1 day  
 5  
 1 sandy loam  
 14 1/2

INDICATE NORTH. - NAME ADJOINING ROADWAY AS BASE LINE

DATE	TEST NO.	DEPTH	PRE-WET		TEST - 1" DROP		TIME
			START	STOP	START	STOP	
23 Aug 70	1	4	3 <sup>17</sup>	3 <sup>28</sup>	3 <sup>28</sup>	—	>30
	1A	14 1/2	3 <sup>17</sup>	3 <sup>22</sup>	3 <sup>22</sup>	3 <sup>30</sup>	8
24 Aug	2	5	9 <sup>45</sup>	10 <sup>00</sup>	10 <sup>00</sup>	10 <sup>25</sup>	25
23 Aug	2A	14 1/2	3 <sup>24</sup>	3 <sup>28</sup>	3 <sup>28</sup>	3 <sup>37</sup>	9
	2B	4	3 <sup>25</sup>	15 min = 1/2"	—	—	>30
24 Aug	5B	5 1/2	9 <sup>45</sup>	10 <sup>02</sup>	10 <sup>02</sup>	10 <sup>30</sup>	28
	1B	5	9 <sup>53</sup>	9 <sup>58</sup>	9 <sup>58</sup>	10 <sup>03</sup>	6
	3	14	10 <sup>06</sup>	10"	10"	10 <sup>16</sup>	5
	3A	5	11 <sup>06</sup>	11 <sup>08</sup>	11 <sup>08</sup>	11 <sup>16</sup>	8
	4	14	vis	Same			

REMARKS \_\_\_\_\_  
 TYPE OF SOIL \_\_\_\_\_  
 TESTED BY M ALSO PRESENT: \_\_\_\_\_