

2-26-88
7-1-30
3/24/88

03-313719

567 Deer Hill
(North neighbor)
P 3/1/88

PERMIT

SEWAGE DISPOSAL SYSTEM

MARYLAND STATE DEPARTMENT OF HEALTH*

A 38966

DISTRICT 3rd

DATE 3/19/88

DATE SYSTEM APPROVED 3/24/88

INSPECTOR Carelli

HOWARD COUNTY
BUREAU OF ENVIRONMENTAL HEALTH
461-9933

INDEXED

Dale Fogle IS PERMITTED TO INSTALL ALTER

ADDRESS 6430 Woodbine Road, Woodbine, Maryland 21797 PHONE 795-5670

SUBDIVISION Bronk Property ROAD 567 Deer Hill Road LOT _____

PROPERTY OWNER Charles E. Bronk
567 Deer Hill Road

ADDRESS _____

IF GARBAGE GRINDER IS USED INCREASE SEPTIC TANK CAPACITY BY 50% AND ABSORPTION AREA BY 22%.

GARBAGE GRINDER? YES _____ NO

SEPTIC TANK CAPACITY 1000 GALLONS NUMBER OF BEDROOMS 3

180
3
540

TRENCHES - 180 sq. ft. per bedroom. Trench to be 3 feet wide. Inlet 2 feet below original grade. Bottom maximum depth 3 1/2 feet below original grade. effective area begins at 2 feet below original grade. 1 1/2 feet of stone below distribution pipe

LOCATION - Start the first trench 240 feet from the front (125') lot line and 75 feet from the left (410.9') lot line as seen when facing the property from Deer Hill Road. Run trench(s) along contour toward left lot line.

NOTE - No trench to exceed 100 feet in length. Provide 6" -8" diameter cleanout and cap to grade or above on septic tank. *de ft.*

PLANS APPROVED BY C. Williams DATE 6/02/87

COVER NO WORK UNTIL INSPECTED AND APPROVED.

NEITHER THE HOWARD COUNTY COUNCIL NOR THE HEALTH DEPARTMENT IS RESPONSIBLE FOR THE SUCCESSFUL OPERATION OF ANY SYSTEM.

NOTE: CLEANOUT REQUIRED EVERY 70 FEET OF SEWER LINE AND/OR AT 90° SWEEPS IN LINES FROM HOUSE TO DRAIN FIELDS.

NOTE: ALL PARTS OF SEPTIC SYSTEMS (I.E., TANK, DISTRIBUTION BOX, TRENCHES) TO BE 100 FEET FROM WELL. (UNLESS OTHERWISE SPECIFICALLY AUTHORIZED)

NOTE: IF DEEP TRENCHES ARE USED CALL FOR INSPECTION BEFORE AND AFTER PLACING GRAVEL IN TRENCHES).

NOTE: NO DRY WELL SHALL EXCEED 15 FOOT IN DIAMETER. NO ABSORPTION TRENCH TO EXCEED 100 FEET IN LENGTH.

NOTE: ALL PIPE FROM HOUSE TO SEPTIC TANK MUST BE CAST IRON OR SCHEDULE 40 PVC OR ABS.

PERMIT VOID AFTER TWO YEARS.

NOTE: INSTALL STAND PIPE ON SEPTIC TANK AND DRY WELL. STAND PIPES MUST BE 6 INCHES IN DIAMETER. CAST IRON, CONCRETE OR TERRA COTTA OR PVC OR ABS ACCEPTED. IF TOP OF SEPTIC TANK IS DEEPER THAN 3 FEET, MANHOLE TO GRADE REQUIRED.


NOTE: DISTRIBUTION BOXES MUST HAVE BAFFLES.

***INSTALLER IS RESPONSIBLE FOR OBTAINING FINAL APPROVAL ON THIS PERMIT**

*CALL 461-9933 FOR INSPECTION OF SEPTIC SYSTEMS.

EH - 2-1186

A 38966

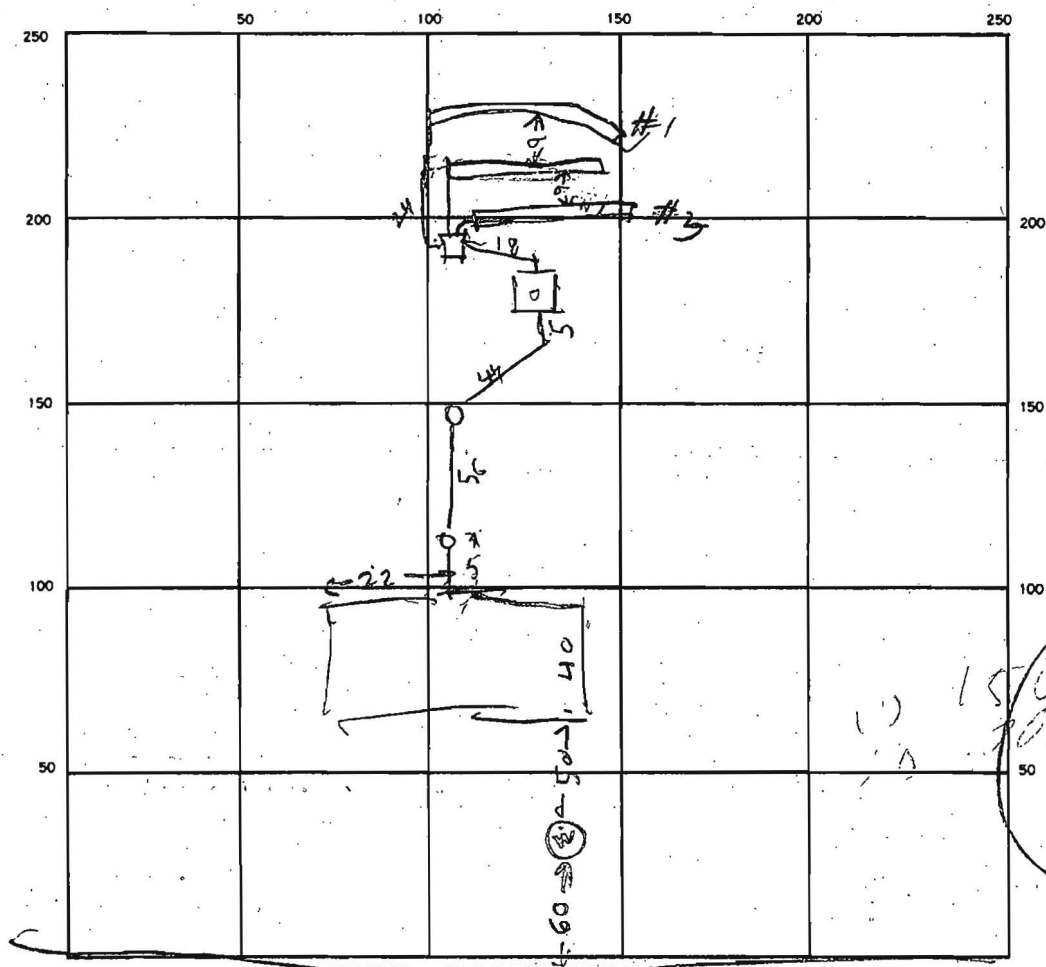

OK TO WORK
3/24/88
CHECK FOR
PERMITS

INDICATE NORTH NAME ADJOINING ROADWAY AS BASE LINE
DEER HILL RD

SEPTIC TANK LEVEL 01250

CLEANOUTS ST HOUSE SEWER
OK / OK ✓

DISTRIBUTION BOX LEVEL _____

DRAIN FIELD/TILE FIELD DEPTH 1 2 3
4 3.5 3.5 TRENCH WIDTH 1 2 3
3 3 3 FT. INLET DEPTH 2 FT.

EFFECTIVE GRAVEL DEPTH 1.5 1.5 FT. TOTAL LENGTH 60 60 60 FT.

NUMBER OF TRENCHES 3 ONE SIDEWALL/BOTTOM AREA 180 SQ. FT.

DRYWELL INSIDE DIAMETER _____ FT. EFFECTIVE DEPTH BELOW INLET _____ FT.

ABSORBENT AREA _____ SQ. FT.

REMARKS 2/26/88 AM - LOCATION OK TRENCH #1 OK. FINISH TRENCH #1 & #2 R/A
2/26/88 AM - TRENCH #1 & #2 DUG R/A
2/26/88 3:22 PM - CALL FOR HOUSE HOOK UP INSPECTION
WHEN READY COVER OUTSIDE WORK R/A
3/24/88 HOUSE CONNECTION OK, CW

DATE SYSTEM APPROVED 3/29/88

INSPECTOR CW