

C1 4170

SEQUENCE NO. (MDE USE ONLY)

STATE OF MARYLAND WELL COMPLETION REPORT

THIS REPORT MUST BE SUBMITTED AFTER WELL IS COMPLETED.

COUNTY NUMBER A58095CC

ST/CO USE ONLY DATE RECEIVED

DATE WELL COMPLETED

Depth of Well

PERMIT NO. FROM "PERMIT TO DRILL WELL"

OWNER BMB last name Bucks Run Drive first name TOWN Greenwood SUBDIVISION Wellington West SECTION TT LOT 31

WELL LOG table with columns: DESCRIPTION, FEET (FROM, TO), check if water bearing. Rows include Dirt, Soft Br. Mica & Clay, Blue Sandstone, Br. Sandstone.

GROUTING RECORD form with fields for CEMENT, BENTONITE CLAY, NO. OF BAGS, NO. OF POUNDS, GALLONS OF WATER, DEPTH OF GROUT SEAL.

CASING RECORD form with fields for MAIN CASING TYPE, Nominal diameter, Total depth, OTHER CASING.

SCREEN RECORD form with fields for screen type or open hole, insert appropriate code below.

DEPTH (nearest ft.) form with fields for diameter, depth from, to.

SLOT SIZE, DIAMETER OR SCREEN form with fields for slot size, diameter or screen.

PUMPING TEST form with fields for HOURS PUMPED, PUMPING RATE, METHOD USED TO MEASURE PUMPING RATE, WATER LEVEL.

PUMP INSTALLED form with fields for DRILLER INSTALLED PUMP, TYPE OF PUMP INSTALLED PLACE, CAPACITY, PUMP HORSE POWER.

WELL HYDROFRACTURED form with fields for YES/NO, CIRCLE APPROPRIATE LETTER.


I HEREBY CERTIFY THAT THIS WELL HAS BEEN CONSTRUCTED IN ACCORDANCE WITH COMAR 26.04.04.

DRILLERS LIC. NO. MWD 256 Dana Kyker Jr II DRILLERS SIGNATURE

LIC. NO. MWD 256 Dana Kyker Jr II SITE SUPERVISOR

GRAVEL RACK IF WELL DRILLED WAS FLOWING WELL INSERT F IN BOX 68 MDE USE ONLY (NOT TO BE FILLED IN BY DRILLER)

TELESCOPE CASING, LOG INDICATOR, OTHER DATA form.

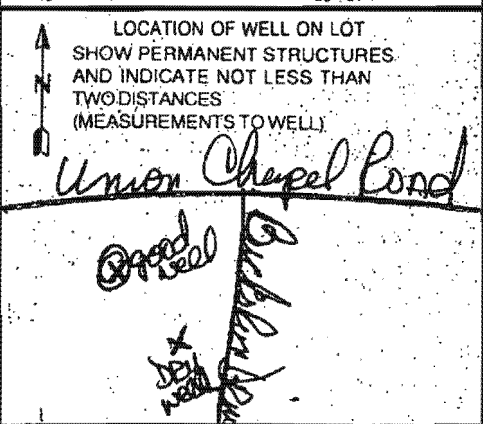

B 1	2088	SEQUENCE NO. (MDE USE ONLY)	STATE OF MARYLAND PERMIT TO DRILL WELL please print or type	STATE PERMIT NUMBER HO-94-1673
------------	-------------	--------------------------------	---	--

OWNER INFORMATION

Date Received (APA) **07 23 98**
8 MM DD YY 13

ASSOCIATES **BPM B**
15 Last Name Owner First Name 34

15298 Union Chapel Road
36 Street or RFD 55

Woodbine Md 21797
57 Town 70 State 72 Zip 76

LOCATION OF WELL

Howard
8 COUNTY 21

Wellington West
23 SUBDIVISION 42

SECTION **2** LOT **31**
44 46 48 50

Glennwood
52 NEAREST TOWN 71

MILES FROM TOWN (enter 0 if in town) **2** M I
73 76 77 78

DRILLER INFORMATION

DANA KYRKE JR II M D 256
Driller's Name 76 License No. 81

Westminster Rotary Well Drilling Inc
Firm Name

P.O. Box 861 Westminster, Md 21157
Address

Dana KyRke Jr II 7-22-98
Signature Date

DIRECTION OF WELL FROM TOWN (CIRCLE BOX)

Doe Hill Ct
~~Butter's Run St~~
11 NEAR WHAT ROAD 30

ON WHICH SIDE OF ROAD (CIRCLE APPROPRIATE BOX)

34 **550** 37 DISTANCE FROM ROAD
ENTER FT OR MI **FT** 38 39

TAX MAP: **14** BLK: _____ PARCEL **222**

WELL INFORMATION

APPROX. PUMPING RATE (GAL. PER MIN.) **5**
8 12

AVERAGE DAILY QUANTITY NEEDED (GAL. PER DAY) **340**
14 20

USE FOR WATER (CIRCLE APPROPRIATE BOX)

D DOMESTIC POTABLE SUPPLY & RESIDENTIAL IRRIGATION

F FARMING (LIVESTOCK WATERING & AGRICULTURAL IRRIGATION)

I INDUSTRIAL, COMMERCIAL, DEWATERING

P PUBLIC WATER SUPPLY WELL

T TEST, OBSERVATION, MONITORING

G GEO-THERMAL

NOT TO BE FILLED IN BY DRILLER HEALTH DEPARTMENT APPROVAL

Howard County A58095
COUNTY NAME COUNTY NO.

STATE SIGNATURE _____ INSERT S →

DATE ISSUED **08/06/98 A.M. Moore** **8/6/99**
43 MM DD YY 48 CO SIGNATURE EXP. DATE

NORTH GRID **530000** EAST GRID **790000**
50 55 57 63

APPROXIMATE DEPTH OF WELL **200** FEET
24 28

APPROXIMATE DIAMETER OF WELL **6** NEAREST INCH

SHOW MAJOR FEATURES OF BOX & LOCATE WELL WITH AN X → **Sketch 9/10**

SOURCES OF DRILLING WATER
1. **CITY**
2.
3.

WRITE THE BOX NUMBER FROM THE MAP HERE

E **790**
N **530**

000
000

No insp de XWELL

METHOD OF DRILLING (circle one)

BORED (or Augered) **JETTED** Jetted & DRIVEN

30 AIR-ROTARY **AIR-PERCussion** ROTARY (Hydraulic Rotary)

37 CABLE **REVERSE-ROTARY** DRIVE-POINT

other _____

REPLACEMENT OR DEEPEMED WELLS (CIRCLE APPROPRIATE BOX)

N THIS WELL WILL NOT REPLACE AN EXISTING WELL

Y THIS WELL WILL REPLACE A WELL THAT WILL BE ABANDONED AND SEALED

39 **S** THIS WELL WILL REPLACE A WELL THAT WILL BE USED AS A STANDBY-CONTACT LOCAL APPROVING AUTHORITY FOR POLICY ON STANDBY WELLS

D THIS WELL WILL DEEPEAN AN EXISTING WELL

PERMIT NUMBER OF WELL TO BE REPLACED OR DEEPEMED (IF AVAILABLE) 41 _____ 52

DRAW A SKETCH BELOW SHOWING LOCATION OF WELL IN RELATION TO NEARBY TOWNS AND ROADS AND GIVE DISTANCE FROM WELL TO NEAREST ROAD JUNCTION

Union Chapel Rd

Bulls Run Rd

XWELL

N ↑

Not to be filled in by driller (MDE OR COUNTY USE ONLY)

APPROP. PERMIT NUMBER _____ G A P _____

54 63

PERMIT No. **HO-94-1673**
70 71 72 73 74 75 76 77 78 79

SPECIAL CONDITIONS

NOTE - APPROVING AUTHORITIES SHOULD USE SEPARATE SHEET IF NEEDED

MARYLAND DEPARTMENT OF THE ENVIRONMENT, WATER MANAGEMENT ADMINISTRATION
 2500 BROENING HIGHWAY, BALTIMORE, MARYLAND 21224; (410) 631-3784

 WATER WELL ABANDONMENT-SEALING REPORT FORM

SUBMIT COPIES OF COMPLETED FORM TO:

- * COUNTY ENVIRONMENT AGENCY (contact MDE, WMA if address needed)
- * WELL OWNER
- * MDE, WATER MANAGEMENT ADMINISTRATION, WELL PROGRAM

DATE WELL ABANDONED: September 14, 1998 (month/day/year)

* PERMIT NUMBER OF ABANDONED WELL (if any)

HO — 94 — 1673

* PERMIT NUMBER OF REPLACEMENT WELL

* PERSON ABANDONING WELL: Dana Kyker, Jr., II

WELL DRILLERS LICENSE NUMBER: MWD256

CIRCLE: MWD/MSD/MGD

* OWNER'S NAME: BPMB ASSOC.

* WELL LOCATION:

COUNTY: Howard
 NEAREST TOWN: Glenwood
 TAX MAP 14 BLOCK PARCEL 222
 SUBDIVISION: Wellington West
 SECTION: II LOT: 31
 NEAREST ROAD: Bucks Run Drive

Dry Well #1
 MARYLAND GRID COORDINATES

BOX NUMBER E 790
 N 530

000	000
000	

SHOW WELL LOCATION BY X WITHIN BOX

* TYPE OF WELL BEING ABANDONED:

- DRILLED
- BORED/AUGURED
- OTHER (specify) _____
- JETTED
- HAND DUG

* USE CODE:

- DOMESTIC
- IRRIGATION
- TEST/OBSERVATION
- MUNICIPAL/PUBLIC
- INDUSTRIAL

* TYPE OF CASING:

- STEEL
- CONCRETE
- PLASTIC
- OTHER (specify) _____
- NONE

* SIZE OF CASING: n/a INCHES IN DIAMETER

* DEPTH OF WELL: 227 FEET DEEP

* WAS ANY CASING REMOVED? YES NO
 if yes, length removed, in feet: _____

* WAS CASING RIPPED OR PERFORATED? YES NO

LOG OF SEALING MATERIAL

MATERIAL	FEET	
	FROM	TO
Cement (1128 lbs)	0	33
Well Cuttings	33	227

SIGNATURE - MASTER WELL DRILLER OR SUPERVISING SANITARIAN: Dana Kyker, Jr., II

LICENSE # MWD256

CIRCLE ONE MWD/MSD/MGD

DATE 9-14-98

VEHICULAR INGRESS AND EGRESS RESTRICTED

DOE HILL CT
(PUBLIC STREET - 40' R/W)

#5318
545.75'
LOT 29
140,819 S.F.

#5301
540.70'
LOT 26
46,330 S.F.
#5300
538.44'

LOT 30
41,988 S.F.

LOT 31
41,722 S.F.

LOT 27
49,491 S.F.

LOT 25
44,526 S.F.

LOT 22
141,013 S.F.

LOT 24
43,089 S.F.

LOT 23
47,482 S.F.


LOT 1
42,255 S.F.

LOT 21
41,601 S.F.

LOT 20
530,48,702

Proposed new well location
9-9-98
OK as shown in plan
Surveyor will stake site and
then another inspection will be performed
8/16/98
Well site OK
as stated
9/10/98
Well site OK as
staked KM
E 11,287'
N 591,150'

4/11/98
Well site OK
KM

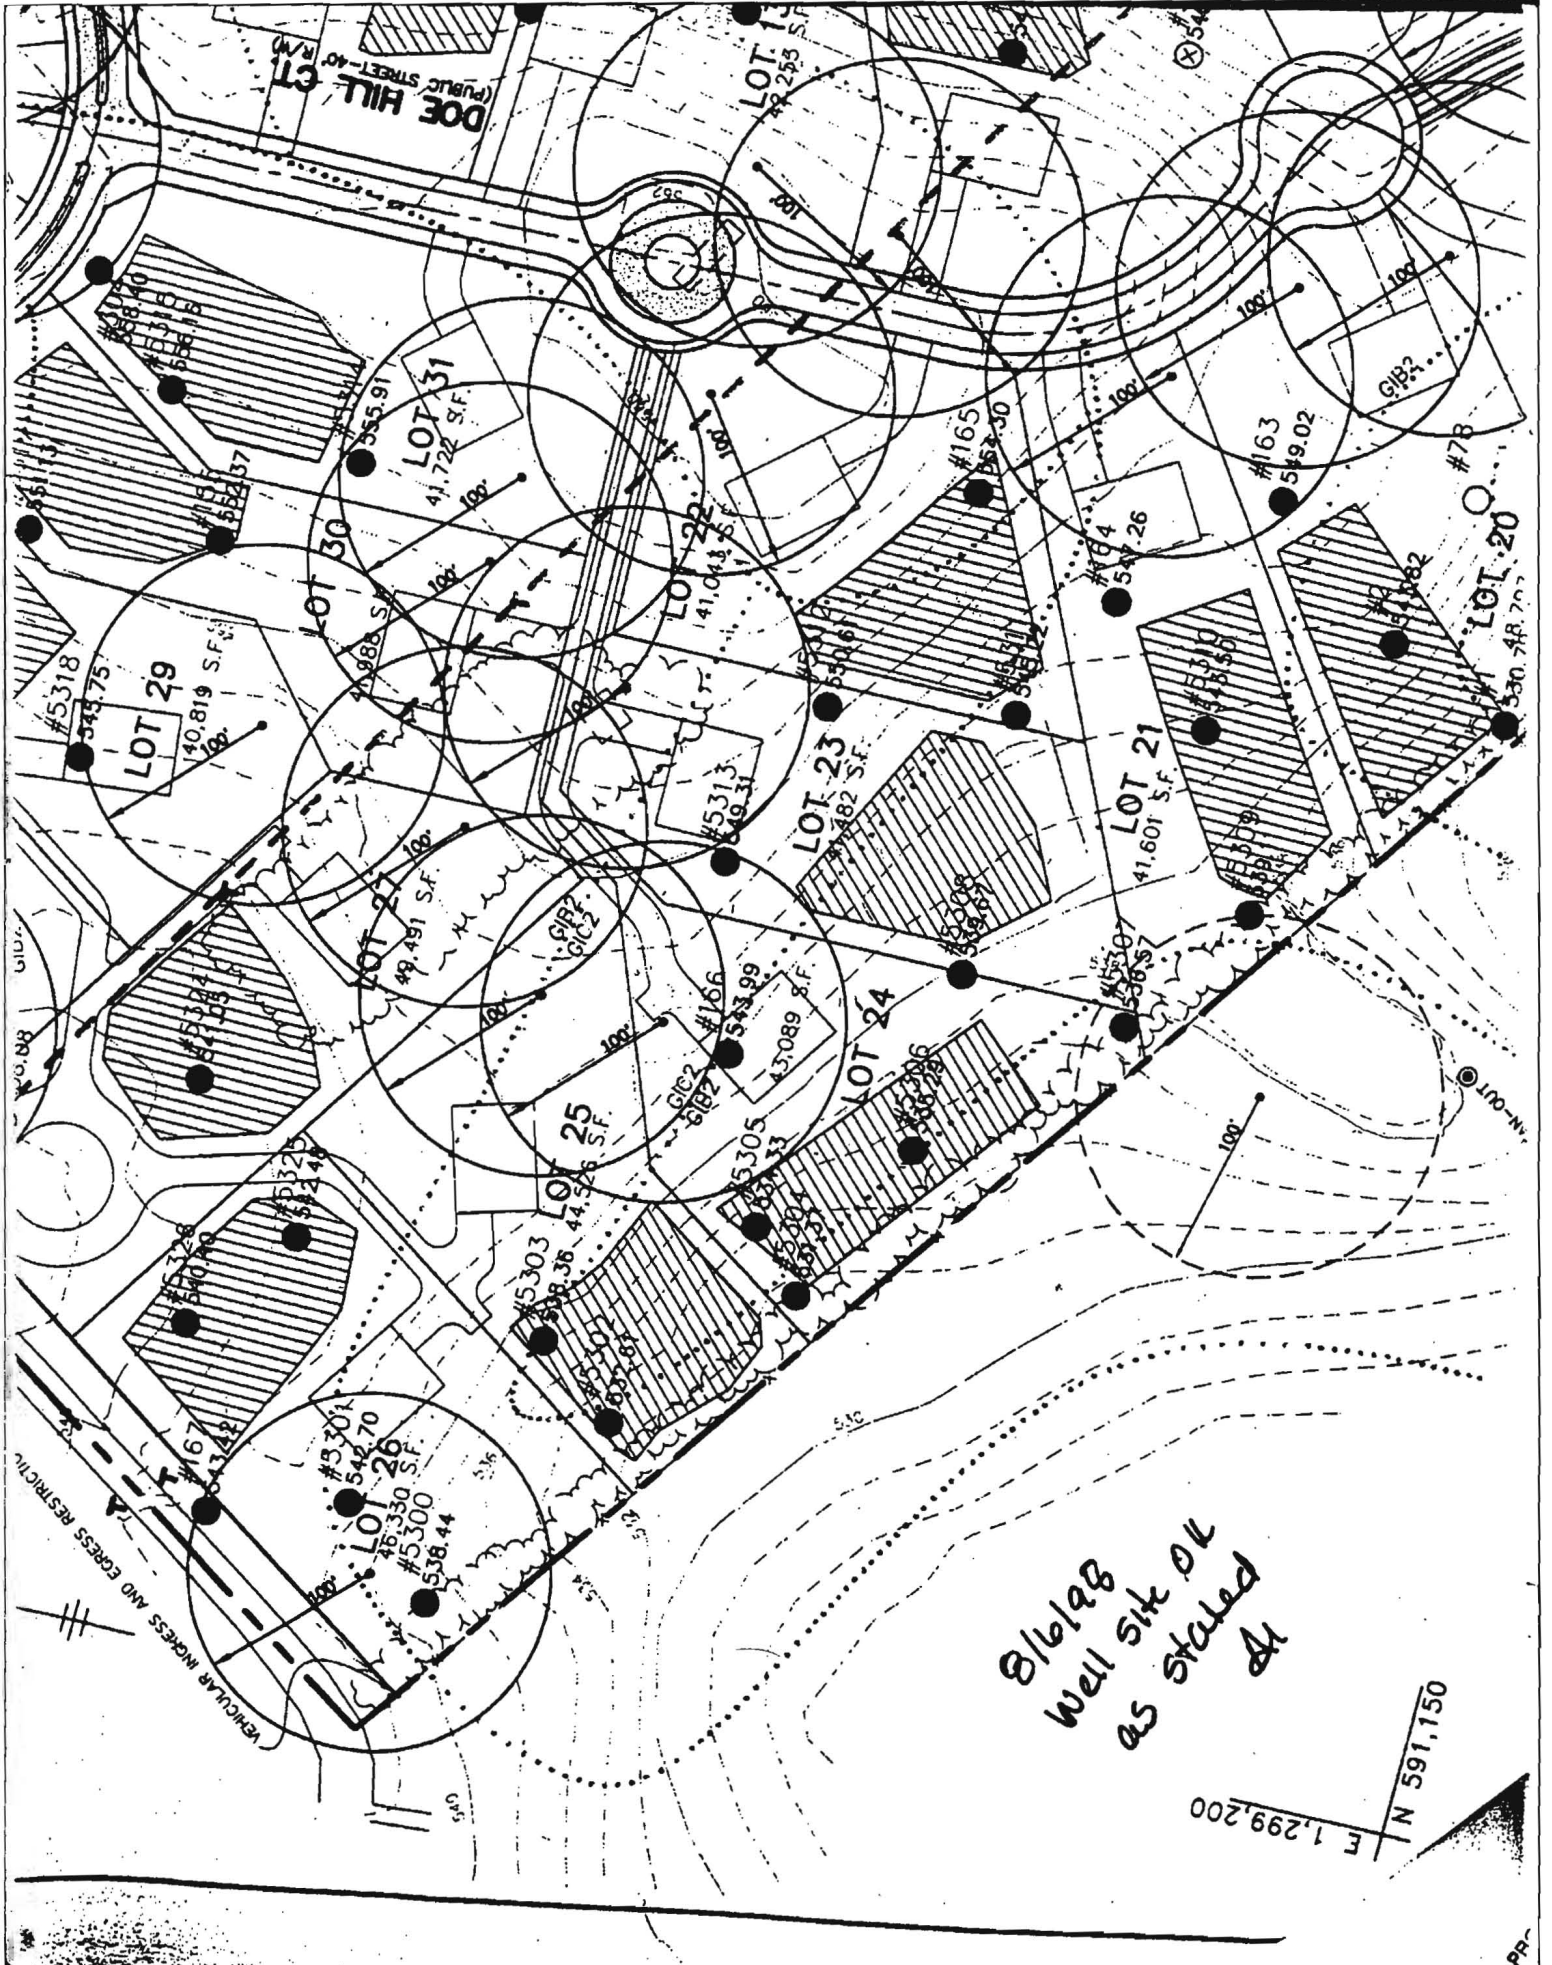

8/16/98
 Well site OK
 as stated in

N 591,150
 E 1,299,200