

5/10/00
2:00

#362594
INDEXED

PERMIT

SEWAGE DISPOSAL SYSTEM

HOWARD COUNTY HEALTH DEPARTMENT
BUREAU OF ENVIRONMENTAL HEALTH
410-313-2640

P 513 299

A 58095-CC

ISSUE DATE 3/2/2000

APPROVAL DATE 5/10/00

Fogle's Septic Clean, Inc.

IS PERMITTED TO INSTALL X ALTER

ADDRESS 580 Obrecht Road, Sykesville, MD 21784

PHONE 410-795-5670

SUBDIVISION Wellington West II LOT NUMBER 31 ADDRESS 15308 Doe Hill Court

PROPERTY OWNER Pulte Home Corp. PROPERTY OWNER'S ADDRESS 1501 S. Edgewood Street

Baltimore, MD 21227

SEPTIC TANK CAPACITY 1250 GALLONS

PUMP CHAMBER CAPACITY _____ GALLONS

NUMBER OF BEDROOMS 4

SQUARE FEET PER BEDROOM 180

LINEAR FEET OF TRENCH REQUIRED 240

TRENCHES: Trenches to be 3 feet wide. Inlet 3 feet below original grade. Bottom maximum depth
5 feet below original grade. 2 feet of stone below distribution box.

LOCATION: Place the distribution box 100 feet from the right lot line and 80 feet from the rear lot line. Run trenches along contour in both directions.

PLANS APPROVED Craig Williams *ck/cw*

DATE 2-3-2000

PERMIT VOID AFTER 2 YEARS

NOTE: CONTRACTOR RESPONSIBLE FOR SCHEDULING A PRE-CONSTRUCTION INSPECTION FOR ALL INSTALLATIONS

NOTE: TOP OF SEPTIC TANKS ARE TO BE NO DEEPER THAN 3.0 FEET BELOW FINISH GRADE

BLVD PERMITS ~~ISSUED~~
AND RETURNED 3/7/01
Dick

NOTE: WATERTIGHT SEPTIC TANKS REQUIRED

NOTE: CLEANOUT REQUIRED EVERY 70 FEET OF SEWER LINE AND/OR AT 90° SWEEPS IN LINES FROM HOUSE TO DRAIN FIELDS, 90° ELBOWS ARE NOT ACCEPTABLE

NOTE: ALL PARTS OF SEPTIC SYSTEMS (I.E. TANK, DISTRIBUTION BOX, DRAINFIELDS) TO BE 100 FEET FROM ANY WATER WELL UNLESS OTHERWISE SPECIFICALLY AUTHORIZED

NOTE: NO ABSORPTION TRENCH TO EXCEED 100 FEET IN LENGTH UNLESS SPECIFICALLY AUTHORIZED

NOTE: ALL PIPE FROM HOUSE TO SEPTIC TANK MUST BE CAST IRON OR SCHEDULE 35/40 PVC OR ABS

NOTE: MANHOLE RISERS REQUIRED ON ALL SEPTIC TANKS AND PUMP CHAMBERS

NOTE: DISTRIBUTION BOXES MUST HAVE BAFFLES


NOTE: IF PUMPED SEPTIC SYSTEM REQUIRED, (1) SEPTIC PUMP DETAIL TO BE PROVIDED BY INSTALLER PRIOR TO ISSUANCE OF SEPTIC PERMIT (2) PUMP PERFORMANCE TEST IS NECESSARY PRIOR TO HEALTH DEPARTMENT APPROVAL OF SEPTIC PERMIT

NEITHER THE HOWARD COUNTY COUNCIL NOR THE HEALTH DEPARTMENT IS RESPONSIBLE FOR THE SUCCESSFUL OPERATION OF ANY SYSTEM
PERMITTEE RESPONSIBLE FOR OBTAINING FINAL APPROVAL ON THIS PERMIT
CALL 410-313-2640 FOR INSPECTION OF SEPTIC SYSTEM

58095 CC

Willingboro Ct 31
 15308 Doe Hill Ct
 (A 58095-CC)
 P 513299)

NOT TO SCALE

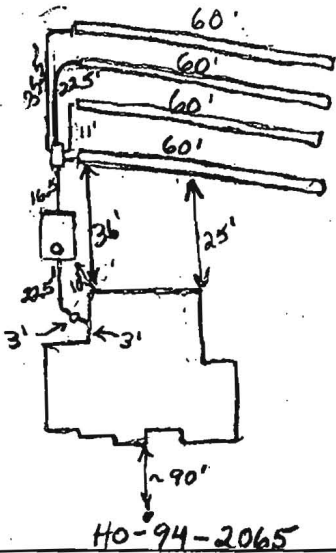

TRENCH DATA

TRENCH WIDTH 3.0
 TRENCH INLET DEPTH 3.0
 TRENCH BOTTOM DEPTH 5.0
 DEPTH OF STONE 2.0
 NUMBER OF TRENCHES 4 x 60'
 TOTAL TRENCH LENGTH 240'
 ABSORBENT AREA 720 sq ft.
 DISTRIBUTION BOX LEVEL OK
 BAFFLE IN DISTRIBUTION BOX Yes

SEPTIC TANK DATA

SEPTIC TANK 1250 MS GALLONS
 MANHOLE RISER Yes
 6 INCH INSPECTION PORT Yes

PUMP CHAMBER DATA

PUMP CHAMBER GALLONS /
 MANHOLE RISER /
 ALARM /
 PUMP PERFORMANCE TEST /

PRE-CONSTRUCTION INSPECTION: 2/24/00 - NO SITE COMPLICATIONS, WALKOUT PASSED.

OK TO PROCEED WITH INSTALLATION AS PER PLAN, (WELL IS FURTHER FROM HOUSE THAN PER BP PLAN) CW

INSPECTION COMMENTS: 5/8/00 House connection made, Tank set, 4" House clean out. Missed contractor for layout inspection. BB 5/10/00 O.K. to cover everything BB

5/24/00 WPI OK - 2 piece cap, PVC conduit, pitless 42" below grade.

OK to cover ALL

INSPECTOR B. Baker DATE SYSTEM APPROVED 5/10/00

