

# PERMIT

SEWAGE DISPOSAL SYSTEM  
HOWARD COUNTY HEALTH DEPARTMENT  
BUREAU OF ENVIRONMENTAL HEALTH  
410-313-2640

P 514678

A 58095-T

ISSUE DATE 11/29/2000

APPROVAL DATE 12/1/00

**INDEXED**

Fogles Septic Clean, Inc. IS PERMITTED TO INSTALL X ALTER

ADDRESS 580 Obrecht Road, Sykesville, MD 21784 PHONE 410-795-5670

SUBDIVISION Wellington West II LOT NUMBER 21 ADDRESS 15305 Doe Hill Court

PROPERTY OWNER Pulte Homes PROPERTY OWNER'S ADDRESS 1501 S Edgewood St, Ste K

SEPTIC TANK CAPACITY 1250 GALLONS **BUILDING PERMIT SIGNED**  
Baltimore, MD 21227

PUMP CHAMBER CAPACITY N/A GALLONS

NUMBER OF BEDROOMS 4

SQUARE FEET PER BEDROOM 180

LINEAR FEET OF TRENCH REQUIRED 240

**AND RETURNED**  
5-405 60015589-DECK

TRENCHES: Trenches to be 3 feet wide. Inlet 3 feet below original grade. Bottom maximum depth 5 feet below original grade. 2 feet of stone below distribution box.

LOCATION: Place the distribution box 160 feet down the left lot line and 90 feet off this same lot line. Run trenches on contour in ~~either~~ both directions

PLANS APPROVED Mark Rifkin ON SRK 11/2/00 DATE 9/18/2000

PERMIT VOID AFTER 2 YEARS

NOTE: CONTRACTOR RESPONSIBLE FOR SCHEDULING A PRE-CONSTRUCTION INSPECTION FOR ALL INSTALLATIONS

NOTE: TOP OF SEPTIC TANKS ARE TO BE NO DEEPER THAN 3.0 FEET BELOW FINISH GRADE

NOTE: WATERTIGHT SEPTIC TANKS REQUIRED

NOTE: CLEANOUT REQUIRED EVERY 70 FEET OF SEWER LINE AND/OR AT 90° SWEEPS IN LINES FROM HOUSE TO DRAIN FIELDS, 90° ELBOWS ARE NOT ACCEPTABLE

NOTE: ALL PARTS OF SEPTIC SYSTEMS (I.E. TANK, DISTRIBUTION BOX, DRAINFIELDS) TO BE 100 FEET FROM ANY WATER WELL UNLESS OTHERWISE SPECIFICALLY AUTHORIZED

NOTE: NO ABSORPTION TRENCH TO EXCEED 100 FEET IN LENGTH UNLESS SPECIFICALLY AUTHORIZED

NOTE: ALL PIPE FROM HOUSE TO SEPTIC TANK MUST BE CAST IRON OR SCHEDULE 35/40 PVC OR ABS

NOTE: MANHOLE RISERS REQUIRED ON ALL SEPTIC TANKS AND PUMP CHAMBERS

NOTE: DISTRIBUTION BOXES MUST HAVE BAFFLES

NOTE: IF PUMPED SEPTIC SYSTEM REQUIRED, (1) SEPTIC PUMP DETAIL TO BE PROVIDED BY INSTALLER PRIOR TO ISSUANCE OF SEPTIC PERMIT (2) PUMP PERFORMANCE TEST IS NECESSARY PRIOR TO HEALTH DEPARTMENT APPROVAL OF SEPTIC PERMIT


NEITHER THE HOWARD COUNTY COUNCIL NOR THE HEALTH DEPARTMENT IS RESPONSIBLE FOR THE SUCCESSFUL OPERATION OF ANY SYSTEM  
PERMITTEE RESPONSIBLE FOR OBTAINING FINAL APPROVAL ON THIS PERMIT  
CALL 410-313-2640 FOR INSPECTION OF SEPTIC SYSTEM

*11/30/00 layout  
12/1/00 Trenches P.M.*

*RPS# 362454*

514678

NOT TO SCALE

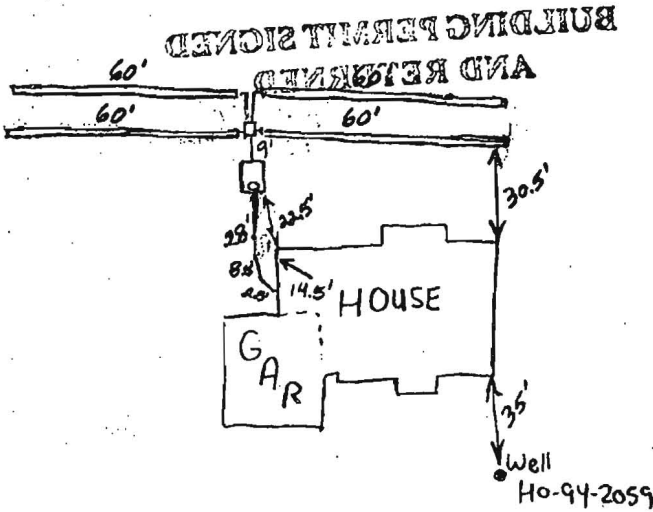

DOE HILL COURT

**TRENCH DATA**

TRENCH WIDTH 3  
 TRENCH INLET DEPTH 2  
 TRENCH BOTTOM DEPTH 5  
 DEPTH OF STONE 2  
 NUMBER OF TRENCHES 4  
 TOTAL TRENCH LENGTH 240'  
 ABSORBENT AREA 720 sq ft  
 DISTRIBUTION BOX LEVEL OK  
 BAFFLE IN DISTRIBUTION BOX Yes

**SEPTIC TANK DATA**

SEPTIC TANK 1250 T.S. GALLONS  
 MANHOLE RISER No  
 6 INCH INSPECTION PORT Yes

**PUMP CHAMBER DATA**

PUMP CHAMBER GALLONS N/A  
 MANHOLE RISER N/A  
 ALARM N/A  
 PUMP PERFORMANCE TEST N/A

PRE-CONSTRUCTION INSPECTION: 11/29/00-LAYOUT INSP. WAIVED (ALM) SRK

INSPECTION COMMENTS: 11/30/00-OK TO CONTINUE AND COVER MIDDLE OF TRENCHES, LEAVE ENDS OPEN, INSTRUCTED INSTALLER TO PLACE MANHOLE ON SEPTIC TANK (SRK)  
12/1/00 System satisfactory. O.K. to cover. (BB)

INSPECTOR B. Baber DATE SYSTEM APPROVED 12/1/00

Approved Septic System Plan  
 Howard County Health Department

F-98-180

EROSION CONTROL MATTING

Total linear feet of trench required 240 feet

Width of trench(es) 3 feet

Depth of trench(es) 5 feet

Depth of stone required below distribution pipe 2 feet

*Mark E. Pelkin* 9/18/00  
 Signature Date

