

B 1	1556	SEQUENCE NO. (MDE USE ONLY)	STATE OF MARYLAND APPLICATION FOR PERMIT TO DRILL WELL 535949 please type	STATE PERMIT NUMBER 140-95-2205 <small>fill in this form completely</small>
-----	------	--------------------------------	--	---

OWNER INFORMATION

Date Received (APA) 9 15 2011
8 MM DD YY 13

TALKIN Last Name LUKE First Name 34
Owner

8017 DORSEY RUN ROAD
3r Street or RFD 55

Jessup Town MARYLAND State 72 Zip 76

LOCATION OF WELL

HOWARD COUNTY 21

DORSEY INDUSTRIAL PARK SUBDIVISION 42

SECTION LOT
44 46 48 50

JESSUP NEAREST TOWN 71

MILES FROM TOWN (enter 0 if in town) 0 M I
73 76 77 78

DRILLER INFORMATION

SCOTT MILLER Driller's Name MS D 214 License No. 81

NORTHERN VIRGINIA DRILLING Firm Name

11356 INDUSTRIAL RD MANASSAS VA Address

Scott Miller Signature 9/15/11 Date

DIRECTION OF WELL FROM TOWN (CIRCLE BOX)

ON WHICH SIDE OF ROAD (CIRCLE APPROPRIATE BOX)

SHAREWOOD DRIVE NEAR WHAT ROAD 30

DISTANCE FROM ROAD 1600 FT 37
ENTER FT OR MI 38 39

TAX MAP: _____ BLK: _____ PARCEL _____

WELL INFORMATION

APPROX. PUMPING RATE (GAL. PER MIN.) 8 12

AVERAGE DAILY QUANTITY NEEDED (GAL. PER DAY) 14 20

USE FOR WATER (CIRCLE APPROPRIATE BOX)

D DOMESTIC POTABLE SUPPLY & RESIDENTIAL IRRIGATION

F FARMING (LIVESTOCK WATERING & AGRICULTURAL IRRIGATION)

I INDUSTRIAL, COMMERCIAL, DEWATERING

P PUBLIC WATER SUPPLY WELL

T TEST, OBSERVATION, MONITORING

G GEO-THERMAL - closed 4 e 350'

NOT TO BE FILLED IN BY DRILLER HEALTH DEPARTMENT APPROVAL

Howard COUNTY NAME (73) COUNTY NO.

STATE SIGNATURE _____ INSERT S →

DATE ISSUED 10/12/11 CO SIGNATURE [Signature] EXP. DATE 10/31/18

43 MM DD YY 48 55 57 63

NORTH GRID N/A 0 0 0 EAST GRID N/A 0 0 0

APPROXIMATE DEPTH OF WELL 350 FEET
24 28

APPROXIMATE DIAMETER OF WELL 6 INCH NEAREST INCH

METHOD OF DRILLING (circle one)

BORED (or Augered) JETTED Jetted & DRIVEN

AIR-ROTary AIR-Percussion ROTARY (Hydraulic Rotary)

CABLE REVerse-ROTary Drive-POINT

other _____

REPLACEMENT OR DEEPEMED WELLS (CIRCLE APPROPRIATE BOX)

N THIS WELL WILL NOT REPLACE AN EXISTING WELL

Y THIS WELL WILL REPLACE A WELL THAT WILL BE ABANDONED AND SEALED

S THIS WELL WILL REPLACE A WELL THAT WILL BE USED AS A STANDBY-CONTACT LOCAL APPROVING AUTHORITY FOR POLICY ON STANDBY WELLS

D THIS WELL WILL DEEPEM AN EXISTING WELL

PERMIT NUMBER OF WELL TO BE REPLACED OR DEEPEMED (IF AVAILABLE) 41 _____ 52

Not to be filled in by driller (MDE OR COUNTY USE ONLY)

APPROP. PERMIT NUMBER _____ G _____

PERMIT No. 140-95-2205
70 71 72 73 74 75 76 77 78 79

SHOW MAJOR FEATURES OF BOX & LOCATE WELL WITH AN X

SOURCES OF DRILLING WATER

- PUBLIC WATER
-
-

WRITE THE BOX NUMBER FROM THE MAP HERE

E 860
N 480

000
000

DRAW A SKETCH BELOW SHOWING LOCATION OF WELL IN RELATION TO NEARBY TOWNS AND ROADS AND GIVE DISTANCE FROM WELL TO NEAREST ROAD JUNCTION


SPECIAL CONDITIONS Public Utilities

NOTE - APPROVING AUTHORITIES SHOULD USE SEPARATE SHEET IF NEEDED

Grant from Bottom to top. COUNTY

GENERAL NOTES

1. THE BUILDING SHOWN HEREIN CONSISTS OF CONDOMINIUM UNITS MORE FULLY OUTLINED ON SHEET 2 OF 2 OF THIS CONDOMINIUM PLAT.
2. EACH CONDOMINIUM UNIT IS IDENTIFIED ON SHEET 2 OF 2 BY A NUMBER - UNIT (1-1) (1-2) (1-3) (2-1) (2-2) (2-3) (2-4) (2-5) (2-6) (2-7) (2-8).
3. A UNIT OR A CONDOMINIUM UNIT SHALL MEAN COMMERCIAL UNIT (COMMERCIAL UNIT MEANS AND INCLUDES THE THREE DIMENSIONAL AREAS, REFER TO THE DECLARATION FOR DORSEY RUN COMMERCE PARK CONDOMINIUM" RECORDED AMONG THE LAND RECORDS OF HOWARD COUNTY, MARYLAND IN LIBER _____ AT FOLIO _____ ON JANUARY 31, 2005.
4. COMMON ELEMENTS ARE COMPRISED OF ALL OF THE AREA AND THE FACILITIES WHICH ARE NOT A PART OF A "UNIT" OR THE "UNITED COMMON ELEMENTS".
5. THE COORDINATES SHOWN HEREON ARE BASED ON THE NAD 83/11 ESTABLISHED BY HOWARD COUNTY. THE ELEVATIONS SHOWN HEREON ARE BASED ON THE MANDOR ESTABLISHED BY HOWARD COUNTY. - SEE SHEET 3 OF 2 FOR UNIT ELEVATIONS.
6. TOTAL AREA OF THE BOUNDARY FOR DORSEY RUN COMMERCE PARK CONDOMINIUM IS 6.647 ACRES MORE OR LESS.
7. DORSEY RUN COMMERCE PARK CONDOMINIUM PREVIOUSLY RECORDED AMONG THE LAND RECORDS OF HOWARD COUNTY, MARYLAND ON FEBRUARY 23, 2005 AS PLAT NO. 17269-17270.

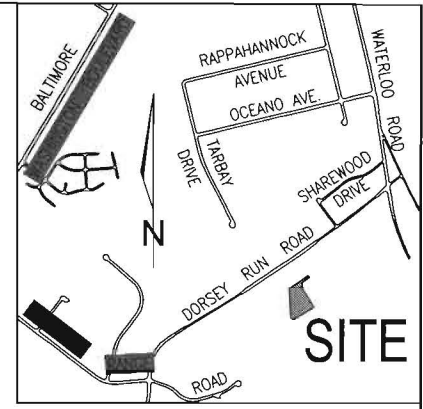

VICINITY MAP
1"=2000'

CONSENT OF TRUSTEES AND BENEFICIARY

RAYMOND E. SCHLUSLER and CHRISTOPHER M. NEWS, TRUSTEES (COLLECTIVELY, "TRUSTEES") FOR THE BENEFIT OF PROVIDENT BANK, WHO ARE, RESPECTIVELY, THE TRUSTEES AND THE BENEFICIARY UNDER THAT CERTAIN MORTGAGE DEED OF TRUST AND ASSIGNMENT OF LEASES AND RENTS (THE "DEED OF TRUST") DATED DECEMBER 9, 2003 AND RECORDED AMONG THE LAND RECORDS OF HOWARD COUNTY, MARYLAND IN LIBER 7930 AT FOLIO 130 ET SEQ. FROM DORSEY RUN ASSOCIATES LLC HEREBY JOIN IN RECORDED OF THE CONDOMINIUM PLAT ENTITLED "DORSEY RUN COMMERCE PARK CONDOMINIUM", CONSISTING OF 2 SHEETS, WHICH IS DATED JANUARY 31, 2005, AND PREPARED BY ROBERT H. VOGEL ENGINEERING, INC. AND INTENDED TO BE RECORDED AMONG THE LAND RECORDS OF HOWARD COUNTY, MARYLAND (THE "PLAT") FOR THE EXPRESS PURPOSE OF CONSENTING TO THE PLAT AND SUBORDINATING ALL OF THEIR RESPECTIVE RIGHT, TITLE AND INTEREST UNDER SUCH DEED OF TRUST IN AND TO THE REAL PROPERTY DESCRIBED THEREIN TO THE PLAT AND TO THE OPERATION AND EFFECT THEREOF, ALL AS IF THE MORTGAGE PLAT HAD BEEN EXECUTED AND DELIVERED AND RECORDED PRIOR TO THE EXECUTION, DELIVERY AND RECORDED OF THE DEED OF TRUST.

IN WITNESS WHEREOF, THE TRUSTEES AND BENEFICIARY HAVE EXECUTED AND SEALED THIS CONSENT, SUBORDINATION AND AGREEMENT OF TRUSTEES AND BENEFICIARY OR CAUSED IT TO BE EXECUTED AND SEALED ON ITS BEHALF BY ITS DULY AUTHORIZED REPRESENTATIVES.

THIS DAY OF _____, 2005.

WITNESS: _____ RAYMOND E. SCHLUSLER, TRUSTEE (1)

WITNESS: _____ CHRISTOPHER M. NEWS, TRUSTEE (2)

ATTEST: _____ BY: _____ TITLE
BENEFICIARY: PROVIDENT BANK

OWNER'S DEDICATION

DORSEY RUN ASSOCIATES, L.L.C., BY WILLIAM F. UTZ, MANAGER, OWNER OF THE PROPERTY SHOWN HEREON AND DESCRIBED IN THE SURVEYOR'S CERTIFICATE, HEREBY ADOPT THIS CONDOMINIUM PLAT.

TO THE BEST OF MY KNOWLEDGE, INFORMATION AND BELIEF THE REQUIREMENTS OF THE "MARYLAND CONDOMINIUM ACT", TITLE 11, SECTION 11-101 ET SEQ., REAL PROPERTY ARTICLE OF THE "ANNOTATED CODE OF MARYLAND" (AS AMENDED), AND THAT THIS PLAT, TOGETHER WITH APPLICABLE NOTICES OF THE DECLARATION, IS A CORRECT REPRESENTATION OF THE CONDOMINIUM DESCRIBED, AND THE IDENTIFICATION AND LOCATION OF EACH UNIT AND THE COMMON ELEMENTS AS CONSTRUCTED, CAN BE DETERMINED FROM THIS PLAT.


DORSEY RUN ASSOCIATES, L.L.C.

DATE _____ WILLIAM F. UTZ, MANAGER

SURVEYOR'S CERTIFICATION

I HEREBY CERTIFY TO THE BEST OF MY KNOWLEDGE, INFORMATION AND BELIEF: THAT THIS CONDOMINIUM PLAT, CONSISTING OF 2 SHEETS IS CORRECT; THAT IT IS IN ACCORDANCE WITH THE REQUIREMENTS OF TITLE 11, SECTION 101 ET SEQ., REAL PROPERTY ARTICLE OF THE "ANNOTATED CODE OF MARYLAND" (AS AMENDED); AND THAT THIS PLAT, TOGETHER WITH APPLICABLE NOTICES OF THE DECLARATION, IS A CORRECT REPRESENTATION OF THE CONDOMINIUM DESCRIBED, AND THE IDENTIFICATION AND LOCATION OF EACH UNIT AND THE COMMON ELEMENTS AS CONSTRUCTED, CAN BE DETERMINED FROM THIS PLAT.

DATE _____ MARK C. MARTIN
PROFESSIONAL LAND SURVEYOR
MARYLAND REG. NO. 10984

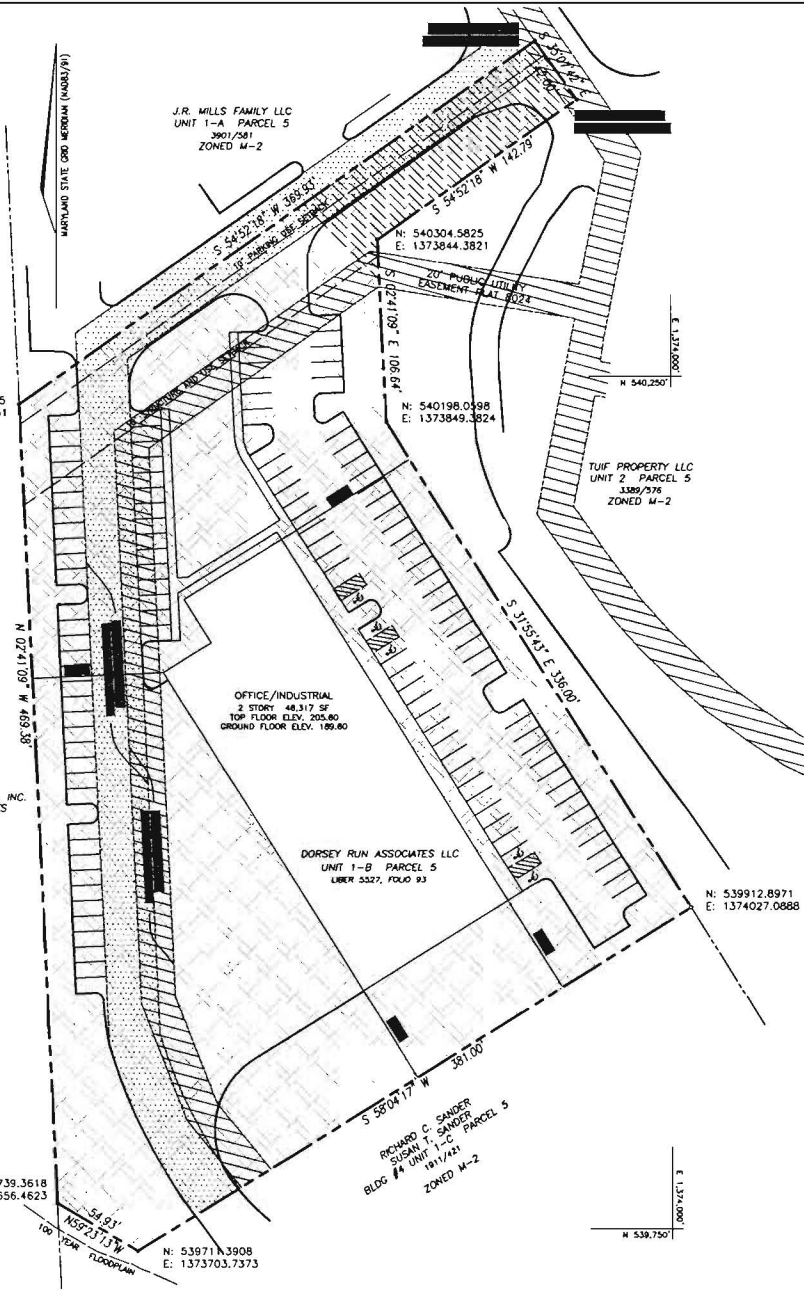

PREVIOUSLY RECORDED PLATS	
SUBDIVISION PLAT	8024
CONDOMINIUM PLAT	17269-17270

- = UNIT ELEMENT
- = GENERAL COMMON ELEMENT
- = 30' ACCESS EASEMENT PLAT #8024
- = 20' PUBLIC UTILITY EASEMENT

REV	DATE	REVISIONS

ROBERT H. VOGEL ENGINEERING, INC.
ENGINEERS · SURVEYORS · PLANNERS
8407 MAIN STREET
ELLCOTT CITY, MARYLAND 21043
TEL: 410.461.7666 FAX: 410.461.8961

REVISED PLAT OF CONDOMINIUM SUBDIVISION
FOR
**1ST SUPPLEMENTAL PLAT OF
DORSEY RUN COMMERCE PARK CONDOMINIUM**

DATE	MAY 31, 2005	DRAWING NO.	
SCALE	1" = 50'	SHEET	1 of 2
DESIGNED BY	M.C.M.	REV. JOB NUMBER	
DRAWN BY	B. ABBOTT		

K:\Projects\017086A\SUVA\CONDO_PLATS\REVISED\SH2E1.dwg

ADA compliant - provide fixtures & access. per HC WC & HC Lav elevs. III prtns. to be 1" baked enamel finished metal


Exist. One-Hour rated Tenant Demising Wall

Existing Adjacent Tenant


Open Storage

UP 25R No Work

Ptd. 1/2" gyp bd. bulkhd. 1" below SAT dip.

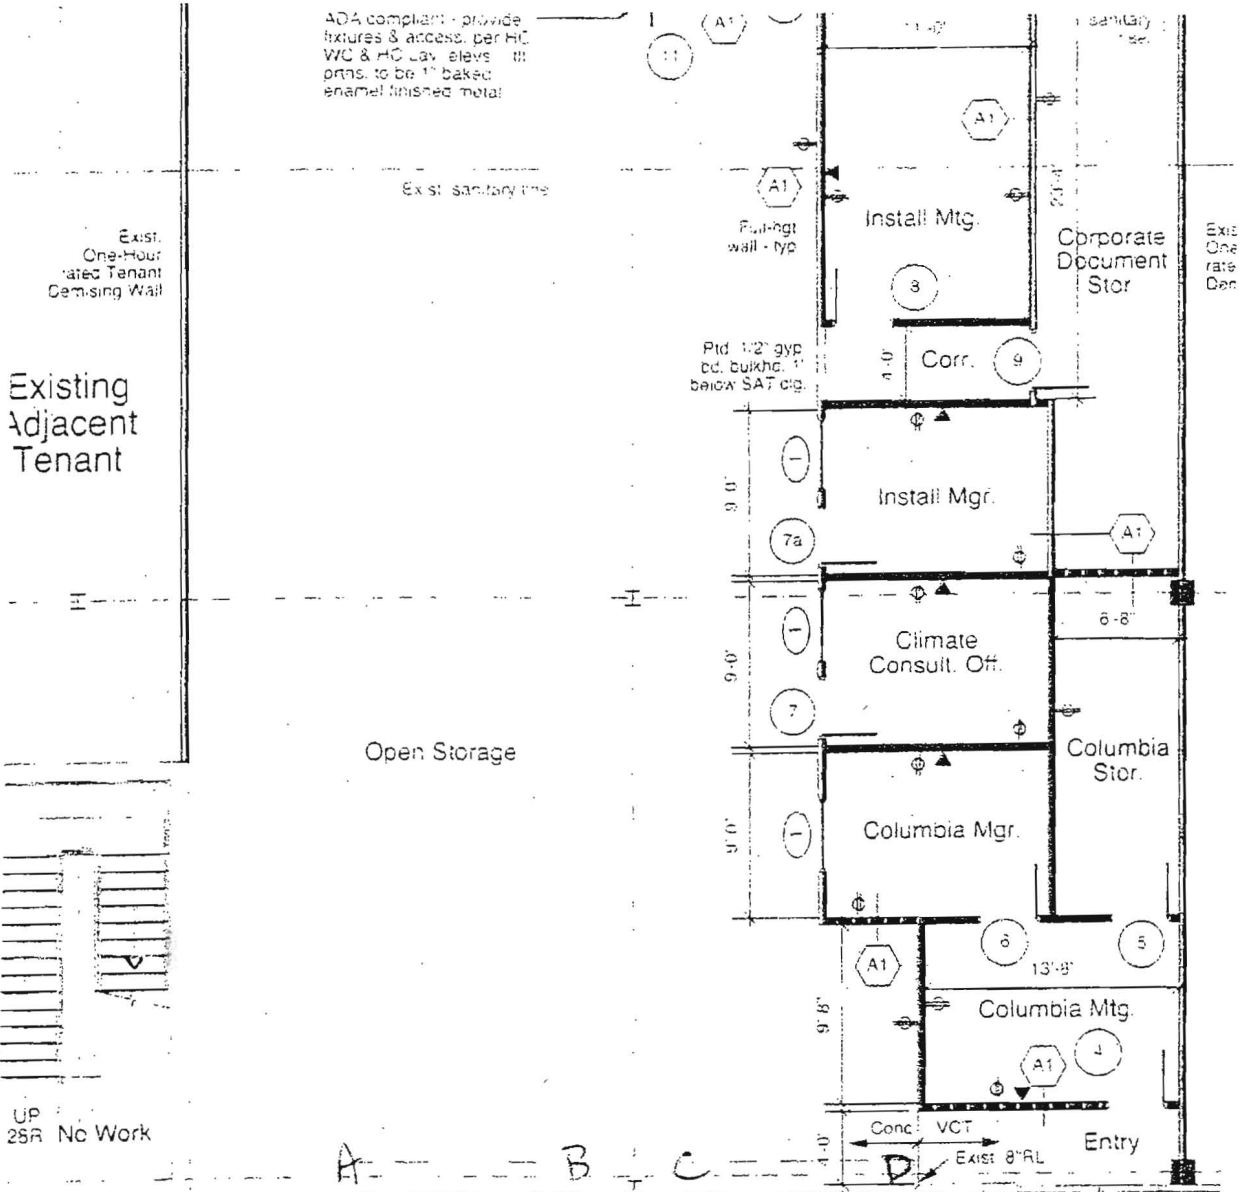

Geo boxes OK

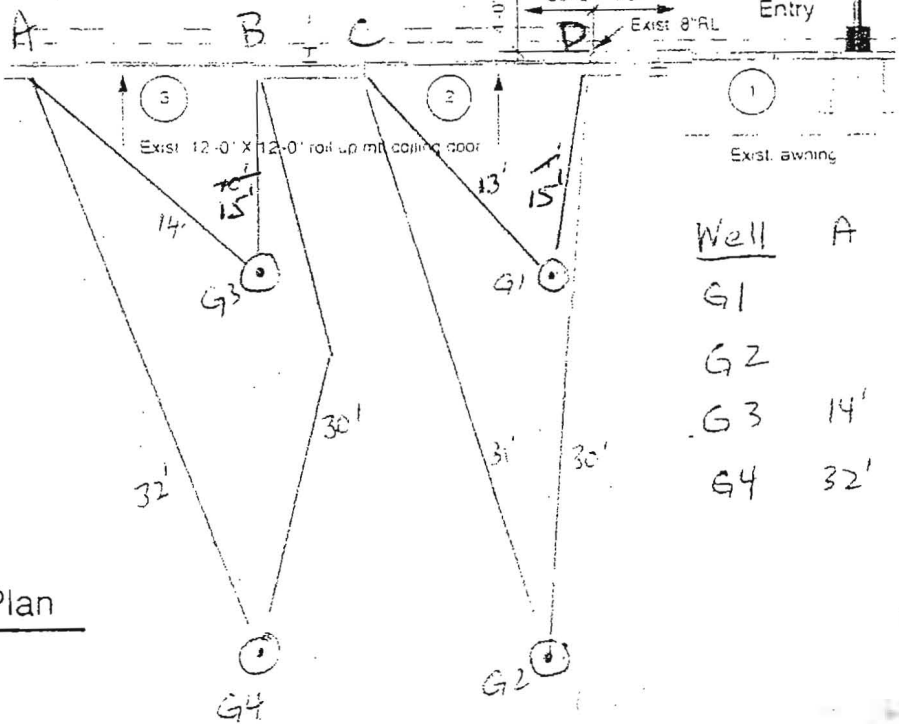

Well	A	B	C	D
G1			13'	11'
G2			31'	30'
G3	14'	10'		
G4	32'	30'		

1 Lower Floor Plan
 A1 Scale: 1/8" = 1'-0"

Notes:
 1. Provide FES as req'd