

# APPLICATION

A 08088

SEWAGE DISPOSAL TESTING

P \_\_\_\_\_

MARYLAND STATE DEPARTMENT OF HEALTH

HOWARD COUNTY 1506 gallon Tank

ELLICOTT CITY

Tile Field - 345 sq ft bottom area

DISTRICT 2

Place the tile field 125 ft to 190 ft from the front lot line and 90 ft to 170 ft from the white plank fence.

DATE 2/28/64

OR  
Dry Well - 300 sq ft sidewall area below the inlet. Place the dry well 145 ft to 165 ft from the front lot line and

TO: THE COUNTY HEALTH OFFICER  
ELLICOTT CITY, MARYLAND.

I, HEREBY, APPLY FOR THE NECESSARY TESTS IN ORDER TO CONSTRUCT (OR RECONSTRUCT) A SEWAGE DISPOSAL SYSTEM.

PROPERTY OWNER Eliza Seals & Willard Mathis

ADDRESS West Friendship, Maryland PHONE \_\_\_\_\_

PROPERTY LOCATION:

SUBDIVISION \_\_\_\_\_ LOT NO. Next to Nippard

ROAD AND DESCRIPTION Rt. 144 - between West Friendship fire house and Mr. Nippard  
This lot next to Nippard

OCCUPANT \_\_\_\_\_ PHONE \_\_\_\_\_

PERSON TO CONSTRUCT SYSTEM \_\_\_\_\_

ADDRESS \_\_\_\_\_ PHONE \_\_\_\_\_

SIZE OF LOT 1 acre TYPE BLDG. 3

NUMBER OF BEDROOMS

IF NOT SINGLE RESIDENCE DESCRIBE \_\_\_\_\_

SIGNATURE OF APPLICANT Willard Mathis


APPROVED BY Raymond Hodges FOR Tile Field or Dry Well DATE 3/12/64

REJECTED BY \_\_\_\_\_ FOR \_\_\_\_\_ DATE \_\_\_\_\_

HOLD PENDING FURTHER TESTS \_\_\_\_\_ DATE \_\_\_\_\_

REASONS FOR REJECTION OR HOLDING \_\_\_\_\_

# THIS IS NOT A PERMIT

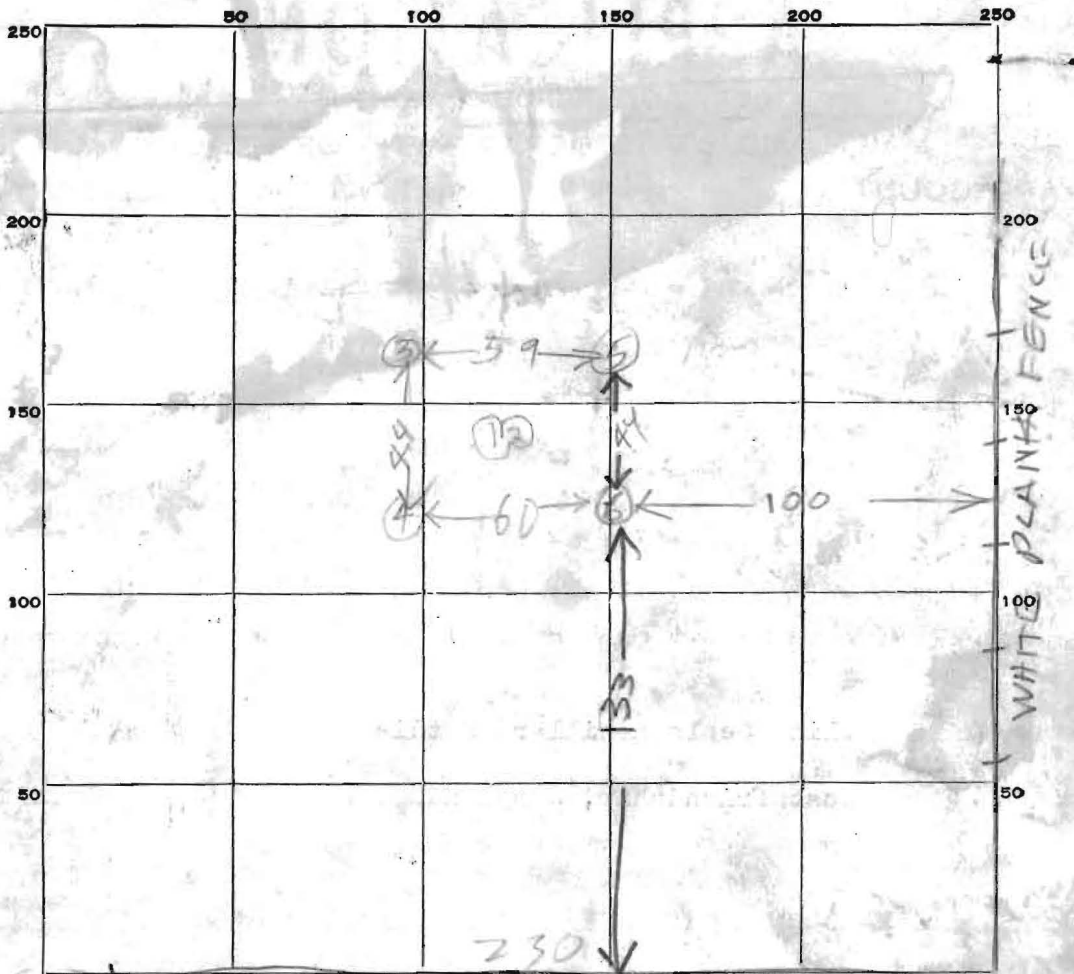

WIPPAK  
LOT

INDICATE NORTH. - NAME ADJOINING ROADWAY AS BASE LINE.

Block 144

DATE	TEST NO.	DEPTH	PRE-WET		TEST - 1" DROP		TIME
			START	STOP	START	STOP	
3/12/4	1	9	1001	1002	1002	1004	2
"	2	4	1007	1014	1014	1030	16
"	3	4	1010	1013	1013	1016	3
"	4	4	1012	1018	1018	1026	8
"	5	4	1018	1026	1026	1039	13
"	6	4	1021	1044	cattle pens		

16  
3  
13  
40  
58.0  
16

SOIL AUGER FINDING

TESTED BY

Raymond Hodges

REMARKS

ALSO PRESENT

Charles Mathis

LOT NO.


Charles W. Mathis, Jr.

12440 Frederick Road

West Friendship, Maryland

21794

Phone # 442-1635

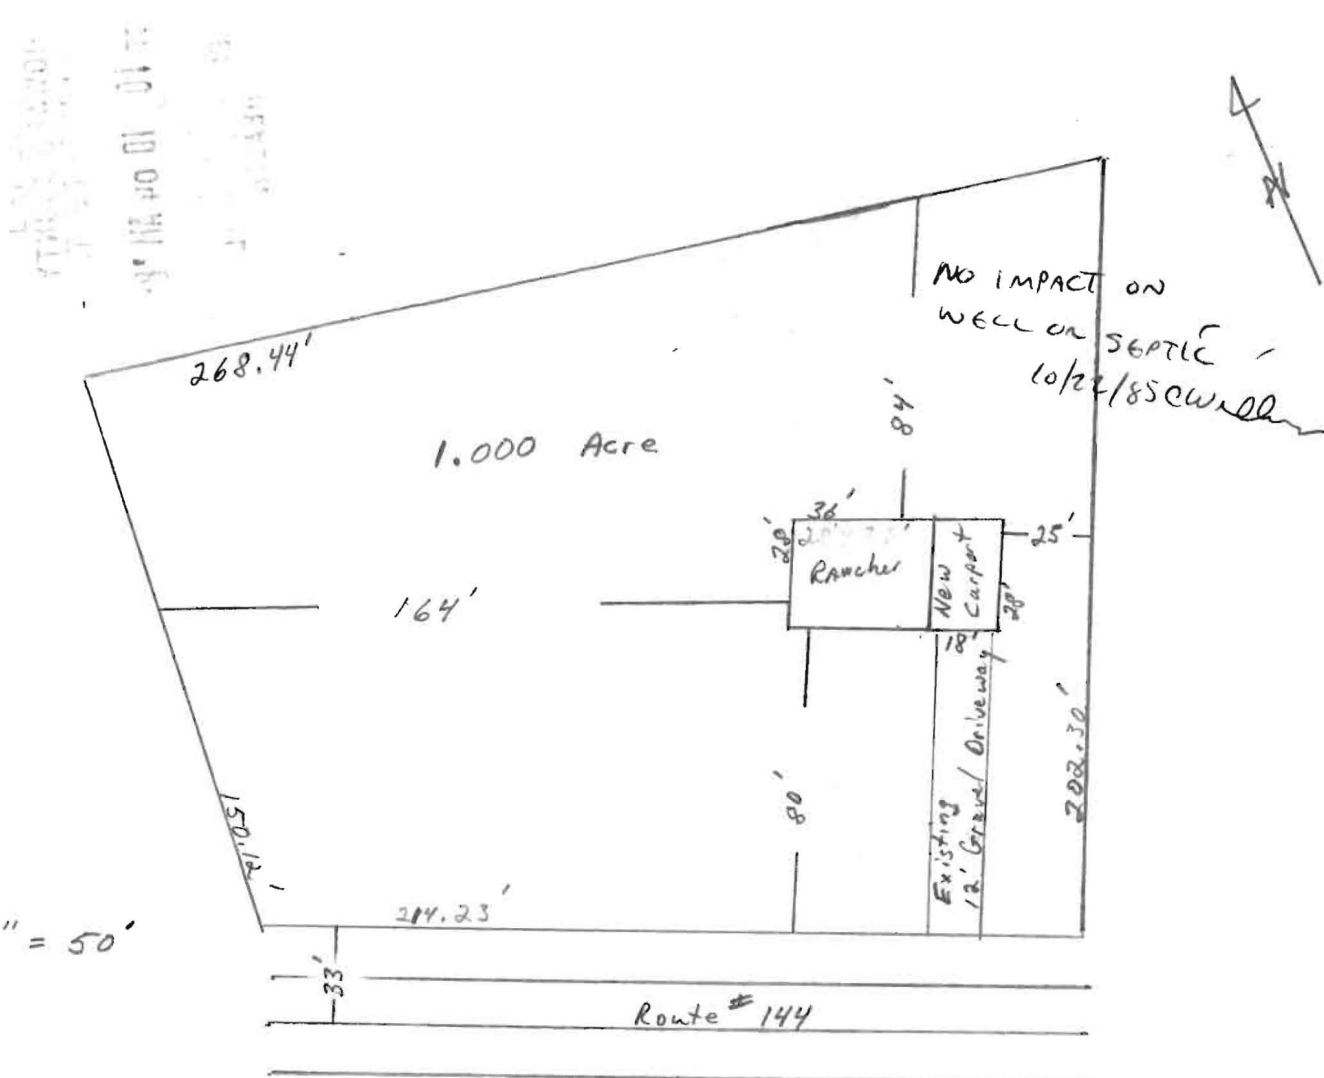

Scale 1" = 50'

Third Election District  
West Friendship, Maryland