


SITE INSPECTION SHEET

OWNER: _____ PHONE #: 410-530-4622
ADDRESS: 4910 Canvasback Dr. CONTRACTOR: Mike Stack
WELL TAG #: _____
SUBDIVISION: _____ LOT: _____ COUNTY #: _____
PROPOSAL: _____

LOCATION DIAGRAM

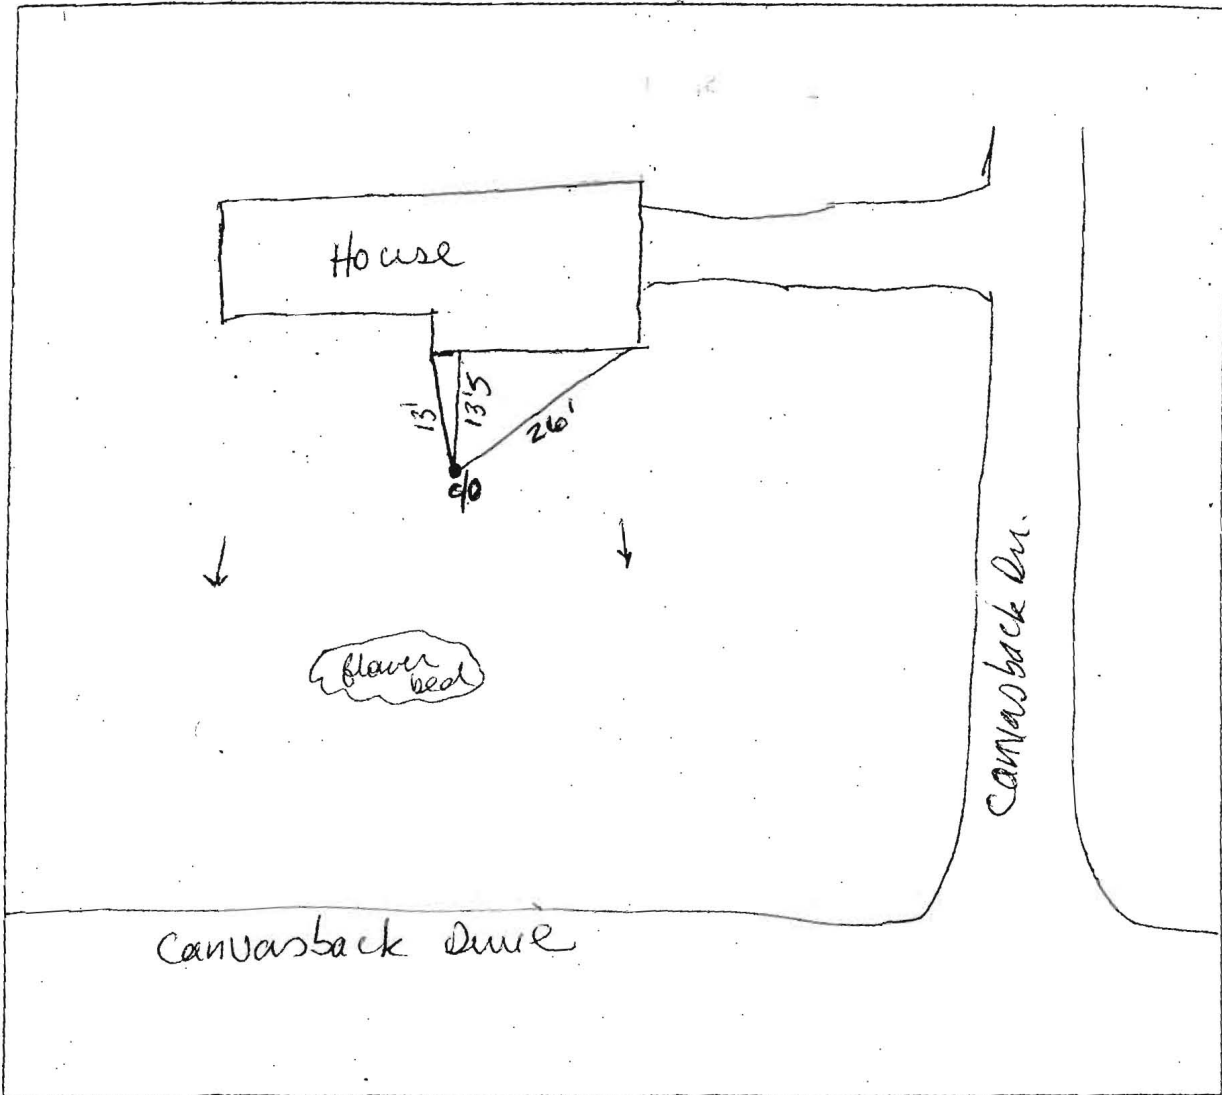

COMMENTS: Inlet was 22" below grade, Effluent levels were
~1'5"-2' below top of tank. No evidence of parking
system.

