

7/26/72
or 7/27/72

PERMIT

SEWAGE DISPOSAL SYSTEM

MARYLAND STATE DEPARTMENT OF HEALTH

HOWARD COUNTY

INDEXED

P 17256

A 13083

ELLICOTT CITY

DISTRICT 3

DATE 7/25/72

Jack Fyock

IS PERMITTED TO INSTALL ☒ ALTER

ADDRESS Ten Oaks Road, Glenolg, Maryland

PHONE 286-2939

A SEWAGE DISPOSAL SYSTEM LOCATED AT

SUBDIVISION Woodmark ROAD Carroll Mill Road & LOT 64, Blk. E, Sec. 3
Court "J"

PROPERTY OWNER Mr Mark A. Wakefield, Jr.

ADDRESS 231 Chatham Road, Ellicott City, Maryland

SPECIFICATIONS 5 bedrooms

DRAIN FIELD DEPTH FEET, BOTTOM AREA SQ. FT.

SEEPAGE PITS ABSORBENT SIDE-WALL AREA SQ. FT.

SEPTIC TANK CAPACITY 1500 GALLONS

FOR GARBAGE GRINDER, INCREASE DISPOSAL AREA 22% & TANK CAPACITY 50%.

OTHER Trench 80 ft. long - 2 ft. wide - 6 ft. - 4 ft. stone. Okay to


put gravel in. Location as per Mr. Monaghan's instructions.

PLANS APPROVED BY D.W. Monaghan DATE 7/ 10/14/68

FILL SEPTIC TANK AND DISTRIBUTION BOX WITH WATER BEFORE CALLING FOR AN INSPECTION, COVER NO WORK UNTIL INSPECTED AND APPROVED.

NEITHER THE HOWARD COUNTY COMMISSIONERS NOR THE HEALTH DEPARTMENT IS RESPONSIBLE FOR THE SUCCESSFUL OPERATION OF ANY SYSTEM.

A 13083

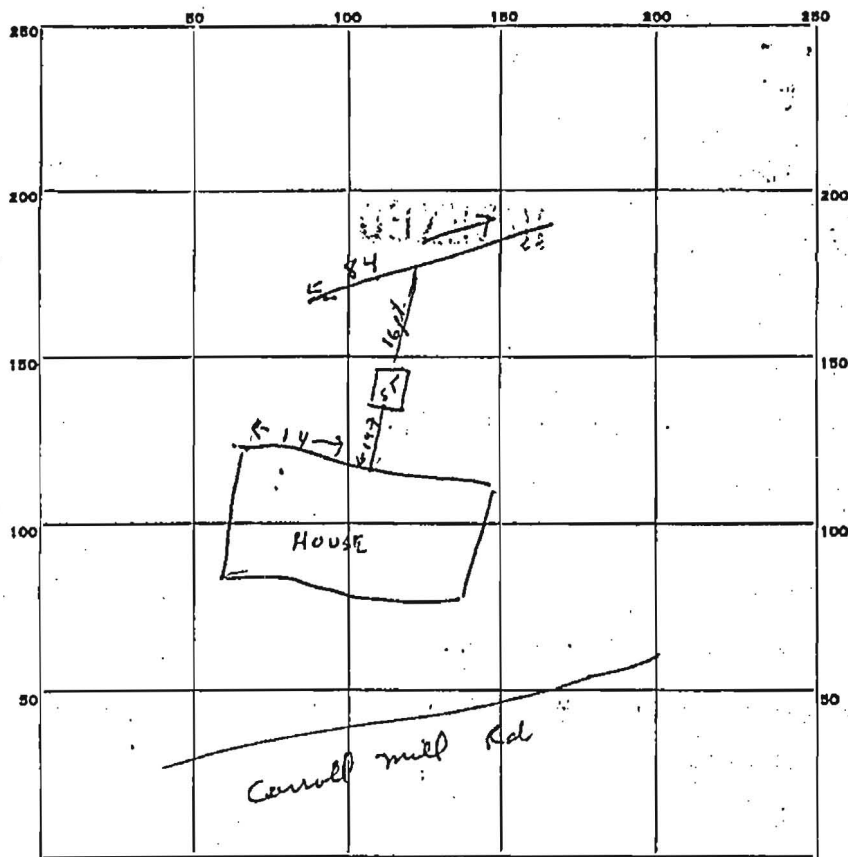

INDICATE NORTH. - NAME ADJOINING ROADWAY AS BASE LINE.

PERMIT CARD signed

SEPTIC TANK, LEVEL 1500 yd. OK

CLEANOUTS OK

DISTRIBUTION BOX, LEVEL —

TILE FIELD, DEPTH 6 FT. TRENCH WIDTH 2 FT.

GRAVEL DEPTH 24 ft IN. TOTAL LENGTH 84 FT.

NUMBER OF TRENCHES 1 Sidewall TOTAL BOTTOM AREA ?

SEEPAGE PITS, INSIDE DIAMETER — FT. DEPTH BELOW INLET — FT.

ABSORBENT AREA — SQ. FT.

REMARKS Trench depth and area OK by D.M.

DATE SYSTEM APPROVED 7/26/72 INSPECTOR R. Tane

Daniel G. Blake, Jr.

Phone: 988-9467

D. G. B., INC.


12218 Benson Branch Road
ELLICOTT CITY, MD. 21043

Dandy Built Homes By Dandy Dan

A13083



CARROLL MILL CT.

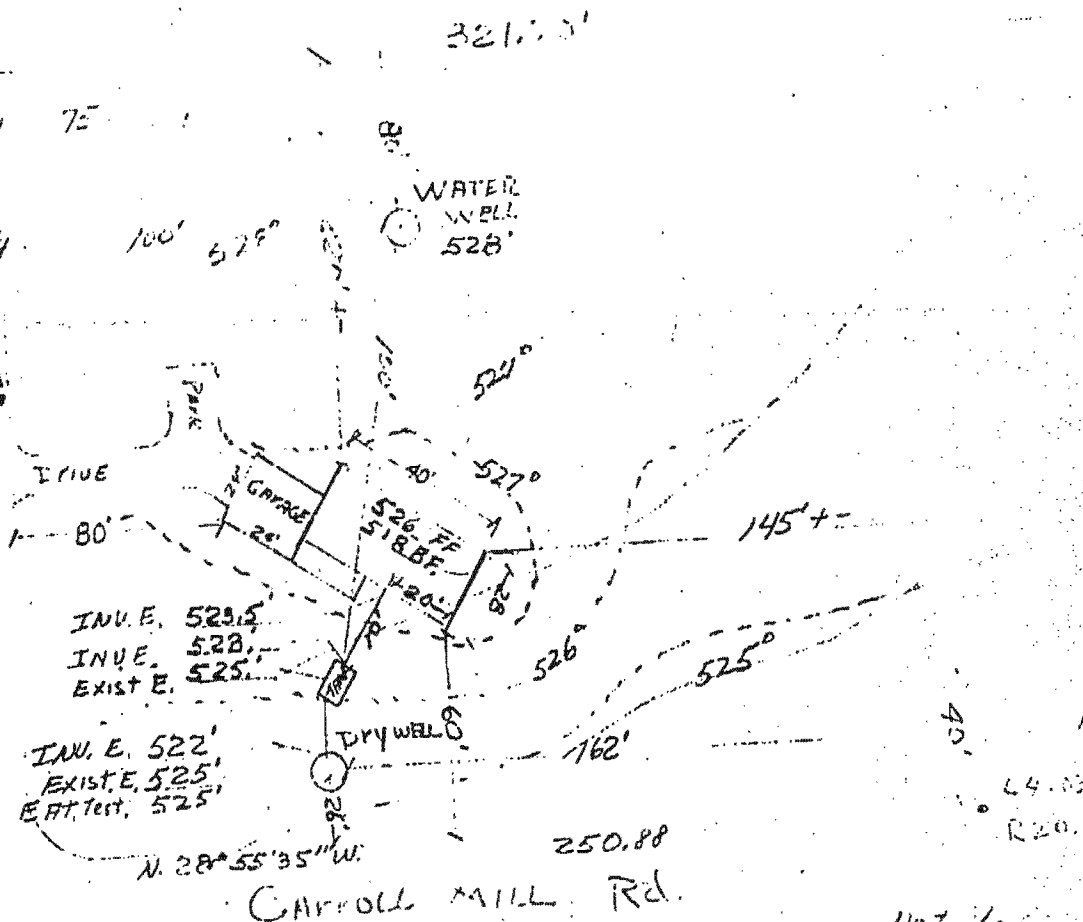

5-16-72
DGB

Residence for DGB
LOT 64 BLOCK E Section
WOOD MARK.

I certify the above measurement & elevation
differences are actual & correct

Daniel G. Blake