

10/24/78
10/23/78
G. J. J. J. J.
HOUSE & CO. 10/24/78
MA 021
Approved
GLK
28MNR79
P 27677
A 18534

PERMIT

SEWAGE DISPOSAL SYSTEM

MARYLAND STATE DEPARTMENT OF HEALTH

HOWARD COUNTY

ELLICOTT CITY

DISTRICT 3rd

DATE 3/16/78

INDEXED

10/24
Liberty Backhoe Service IS PERMITTED TO INSTALLY ALTER

ADDRESS Marriottsville, Md. PHONE

SUBDIVISION ROAD 12294 Carroll Mill Road Lot Parcel 2

PROPERTY OWNER Robert L. Hickerson

ADDRESS 6032 Chesworth Road, Baltimore, Md. 21228

SPECIFICATIONS 4 bedrooms

SEPTIC TANK CAPACITY 1250 GALLONS

DRAIN FIELD DEPTH FEET, BOTTOM AREA SQ. FT.

DEEP TRENCH DEPTH FEET, BOTTOM AREA SQ. FT.

SEEPAGE PITS ABSORBENT SIDE-WALL AREA 150 SQ. FT. per bedroom

INLET PIPE 4 FT. BELOW ORIGINAL GRADE. MAXIMUM DEPTH 11 FT. BELOW ORIGINAL GRADE

EFFECTIVE DEPTH AT FT. BELOW ORIGINAL GRADE.

LOCATE DISPOSAL AREA 70 FT. FROM 293.00 LOT LINE AND 45 FT. FROM 678.82 LOT LINE AS SEEN WHEN

FACING LOT FROM

PLANS APPROVED BY William W. Zepp DATE 3/24/73

COVER NO WORK UNTIL INSPECTED AND APPROVED.

NEITHER THE HOWARD COUNTY COUNCIL NOR THE HEALTH DEPARTMENT IS RESPONSIBLE FOR THE SUCCESSFUL OPERATION OF ANY SYSTEM.

NOTE: IF TRENCH IS USED CALL FOR INSPECTION BEFORE PLACING GRAVEL IN TRENCH.

NOTE: NO DRY WELL SHALL EXCEED 15 FOOT IN DIAMETER.

NOTE: ALL PIPE FROM HOUSE TO DISPOSAL AREA MUST BE CAST IRON.

PERMIT VOID AFTER THREE YEARS.

NOTE: INSTALL STAND PIPE ON SEPTIC TANK AND DRY WELL. STAND PIPES MUST BE 6 INCHES IN DIAMETER. CAST IRON, CONCRETE OR TERRA COTTA ACCEPTED.

*INSTALLER IS RESPONSIBLE FOR OBTAINING FINAL APPROVAL ON THIS PERMIT.

HD - 23

A 18534

5 Jan 79

system backfilled - but plumbing inside. will cap & replace. (GLK) unoccupied

8 Jan 79

contacted Schrieber and informed him that system 3 water test will be needed call (10 days) (GLK)

15 Jan 79


House connection could be made. Schrieber will call to make appointment for water test. (GLK)

7 Mar 79

Schrieber will contact us. (GLK)

28 Mar 79

House connection made (GLK)

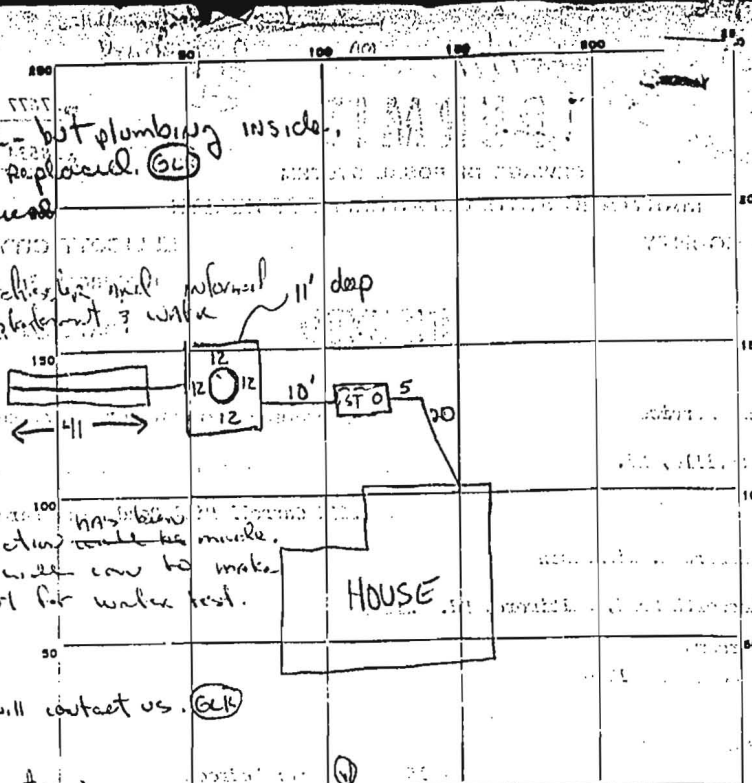

INDICATE NORTH - NAME ADJOINING ROADWAY AS BASE LINE.

Carroll Mill RD

PERMIT CARD thirteen

SEPTIC TANK, LEVEL 1250 top of

CLEANOUTS ✓ ✓ CAST IRON

DISTRIBUTION BOX, LEVEL No

TILE FIELD, DEPTH 11 FT. TRENCH WIDTH 2 FT.

GRAVEL DEPTH 7' TOTAL LENGTH 41 FT.

NUMBER OF TRENCHES 1 TOTAL BOTTOM AREA 287

SEEPAGE PITS, INSIDE DIAMETER 48 FT. DEPTH BELOW INLET 7 FT.

ABSORBENT AREA +623 SQ. FT.

REMARKS 23 Oct 79 - Call for final when gravel is added to trench, 3 when work on drainwell & septic tank complete (GLK) 24 Oct 78 - Inlet to drainwell AT 3'. Call for final when house connection installed. OK to backfill system but final approval will not be given until water well has a proper cover - (currently a plastic wrapping) (GLK) 5 Jan 79 - Unable to inspect house connection - see above

DATE SYSTEM APPROVED 28 MAR 79 INSPECTOR G. Keller