

7-8-98
H: 8
7/13/98
ASAP

PERMIT

SEWAGE DISPOSAL SYSTEM

DEPARTMENT OF HEALTH AND MENTAL HYGIENE

P 510224-B

A REPAIR

DISTRICT _____

HOWARD COUNTY HEALTH DEPARTMENT

DATE 6-24-98

BUREAU OF ENVIRONMENTAL HEALTH

~~XXXXXXXXX~~ 410-313-2640

DATE SYSTEM APPROVED 7.13.98

INDEXED

INSPECTOR [Signature]

Jack Fyock Septic Services IS PERMITTED TO INSTALL _____ ALTER X

ADDRESS P.O. Box 89, Glenelg, MD 21737 PHONE 410-988-9270

SUBDIVISION Friendship Manor LOT 2 ROAD 12557 Route 144

PROPERTY OWNER Malinowski

ADDRESS 12557 Route 144, West Friendship, MD 21794

SEPTIC TANK CAPACITY 1000 GALLONS

NUMBER OF BEDROOMS 3

125 SQUARE FEET PER BEDROOM

LINEAR FEET OF TRENCH REQUIRED 85

REPAIR - PURPOSE - SEPTIC SYSTEM HAS FAILED.

Call for an inspection when the ground is opened so a sanitarian can recommend repairs. 7-8-98.

INLET 5.5, BOTTOM 10'

PLANS APPROVED BY [Signature] 7/13/98 DATE _____

COVER NO WORK UNTIL INSPECTED AND APPROVED

NEITHER THE HOWARD COUNTY COUNCIL NOR THE HEALTH DEPARTMENT IS RESPONSIBLE FOR THE SUCCESSFUL OPERATION OF ANY SYSTEM

NOTE: CLEANOUT REQUIRED EVERY 70 FEET OF SEWER LINE AND/OR AT 90° SWEEPS IN LINES FROM HOUSE TO DRAIN FIELDS, 90° ELBOWS NOT ACCEPTABLE.

NOTE: ALL PARTS OF SEPTIC SYSTEMS (I.E. TANK, DISTRIBUTION BOX TRENCHES) TO BE 100 FEET FROM WELL (UNLESS OTHERWISE SPECIFICALLY AUTHORIZED)

NOTE: IF DEEP TRENCH(ES) ARE USED CALL FOR INSPECTION BEFORE AND AFTER PLACING GRAVEL IN TRENCH(ES)

NOTE: NO DRY WELL SHALL EXCEED 15 FOOT IN DIAMETER NO ABSORPTION TRENCH TO EXCEED 100 FEET IN LENGTH

NOTE: ALL PIPE FROM HOUSE TO SEPTIC TANK MUST BE CAST IRON OR SCHEDULE 35/40 PVC OR ABS

PERMIT VOID AFTER TWO YEARS

NOTE: INSTALL STAND PIPE ON SEPTIC TANK AND DRY WELL STAND PIPES MUST BE 6 INCHES IN DIAMETER CAST IRON, CONCRETE OR TERRA COTTA OR PVA OR ABS ACCEPTED. IF TOP OF SEPTIC TANK IS DEEPER THAN 3 FEET, MANHOLE TO GRADE REQUIRED.


NOTE: DISTRIBUTION BOXES MUST HAVE BAFFLES

*INSTALLER IS RESPONSIBLE FOR OBTAINING FINAL APPROVAL ON THIS PERMIT

HD-260(6-90)

*CALL 461-9933 FOR INSPECTION OF SEPTIC SYSTEM.

A 510224-B

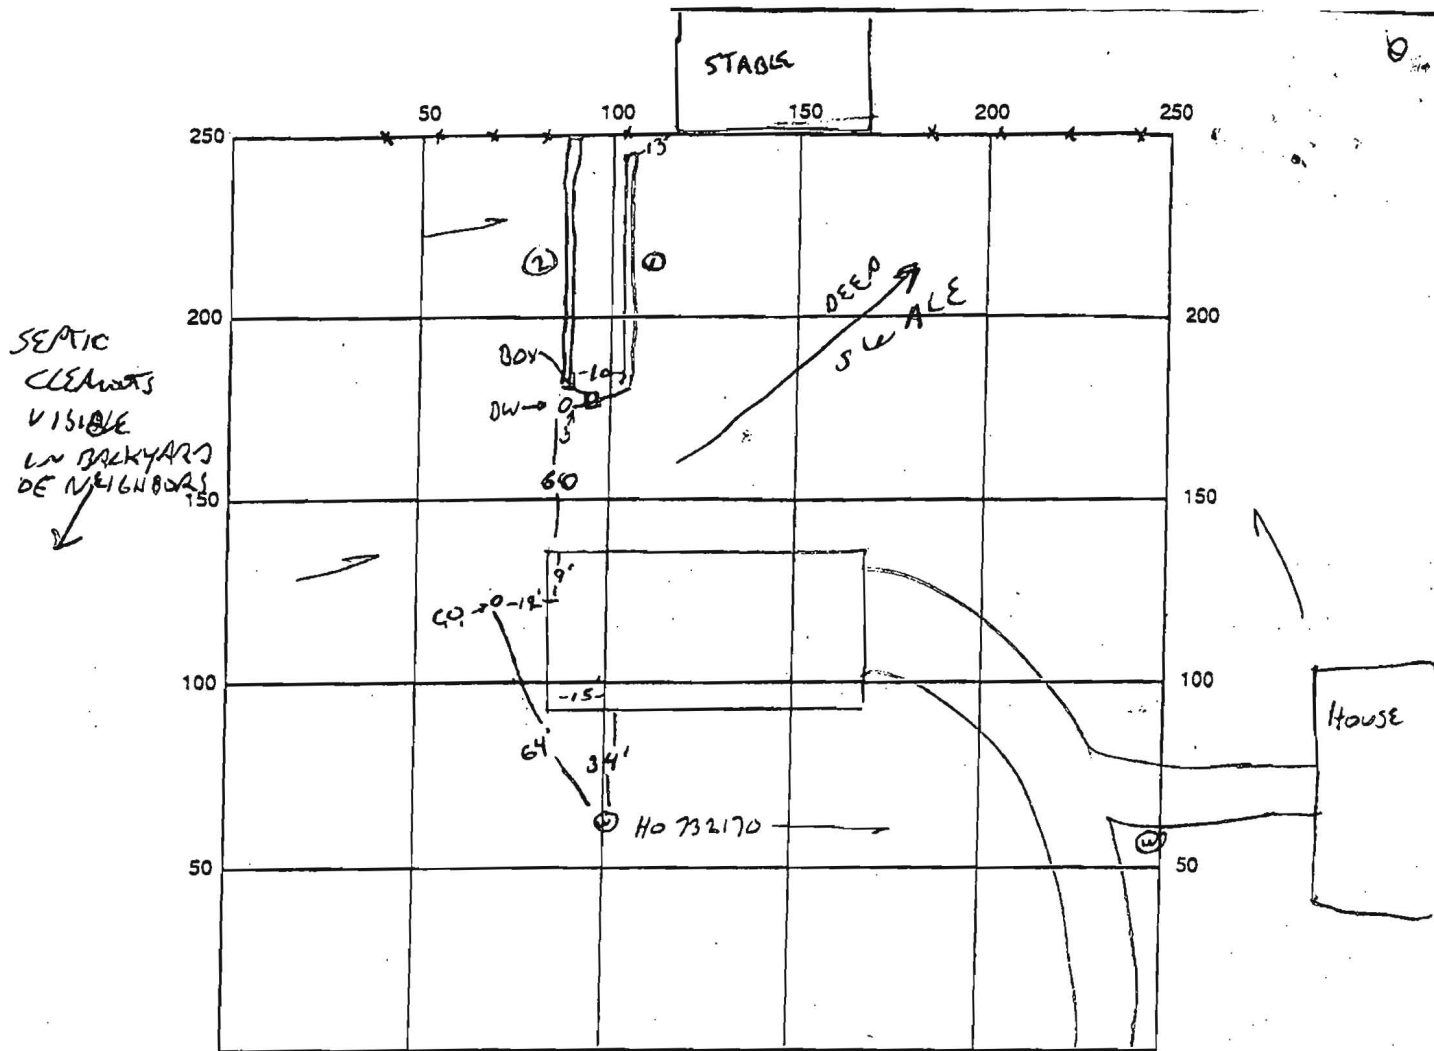

INDICATE NORTH - NAME ADJOINING ROADWAY AS BASE LINE
E — RT 144 — W

SEPTIC TANK LEVEL NA CLEANOUTS NA

DISTRIBUTION BOX LEVEL OK

DRAIN FIELD/TITLE DEPTH 10 FT. TRENCH WIDTH 2 FT. INLET DEPTH 15.5 FT.

EFFECTIVE GRAVEL DEPTH 4.5 FT. TOTAL LENGTH 45 1/2 = 102 FT.

NUMBER OF TRENCHES 2 ONE SIDEWALL/BOTTOM AREA 459 SQ. FT.

DRYWALL INSIDE DIAMETER 64 FT. EFFECTIVE DEPTH BELOW INLET 15.5 FT.

ABSORBENT AREA ✓ SQ. FT.

REMARKS: 7.13.98 OK TO FINISH 1ST TRENCH 7.13 FINAL COVER

ALL WORK

TEST HOLE DUG 15' DEEP DRYWALL, CLAY TO 3', SAND CLAY TO BOTTOM, DRY.

DATE SYSTEM APPROVED 7.13.98

INSPECTOR [Signature]