

MARYLAND DEPARTMENT OF THE ENVIRONMENT, WATER MANAGEMENT ADMINISTRATION  
1800 Washington Blvd., Baltimore, Maryland 21230 (410) 537-3784

\*\*\*\*\*  
WATER WELL ABANDONMENT-SEALING REPORT FORM  
\*\*\*\*\*

SUBMIT COPIES OF COMPLETED FORM TO:

- \* COUNTY ENVIRONMENT AGENCY (contact MDE, WMA if address needed)
- \* WELL OWNER
- \* MDE, WATER MANAGEMENT ADMINISTRATION, WELL PROGRAM

DATE WELL ABANDONED: 11-1-07 (month/day/year)

OK  
11/5/16 SC

\* PERMIT NUMBER OF ABANDONED WELL (if any) \_\_\_\_\_

\* PERMIT NUMBER OF REPLACEMENT WELL \_\_\_\_\_

HO - 95 - 0480

\* PERSON ABANDONING WELL: Darren E. Wilson


WELL DRILLERS LICENSE NUMBER: MSD 188

CIRCLE: MWD/MSD/MGD

\* OWNER'S NAME: John Smith

SITE LOCATION MAP

\* WELL LOCATION:  
COUNTY: Howard  
NEAREST TOWN: Mt Airy  
TAX MAP \_\_\_\_\_ BLOCK \_\_\_\_\_ PARCEL \_\_\_\_\_  
SUBDIVISION: \_\_\_\_\_  
SECTION: \_\_\_\_\_ LOT: \_\_\_\_\_  
NEAREST ROAD: 1421 Long Corner Rd

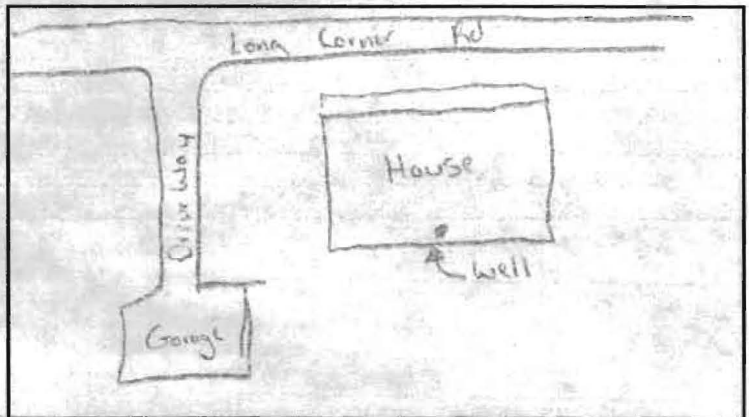

\* TYPE OF WELL BEING ABANDONED:

- DRILLED
- BORED/AUGERED
- OTHER (specify) \_\_\_\_\_
- JETTED
- HAND DUG

LOG OF SEALING MATERIAL

MATERIAL	FEET	
	FROM	TO
Cement	02	2
Fill Dirt	2	0

\* USE CODE:

- DOMESTIC
- IRRIGATION
- TEST/OBSERVATION
- MUNICIPAL/PUBLIC
- INDUSTRIAL
- GEOTHERMAL

\* TYPE OF CASING:

- STEEL
- CONCRETE
- PLASTIC
- OTHER (specify) Terra Cotta

\* SIZE OF CASING: 5" INCHES IN DIAMETER

\* DEPTH OF WELL: 02 FEET DEEP

\* WAS ANY CASING REMOVED?  YES  NO  
if yes, length removed, in feet: \_\_\_\_\_

\* WAS CASING RIPPED OR PERFORATED?  YES  NO

VOLUME OF MATERIAL USED
<u>20 - bags</u>

SIGNATURE - MASTER WELL DRILLER OR SUPERVISING SANITARIAN George J. Kestenberg LICENSE # 040

CIRCLE ONE MWD/MSD/MGD DATE 1-30-07