
 WATER WELL ABANDONMENT-SEALING REPORT FORM

SUBMIT COPIES OF COMPLETED FORM TO:

- * COUNTY ENVIRONMENT AGENCY (contact MDE, WMA if address needed)
- * WELL OWNER
- * MDE, WATER MANAGEMENT ADMINISTRATION, WELL PROGRAM

DATE WELL ABANDONED: 4-14-2010 (month/day/year)

OK
 1/5/16 SC

* PERMIT NUMBER OF ABANDONED WELL (if any) none — —

* PERMIT NUMBER OF REPLACEMENT WELL none — —


* PERSON ABANDONING WELL: Joseph R. Mayne

WELL DRILLERS LICENSE NUMBER: MSD024

CIRCLE: MWD/MSD/MGD

* OWNER'S NAME: Hillsmith Certified Automotive

SITE LOCATION MAP

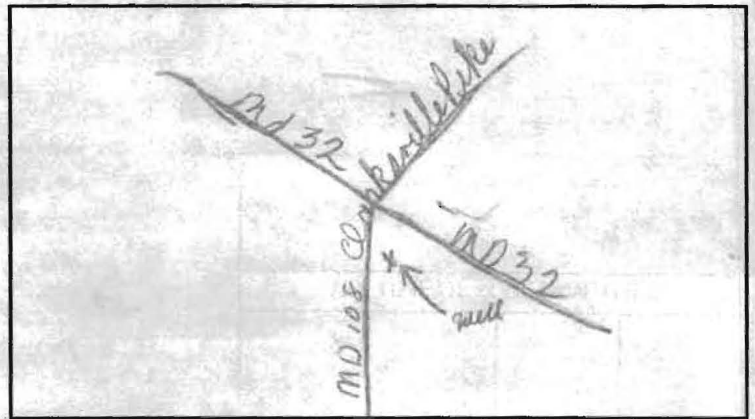

* WELL LOCATION:
 COUNTY: Howard
 NEAREST TOWN: Clarksville
 TAX MAP _____ BLOCK _____ PARCEL _____
 SUBDIVISION: _____
 SECTION: _____ LOT: _____
 NEAREST ROAD: 12411 Clarksville Rd

* TYPE OF WELL BEING ABANDONED:

- DRILLED _____ JETTED
- _____ BORED/AUGERED _____ HAND DUG
- _____ OTHER (specify) _____

* USE CODE:

- DOMESTIC _____ MUNICIPAL/PUBLIC
- _____ IRRIGATION _____ INDUSTRIAL
- _____ TEST/OBSERVATION _____ GEOTHERMAL

* TYPE OF CASING:

- STEEL _____ PLASTIC
- _____ CONCRETE _____ OTHER (specify) _____

* SIZE OF CASING: 6 INCHES IN DIAMETER

* DEPTH OF WELL: 135 FEET DEEP

* WAS ANY CASING REMOVED? ___ YES ___ NO
 if yes, length removed, in feet: _____

* WAS CASING RIPPED OR PERFORATED? ___ YES ___ NO

LOG OF SEALING MATERIAL

MATERIAL	FEET	
	FROM	TO
Cement & gravel mixed	0	135
VOLUME OF MATERIAL USED		

SIGNATURE - MASTER WELL DRILLER OR SUPERVISING SANITARIAN: Joseph R. Mayne LICENSE # MSD024 CIRCLE ONE MWD/MSD/MGD DATE 4-14-2010