

MARYLAND DEPARTMENT OF THE ENVIRONMENT, WATER MANAGEMENT ADMINISTRATION
 1800 Washington Blvd., Baltimore, Maryland 21230 (410) 537-3784

 WATER WELL ABANDONMENT-SEALING REPORT FORM

SUBMIT COPIES OF COMPLETED FORM TO:

- * COUNTY ENVIRONMENT AGENCY (contact MDE, WMA if address needed)
- * WELL OWNER
- * MDE, WATER MANAGEMENT ADMINISTRATION, WELL PROGRAM

DATE WELL ABANDONED: April 23 2010 (month/day/year)

OK
 115/1650

* PERMIT NUMBER OF ABANDONED WELL (if any) N/A - -


* PERMIT NUMBER OF REPLACEMENT WELL N/A - -

* PERSON ABANDONING WELL: Ralph F. MAYNE WELL DRILLERS LICENSE NUMBER: 117

* OWNER'S NAME: Trinity-BLDS CIRCLE: MWD/MSD/MGD

SITE LOCATION MAP

* WELL LOCATION: Howard
 COUNTY: Howard
 NEAREST TOWN: West Friendship
 TAX MAP _____ BLOCK _____ PARCEL _____
 SUBDIVISION: N/A
 SECTION: N/A LOT: N/A
 NEAREST ROAD: 11350 MD Rt. 144

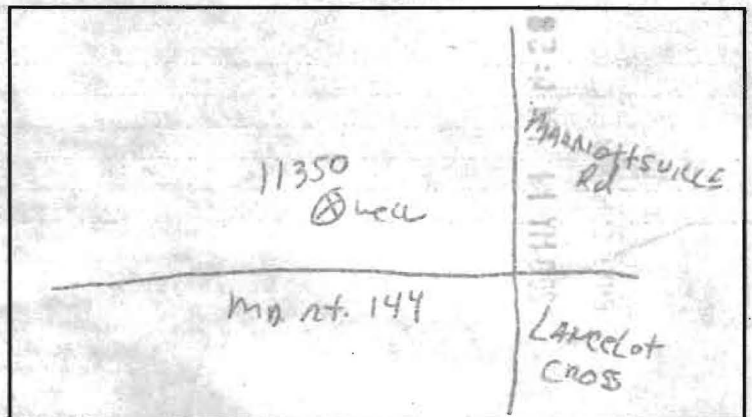

* TYPE OF WELL BEING ABANDONED:
 DRILLED _____ JETTED _____
 _____ BORED/AUGERED _____ HAND DUG _____
 _____ OTHER (specify) _____

* USE CODE:
 DOMESTIC _____ MUNICIPAL/PUBLIC _____
 _____ IRRIGATION _____ INDUSTRIAL _____
 _____ TEST/OBSERVATION _____ GEOTHERMAL _____

* TYPE OF CASING:
 STEEL _____ PLASTIC _____
 _____ CONCRETE _____ OTHER (specify) _____

* SIZE OF CASING: 6 INCHES IN DIAMETER

* DEPTH OF WELL: 71 FEET DEEP

* WAS ANY CASING REMOVED? _____ YES _____ NO
 if yes, length removed, in feet: _____

* WAS CASING RIPPED OR PERFORATED? _____ YES _____ NO

LOG OF SEALING MATERIAL

MATERIAL	FEET	
	FROM	TO
<u>Cemat.</u>	<u>71</u>	<u>0</u>
VOLUME OF MATERIAL USED		
<u>17.5935</u>		

SIGNATURE-MASTER WELL DRILLER OR SUPERVISING SANITARIAN [Signature] LICENSE # 117 CIRCLE ONE 1 DATE APRIL 29 2010