

\*\*\*\*\*  
 WATER WELL ABANDONMENT-SEALING REPORT FORM  
 \*\*\*\*\*

SUBMIT COPIES OF COMPLETED FORM TO:

- \* COUNTY ENVIRONMENTAL AGENCY (contact MDE, WMA if address needed)
- \* WELL OWNER
- \* MDE, WATER MANAGEMENT ADMINISTRATION, WELL PROGRAM

OK  
 12/30/15 SC

DATE WELL ABANDONED: 2/1/13 (month/day/year)

\* PERMIT NUMBER OF ABANDONED WELL (if any) \_\_\_\_\_


\* PERMIT NUMBER OF REPLACEMENT WELL: \_\_\_\_\_

\* PERSON ABANDONING WELL: Kevin P Weigle WELL DRILLER'S LICENSE NUMBER: 552  
 CIRCLE: MWD / MSD / MGD

\* OWNER'S NAME: Boise Cascade

\* WELL LOCATION:  
 COUNTY: Howard  
 NEAREST TOWN: Annapolis Junction  
 TAX MAP 0018 BLOCK \_\_\_\_\_ PARCEL 0137  
 SUBDIVISION: \_\_\_\_\_  
 SECTION: \_\_\_\_\_ LOT: Part B  
 STREET ADDRESS: 8960 Henkels Lane

SITE LOCATION MAP

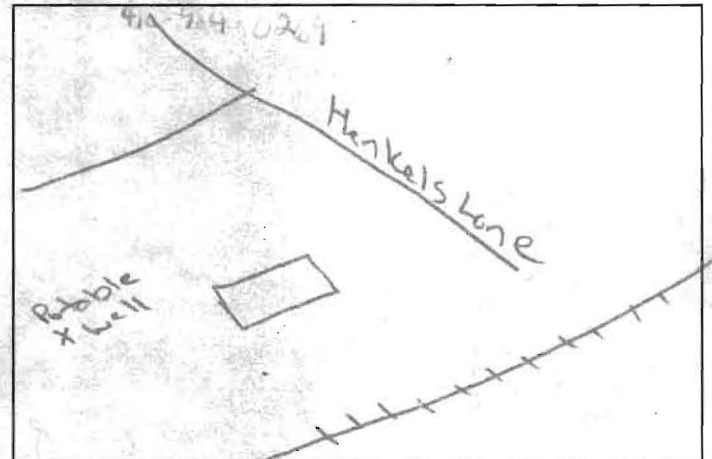

LATITUDE 3 - . plot plus - - -

LONGITUDE 7 - . 16350 - - -

Kevin P Weigle 1 MWD 552  
 Drillers Signature License No.

\* TYPE OF WELL BEING ABANDONED:  
 DRILLED  JETTED  
 BORED  HAND DUG  
 OTHER (specify) \_\_\_\_\_

LOG OF SEALING MATERIAL

MATERIAL	FEET	
	FROM	TO
Cement / Bentonite Grout	0	60

\* USE CODE: DOMESTIC  IRRIGATION  MUNICIPAL/PUBLIC  
 TEST/OBSERVATION  INDUSTRIAL  
 on site pebbles  GEOTHERMAL

\* TYPE OF CASING:  
 STEEL  PLASTIC  
 CONCRETE  OTHER (specify) \_\_\_\_\_

SIZE OF CASING: 6 INCHES IN DIAMETER

DEPTH OF WELL: 60 FEET DEEP

WAS ANY CASING REMOVED?  YES  NO  
 If yes, length removed, in feet: 2

WAS CASING RIPPED OR PERFORATED?  YES  NO

VOLUME OF MATERIAL USED	
1786 lbs portland	115 gallons water
90 lbs benseal	

