

MARYLAND DEPARTMENT OF THE ENVIRONMENT, WATER MANAGEMENT ADMINISTRATION
 1800 Washington Blvd., Baltimore, Maryland 21230 (410) 537-3784

 WATER WELL ABANDONMENT-SEALING REPORT FORM

SUBMIT COPIES OF COMPLETED FORM TO:

- * COUNTY ENVIRONMENT AGENCY (contact MDE, WMA if address needed)
- * WELL OWNER
- * MDE, WATER MANAGEMENT ADMINISTRATION, WELL PROGRAM

DATE WELL ABANDONED: 8/19/13 (month/day/year)

OK
 12/31/15 SC

* PERMIT NUMBER OF ABANDONED WELL (if any) _____

* PERMIT NUMBER OF REPLACEMENT WELL _____

* PERSON ABANDONING WELL: Michael Tsom


WELL DRILLERS LICENSE NUMBER: 162

CIRCLE: MWD/MSD/MGD

* OWNER'S NAME: Griz

SITE LOCATION MAP

* WELL LOCATION:
 COUNTY: HOWARD
 NEAREST TOWN: LAUREL
 TAX MAP 46 BLOCK 11 PARCEL 56
 SUBDIVISION: _____
 SECTION: _____ LOT: _____
 NEAREST ROAD: 10883 Scaggsville Road

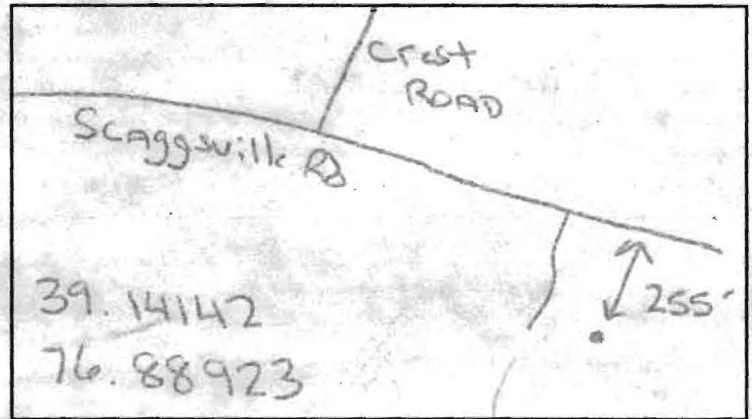

* TYPE OF WELL BEING ABANDONED:

- _____ DRILLED _____ JETTED
- _____ BORED/AUGERED HAND DUG
- _____ OTHER (specify) _____

LOG OF SEALING MATERIAL

MATERIAL	FEET	
	FROM	TO
Stone	42	5
Cement	5	2
Soil	2	0
VOLUME OF MATERIAL USED		

* USE CODE:

- DOMESTIC _____ MUNICIPAL/PUBLIC
- _____ IRRIGATION _____ INDUSTRIAL
- _____ TEST/OBSERVATION _____ GEOTHERMAL

* TYPE OF CASING:

- _____ STEEL _____ PLASTIC
- _____ CONCRETE OTHER (specify) Stone

* SIZE OF CASING: 36 INCHES IN DIAMETER

* DEPTH OF WELL: 42 FEET DEEP

* WAS ANY CASING REMOVED? _____ YES NO
 if yes, length removed, in feet: _____

* WAS CASING RIPPED OR PERFORATED? _____ YES NO

SIGNATURE-MASTER WELL DRILLER OR SUPERVISING SANITARIAN

LICENSE # 162

MWD/MSD/MGD CIRCLE ONE

DATE 8/20/13

