

MARYLAND DEPARTMENT OF THE ENVIRONMENT, WATER MANAGEMENT ADMINISTRATION
1800 Washington Blvd., Baltimore, Maryland 21230 (410) 537-3784

WATER WELL ABANDONMENT-SEALING REPORT FORM

SUBMIT COPIES OF COMPLETED FORM TO:

- * COUNTY ENVIRONMENTAL AGENCY (contact MDE, WMA if address needed)
- * WELL OWNER
- * MDE, WATER MANAGEMENT ADMINISTRATION, WELL PROGRAM

OK
1/4/15 SC

DATE WELL ABANDONED: 6/13/12 (month/day/year)

* PERMIT NUMBER OF ABANDONED WELL (if any) _____

* PERMIT NUMBER OF REPLACEMENT WELL: _____


* PERSON ABANDONING WELL: Robert P. Lepay WELL DRILLER'S LICENSE NUMBER: 1161
CIRCLE: MWD / MSD / MGD

* OWNER'S NAME: Michael Stawlas

* WELL LOCATION:

SITE LOCATION MAP

COUNTY: Howard
NEAREST TOWN: Ellicott City
TAX MAP 24 BLOCK 02 PARCEL 0068
SUBDIVISION: Stawlas Rt 40 business
SECTION: _____ LOT: A2
STREET ADDRESS: 10045 Balt. National Pike

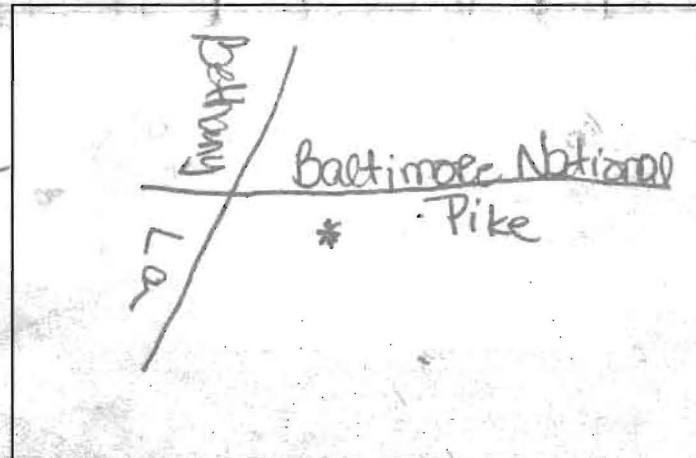

LATITUDE 3 9.278875

LONGITUDE 7 6.857737

* TYPE OF WELL BEING ABANDONED:

☒ DRILLED ☐ JETTED
☐ BORED ☐ HAND DUG
☐ OTHER (specify) _____

LOG OF SEALING MATERIAL

* USE CODE: DOMESTIC

☐ IRRIGATION ☒ MUNICIPAL/PUBLIC
☐ TEST/OBSERVATION ☐ INDUSTRIAL
☐ ☐ GEOTHERMAL

* TYPE OF CASING:

☒ STEEL ☐ PLASTIC
☐ CONCRETE ☐ OTHER (specify) _____

SIZE OF CASING: 6" INCHES IN DIAMETER

DEPTH OF WELL: 51 FEET DEEP

WAS ANY CASING REMOVED? ☐ YES ☒ NO

If yes, length removed, in feet: _____

WAS CASING RIPPED OR PERFORATED? ☐ YES ☒ NO

MATERIAL	FEET	
	FROM	TO
Bentonite Clay	51	4
clean fill	4	0
VOLUME OF MATERIAL USED		
155 lbs Bentonite clay		

COUNTY

