

MARYLAND DEPARTMENT OF THE ENVIRONMENT, WATER MANAGEMENT ADMINISTRATION
 1800 Washington Blvd., Baltimore, Maryland 21230 (410) 537-3784

 WATER WELL ABANDONMENT-SEALING REPORT FORM

SUBMIT COPIES OF COMPLETED FORM TO:

- * COUNTY ENVIRONMENT AGENCY (contact MDE, WMA if address needed)
- * WELL OWNER
- * MDE, WATER MANAGEMENT ADMINISTRATION, WELL PROGRAM

OK
 12/31/15 SC

DATE WELL ABANDONED: APRIL 22 2011 (month/day/year)

* PERMIT NUMBER OF ABANDONED WELL (if any) N/A

* PERMIT NUMBER OF REPLACEMENT WELL N/A

* PERSON ABANDONING WELL: RAUL E MAYNE


WELL DRILLERS LICENSE NUMBER: 11115

CIRCLE: MWD/MSD/MGD

* OWNER'S NAME: MARTINE CYNTHIA GARCIA

SITE LOCATION MAP

* WELL LOCATION:
 COUNTY: HOWARD
 NEAREST TOWN: ELLICOTT CITY
 TAX MAP 37 BLOCK _____ PARCEL 210
 SUBDIVISION: _____
 SECTION: _____ LOT: _____
 NEAREST ROAD: 6166 MONTGOMERY RD

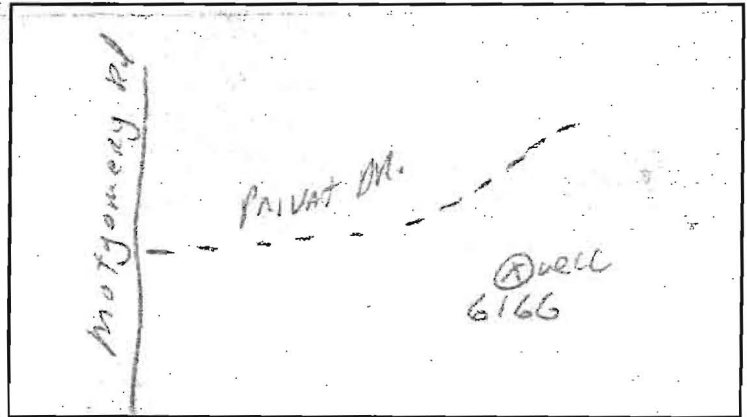

* TYPE OF WELL BEING ABANDONED:

- DRILLED JETTED
- BORED/AUGERED HAND DUG
- OTHER (specify) _____

LOG OF SEALING MATERIAL

MATERIAL	FEET	
	FROM	TO
STONE	104	25
Cement	25	5
Top Soil	5	0

* USE CODE:

- DOMESTIC MUNICIPAL/PUBLIC
- IRRIGATION INDUSTRIAL
- TEST/OBSERVATION GEOTHERMAL

* TYPE OF CASING:

- STEEL PLASTIC
- CONCRETE OTHER (specify) _____

* SIZE OF CASING: 6" INCHES IN DIAMETER

* DEPTH OF WELL: 104 FEET DEEP

* WAS ANY CASING REMOVED? YES NO
 if yes, length removed, in feet: _____

* WAS CASING RIPPED OR PERFORATED? YES NO

VOLUME OF MATERIAL USED

ONE TON STONE
10 BAGS CEMENT

SIGNATURE - MASTER WELL DRILLER OR SUPERVISING SANITARIAN [Signature] LICENSE # 117 CIRCLE-ONE 4/22/11 DATE