

9/22/71

PERMIT

Partial Padded C. 80
H. 103
P 16312
A 11443

SEWAGE DISPOSAL SYSTEM

MARYLAND STATE DEPARTMENT OF HEALTH

HOWARD COUNTY

ELLICOTT CITY

DISTRICT 3

INDEXED

DATE 8/10/71

V. E. Byrd

IS PERMITTED TO INSTALL ALTER

ADDRESS 409 Madoka Road, Linthicum Heights, Md.

PHONE 789-1778

A SEWAGE DISPOSAL SYSTEM LOCATED AT _____

SUBDIVISION Green Range

ROAD Evergreen Way #

LOT 25, Sec. 3

Unnamed road

PROPERTY OWNER Carroll, Inc.

ADDRESS _____

SPECIFICATIONS - 4 bedrooms

DRAIN FIELD _____ DEPTH _____ FEET. BOTTOM AREA _____ SQ. FT.

BEEPAGE PITS _____ ABSORBENT SIDE-WALL AREA _____ SQ. FT.

SEPTIC TANK CAPACITY 1,200 GALLONS

FOR GARBAGE GRINDER, INCREASE DISPOSAL AREA 22% & TANK CAPACITY 50%.

OTHER Two dry wells - Each 11 ft. in dia. by 6 ft. deep below the inlet pipe.

Bottom of dry wells to be no deeper than 9 ft. below original grade. First dry well to be

located 150-ft. from front lot line and 45 ft. from left side side lot line as seen when

facing lot from Evergreen Way. Dry wells to be 40 ft. apart measured edge to edge.

NOTE: ALL PIPE FROM HOUSE TO SEPTIC TANK MUST BE CAST IRON.

PERMIT VOID AFTER THREE YEARS.


PLANS APPROVED BY J. H. Kilmore

DATE 3/28/67

FILL SEPTIC TANK AND DISTRIBUTION BOX WITH WATER BEFORE CALLING FOR AN INSPECTION. COVER NO WORK UNTIL INSPECTED AND APPROVED.

NEITHER THE HOWARD COUNTY COMMISSIONERS NOR THE HEALTH DEPARTMENT IS RESPONSIBLE FOR THE SUCCESSFUL OPERATION OF ANY SYSTEM.

A 11443

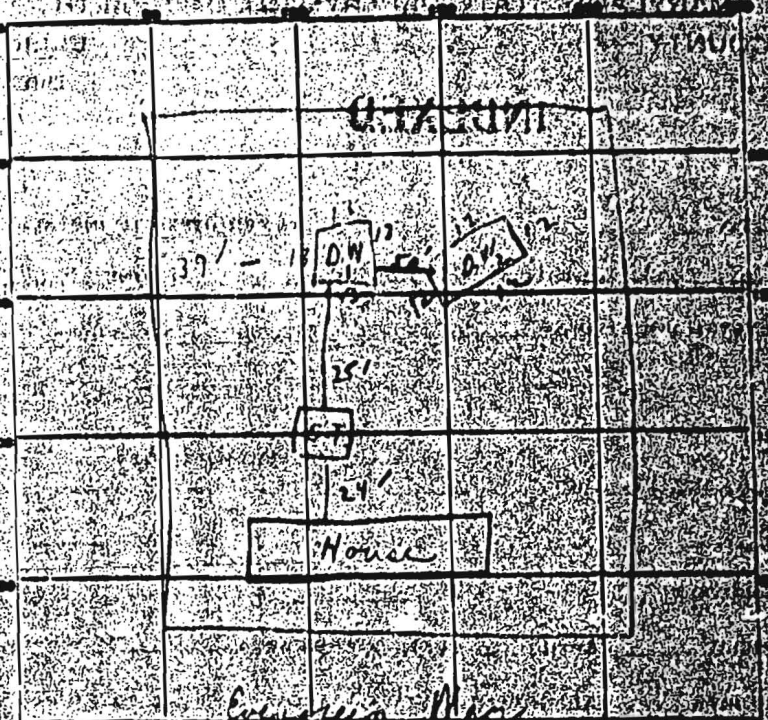

INDICATE HOW TO LOCATE EXISTING STRUCTURES AS SHOWN

PERMIT CARD signed

SEPTIC TANK LEVEL OK CLEANOUTS OK

DISTRIBUTION BOX LEVEL OK

TILE FIELD, DEPTH _____ FT. TRENCH WIDTH _____ FT.

GRAVEL DEPTH _____ IN. TOTAL LENGTH _____ FT.

NUMBER OF TRENCHES _____ TOTAL BOTTOM AREA _____

SEEPAGE PITS: INSIDE DIAMETER _____ FT. DEPTH BELOW INLET _____ FT.

Total ABSORBENT AREA 600 SQ. FT.

REMARKS 7/22/71 Metal septic tank, plastic pipe

Material distributed as per Hold metal septic tank

cleanout was installed according to county code

7/23/71. Cuts now clear out and installed.

DATE SYSTEM APPROVED 7/23/71 INSPECTOR C. Shuck

48
218
312
600