

8/10/81 FILE
P 31530

PERMIT

SEWAGE DISPOSAL SYSTEM

MARYLAND STATE DEPARTMENT OF HEALTH*

HOWARD COUNTY

03-282684

ELLICOTT CITY

DISTRICT 3rd

DATE 8/4/81

INDEX

8/6/81
Contractor
Cancelled - rain @ site
11 A.M. please
CANCELLED UNTIL 2:00-2:30
@ SITE
8/7/81
MACHINE
AM & ROSE

A Repair

Emerson Feaga

IS PERMITTED TO INSTALL _____ ALTER X

ADDRESS Old Frederick Road, Woodstock, Md. 21163 PHONE 465-5167

SUBDIVISION Evergreen Valley Estates ROAD 3218 Evergreen Way LOT _____

PROPERTY OWNER Milton Fadely

ADDRESS 3218 Evergreen Way, Ellicott City, Md. 21043

SPECIFICATIONS

SEPTIC TANK CAPACITY _____ GALLONS

DRAIN FIELD _____ DEPTH _____ FEET, BOTTOM AREA _____ SQ. FT.

DEEP TRENCH 75'-80' ^{LONG} DEPTH 10 1/2 FEET, BOTTOM AREA _____ SQ. FT.

SEEPAGE PITS _____ ABSORBENT SIDE-WALL AREA 450'-480' SQ. FT.

INLET PIPE 4 1/2 FT. BELOW ORIGINAL GRADE. MAXIMUM DEPTH 10 1/2 FT. BELOW ORIGINAL GRADE

EFFECTIVE DEPTH AT 4'-4 1/2 FT. BELOW ORIGINAL GRADE.

LOCATE DISPOSAL AREA _____ FT. FROM _____ LOT LINE AND _____ FT. FROM _____ LOT LINE AS SEEN WHEN

PACING LOT FROM 5' OFF DRYWELL IN AREA AS SHOWN ON BACK OF THIS SHEET

REPAIR - Call for an appointment when ground is opened up so Sanitarian can recommend

the repair system.

1 Trench 75'-80' LONG, 2' WIDE, 6' OF STONE UNDER PIPE

8/6/81 No work on new sewage disposal - rain - Hold for reschedule.

Note: - need approved clearouts to grade on (septic tank) + dry well.

PLANS APPROVED BY CRS. Palmer F. Wine DATE 8/4/81

COVER NO WORK UNTIL INSPECTED AND APPROVED.

NEITHER THE HOWARD COUNTY COUNCIL NOR THE HEALTH DEPARTMENT IS RESPONSIBLE FOR THE SUCCESSFUL OPERATION OF ANY SYSTEM.

NOTE: IF TRENCH IS USED CALL FOR INSPECTION BEFORE PLACING GRAVEL IN TRENCH.

NOTE: NO DRY WELL SHALL EXCEED 15 FOOT IN DIAMETER.


NOTE: ALL PIPE FROM HOUSE TO DISPOSAL AREA MUST BE CAST IRON.

PERMIT VOID AFTER THREE YEARS.

NOTE: INSTALL STAND PIPE ON SEPTIC TANK AND DRY WELL. STAND PIPES MUST BE 8 INCHES IN DIAMETER. CAST IRON, CONCRETE OR TERRA COTTA ACCEPTED.

INSTALLER IS RESPONSIBLE FOR OBTAINING FINAL APPROVAL ON THIS PERMIT.

31530

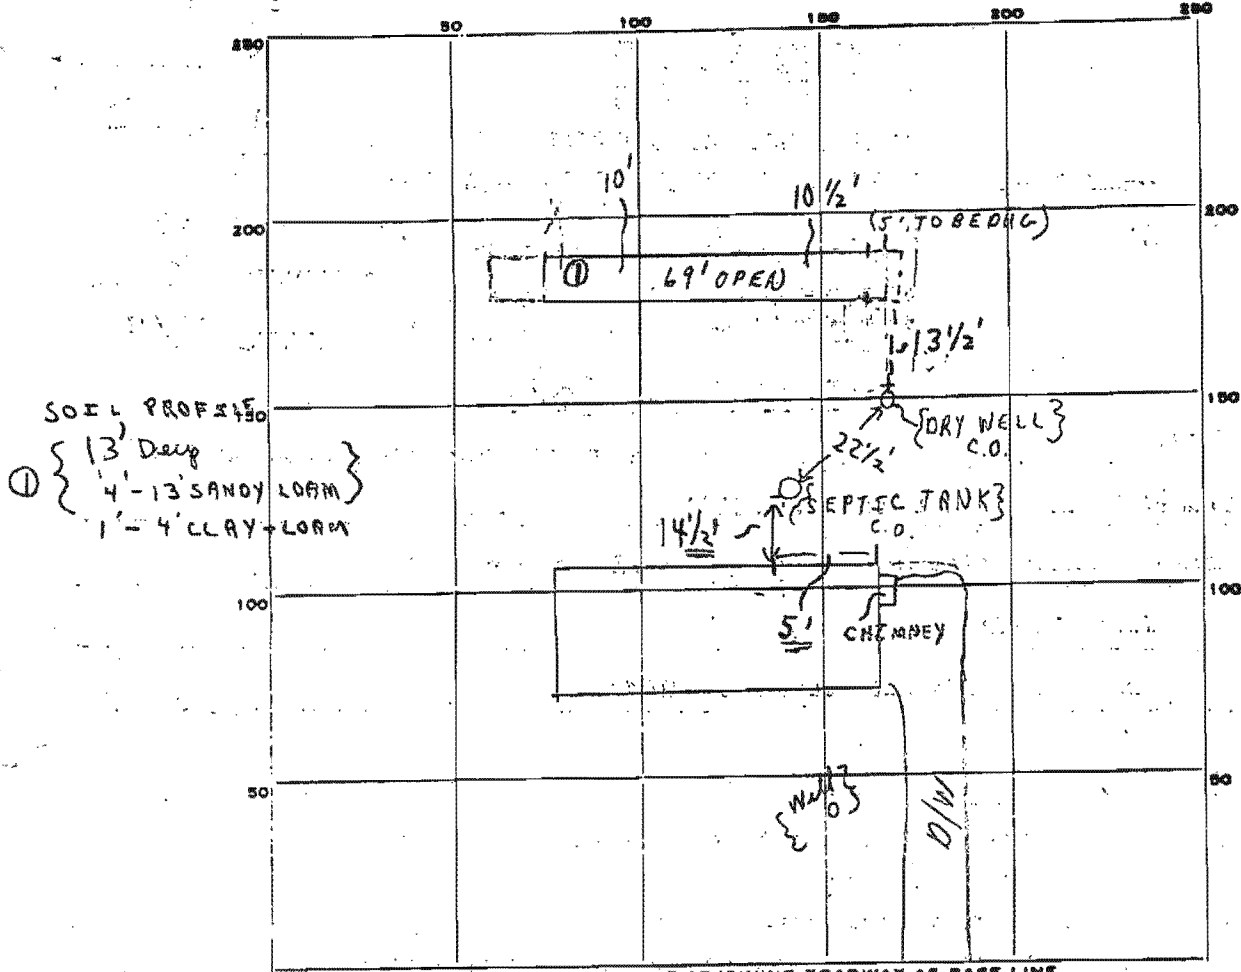

INDICATE NORTH - NAME ADJOINING ROADWAY AS BASE LINE.

EVERGREEN WAY

PERMIT CARD S.T. D.W.

SEPTIC TANK, LEVEL N/A CLEANOUTS

DISTRIBUTION BOX, LEVEL _____

TRENCH TYPE FIELD, DEPTH 10'-10 1/2' FT. TRENCH WIDTH 2 FT. (Need more 6'-11' LENGTH)

GRAVEL DEPTH 1/4" TOTAL LENGTH 69 FT. (open)

NUMBER OF TRENCHES 1 TOTAL BOTTOM AREA _____

SEEPAGE PITS, INSIDE DIAMETER _____ FT. DEPTH BELOW INLET _____ FT.

ABSORBENT AREA _____ SQ. FT.

REMARKS 8/6/81 HOLD FOR RESCHEDULE; 8/7/81 MAN CHECKED - SEPTIC TANK CLEANOUT ON
AND DRY WELL CLEANOUT ON; (1) P.M. - HOLE 13' DEEP DUG, OK FOR TRENCH;
8/7/81 (2) P.M. - TRENCH 69' LONG; OWNER TO VERIFY REST OF TRENCH-LENGTH; DEPTH;
DEPTH OF STONE; TYPE OF PIPE USED PARTIAL, 8/10/81 SYSTEM COVERED - MR FADELY OWNER
CERTIFIED ABOVE - SEE BACK OF ATTACHED PERMIT CARD.

DATE SYSTEM APPROVED 8/10/81 SEE ABOVE INSPECTOR J. Skinner for letter from
Michael [signature]