

DEPARTMENT OF INSPECTIONS,
 LICENSES & PERMITS
 3430 COURT HOUSE DRIVE
 ELLICOTT CITY, MD 21043
 PERMITS (410) 313-2455
 INSPECTIONS (410) 313-1850

**HOWARD COUNTY
 RESIDENTIAL
 HEATING-VENTILATION-AIR
 CONDITIONING AND
 REFRIGERATION PERMIT
 APPLICATION**

HVACR PERMIT # **MI 4001200**
 BUILDING PERMIT #

BUILDING ADDRESS: SUITE/APT:
 SUBDIVISION:
 CENSUS TRACT: SECTION: AREA:
 LOT: TAX MAP: PARCEL:
 BLOCK: ZONE:
 PROPERTY ID: MAP COORDINATES:
 TYPE OF IMPROVEMENTS: USE:

OWNERS NAME: **Ryan Hayleck**
 ADDRESS: **11705 wayneridge street**
 CITY: **Fulton**
 STATE: **MD** ZIP CODE: **20759**
 HOME PHONE: **240-994-2535** WORK PHONE:

CHECK ONE	HOW MANY
SINGLE FAMILY DWELLING <input checked="" type="checkbox"/>	<u>1</u> ZONES
SINGLE FAMILY TOWNHOUSE <input type="checkbox"/>	___ ZONES
MULTI-FAMILY / HOTEL/MOTEL <input type="checkbox"/>	___ ROOMS
ASSISTED LIVING HOMES (16 OR FEWER RESIDENTS) <input type="checkbox"/>	___ ROOMS

COMPANY NAME: **Ground Loop Heating & Air Cond., Inc.**
 LICENSEE NAME: **Michael E. Cullum**
 ADDRESS: **1701 Whiteford Road**
 CITY: **Darlington**
 STATE: **MD** ZIP CODE: **21034**
 PHONE: **410-836-1706** HVACR LICENSE NO: **6539**

1/28/15 Approved

EQUIPMENT:
WATER FURNACE 3 TON
NVVO3

New
 Heating and Air Conditioning
 Geo Thermal System
 Heating System Only
 Ductless Mini Splits
 Other Work (Describe):
 Thru The Wall Systems

Replacement
 Heating
 Air Conditioning
 Heating and Air Conditioning
 Additions and Alterations
 Heating
 Air Conditioning
 Heating and Air Conditioning

****Replacement Geo Thermal Systems are not required; However, if a tax credit is being sought a permit is required****

Zones
 Permit Fee = # of Zones x \$40 = 40.00
 Technology Fee (10% of Permit Fee) = 4.00
 Plus Application Fee 50.00
 Total Fees Due = 94.00

Rooms
 Permit Fee = # of Rooms x \$80 = _____
 Technology Fee (10% of Permit Fee) = _____
 Plus Application Fee \$50 50.00
 Total Fees Due = _____

I HAVE CAREFULLY EXAMINED AND READ THIS APPLICATION AND KNOW IT IS TRUE AND CORRECT. THE WORK DESCRIBED HEREIN WILL BE PERFORMED BY A STATE HVACR LICENSED PERSON(S), AND ALL WORK WILL BE PERFORMED IN COMPLIANCE WITH APPLICABLE CODES AND STANDARDS OF HOWARD COUNTY THE STATE OF MARYLAND.

Michael Cullum
 SIGNATURE OF LICENSEE
 DATE 11/22/14
MICHAEL CULLUM
 PRINT NAME OF LICENSEE
linda @ ground loop . com
 Email Address

Validation
 Check Number: 22429
 Cash: _____
 Receipt Number: 384757



Make check payable to: DIRECTOR OF FINANCE OF HOWARD COUNTY

WELL or SEPTIC

M14001200

WAYNERIDGE STREET

S 74°35'40" E
125.00

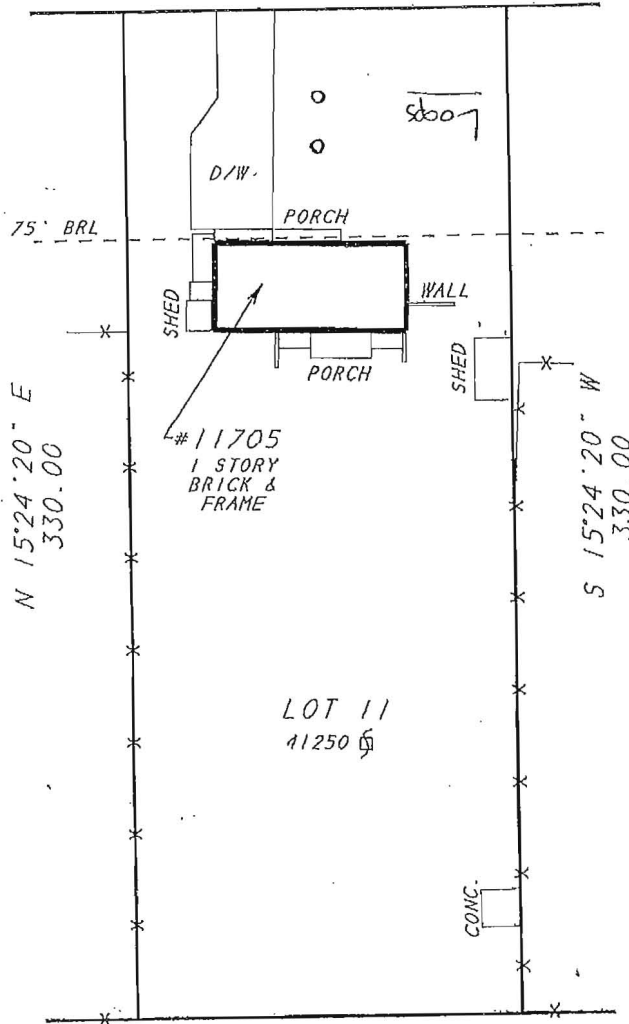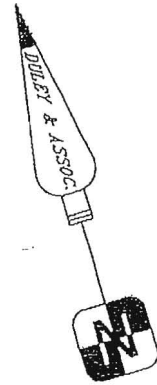

LOT 11
41250

N 74°35'40" W
125.00

LOCATION DRAWING OF:

***11705 WAYNERIDGE STREET**

LOT 11 BLOCK B

PLAT TWO

MOORESFIELD

PLAT BOOK 2 PAGE 10

A LAND SURVEYING COMPANY



DULEY

AND

ASSOCIATES INC

