

APPLICATION

A 24522

SEWAGE DISPOSAL TESTING

P _____

STATE OF MARYLAND - DEPARTMENT OF HEALTH AND MENTAL HYGIENE

HOWARD COUNTY HEALTH DEPARTMENT
ENVIRONMENTAL HEALTH SERVICES
P. O. BOX 476, ELLICOTT CITY, MARYLAND 21043
TELEPHONE: 845-3000, EXT. 356

DISTRICT 5

DATE 3-15-76

man depth of system - 11 ft

TO: THE COUNTY HEALTH OFFICER
ELLICOTT CITY, MARYLAND

BLDG. PERMIT SIGNED
AND RETURNED 3/14/76

Serial # 45610

I, HEREBY, APPLY FOR THE NECESSARY TEST IN ORDER TO CONSTRUCT (OR RECONSTRUCT) A SEWAGE DISPOSAL SYSTEM.

PROPERTY OWNER Henry Dwyfios, III F.G. Markon, Inc

ADDRESS 4701 Sangamore Road, Washington, D.C. 20016 PHONE 229-5052

Landover, Md 20881

PROPERTY LOCATION:

SUBDIVISION 7516 Flamewood LOT NO. NEW LOT 4-D
6, Block B

ROAD AND DESCRIPTION _____

SIZE OF LOT 50,350 TYPE BLDG. (4)
NUMBER OF BEDROOMS

IF NOT SINGLE RESIDENCE DESCRIBE _____

THE SYSTEM INSTALLED UNDER THIS APPLICATION IS ACCEPTABLE ONLY UNTIL PUBLIC FACILITIES BECOME AVAILABLE.

SIGNATURE OF APPLICANT Henry Dwyfios III


APPROVED BY William W. Zapp FOR DW & trench DATE 1/10/78
(KIND OF SYSTEM)

REJECTED BY _____ FOR _____ DATE _____
(KIND OF SYSTEM)

HOLD PENDING FURTHER TESTS _____ DATE _____

REASONS FOR REJECTION OR HOLDING _____

THIS IS NOT A PERMIT

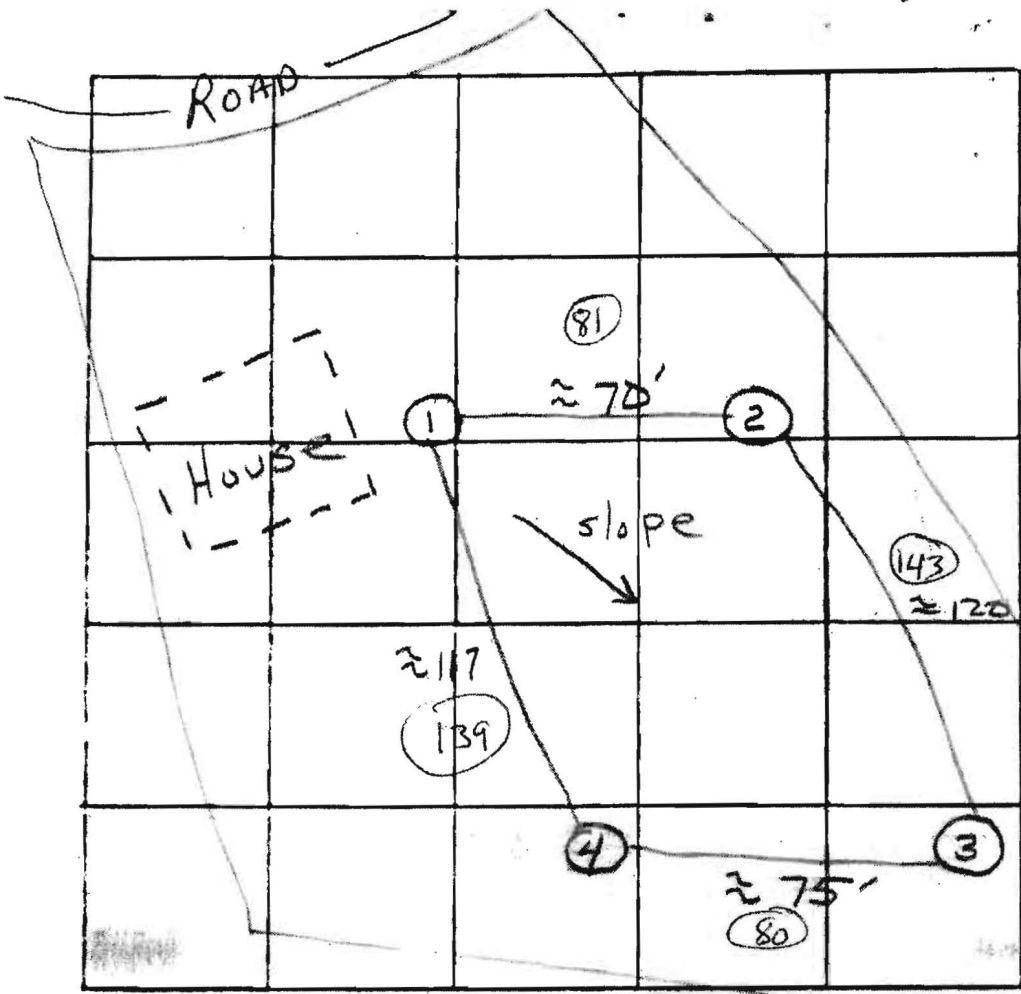

Lot 6
D

INDICATE NORTH - NAME ADJOINING ROADWAY AS BASE LINE.

Elevation

	DATE	TEST NO.	DEPTH	PRE-WET		TEST - 1" DROP		TIME
				START	STOP	START	STOP	
high	4/23/76	1 V	12	similar soil - dry				
low		2	6.5	11:15	11:17	11:17	11:20	3
		2	12	11:15	11:16	11:16	11:17	1
low		3 S	7	11:00	11:02	11:02	11:06	4
		3 D	13	11:00	11:06	11:06	11:12	6
High		4 S	13	11:04	11:07	11:07	11:16	9
	4/23/76	4 D	7	11:04	11:06	11:06	11:30	24m

REMARKS see plat for additional info
 TYPE OF SOIL SANDY - MICHA
 TESTED BY hal benson & P.H. ALSO PRESENT: Fyock-Baines