

4/9/76
6/11/76

PERMIT

P 23308
A 15945

SEWAGE DISPOSAL SYSTEM

MARYLAND STATE DEPARTMENT OF HEALTH

HOWARD COUNTY

ELLICOTT CITY

DISTRICT 3rd

INDEXED

DATE 5/25/76

Jim Brittingham

IS PERMITTED TO INSTALL ALTER

ADDRESS 3004 N. Rogers Avenue, Ellicott City, Md. 21043 PHONE 461-1870

A SEWAGE DISPOSAL SYSTEM LOCATED AT

SUBDIVISION Everlea ROAD Everlea Road LOT 7, Blk.A, Sec.3

PROPERTY OWNER Everett Ramsburg

ADDRESS 185 Henryton Road, Marriottsville, Maryland 21104 Phone: 328-2696

SPECIFICATIONS 3 bedrooms

DRAIN FIELD _____ DEPTH _____ FEET, BOTTOM AREA _____ SQ. FT.

SEEPAGE PITS _____ ABSORBENT SIDE-WALL AREA _____ SQ. FT.

SEPTIC TANK CAPACITY 1000 GALLONS

FOR GARBAGE GRINDER, INCREASE DISPOSAL AREA 25% & TANK CAPACITY 50%.

OTHER DRY WELL - 360 sq. ft. sidewall area below inlet. Dry well inlet to be 4 ft. deep and bottom of dry well to be 11 ft. deep. If septic tank is over 3 ft. deep install manhole to ground surface. Place the dry well 170 ft. from the back lot line and 30 ft. Y. on the right side of the lot as seen when facing the lot from Everlea Drive.

NOTE: ALL PIPE FROM HOUSE TO DISPOSAL AREA MUST BE CAST IRON.

PERMIT VOID AFTER THREE YEARS.

NOTE: INSTALL STAND PIPE ON SEPTIC TANK AND DRY WELL. STAND PIPES MUST BE 6 INCHES IN DIAMETER. CAST IRON, CONCRETE OR TERRA COTTA ACCEPTED.

PLANS APPROVED BY Raymond Hodges DATE 4/18/75

FILL SEPTIC TANK AND DISTRIBUTION BOX WITH WATER BEFORE CALLING FOR AN INSPECTION. COVER NO WORK UNTIL INSPECTED AND APPROVED.

NEITHER THE HOWARD COUNTY COMMISSIONERS NOR THE HEALTH DEPARTMENT IS RESPONSIBLE FOR THE SUCCESSFUL OPERATION OF ANY SYSTEM.

15945

DATE SYSTEM APPROVED

INSPECTOR

6/11/76
W. J. ...

OTHER THINGS CORRECTED

6/11/76 - 10' DEEP DITCH AND DEW

INSTALLING PIPE FROM ST. DW. W2+HB ALSO DITCH DEW

2) Manhole to grade right on ST. 3) Re-concrete co. on DW. Finish

It short in DW

ABSORBENT AREA 300 SQ. FT. IN DW

SEEPAGE PITS, INSIDE DIAMETER FT. DEPTH BELOW INLET

NUMBER OF TRENCHES TOTAL BOTTOM AREA

GRAVEL DEPTH IN TOTAL LENGTH FT.

TILE FIELD, DEPTH FT. TRENCH WIDTH FT.


DISTRIBUTION BOX, LEVEL

SEPTIC TANK, LEVEL CLEANOUTS

PERMIT CARD

OK
ST
DW
MANHOLE

INDICATE NORTH - MAKE ADJOINING ROADWAY AS BASE LINE

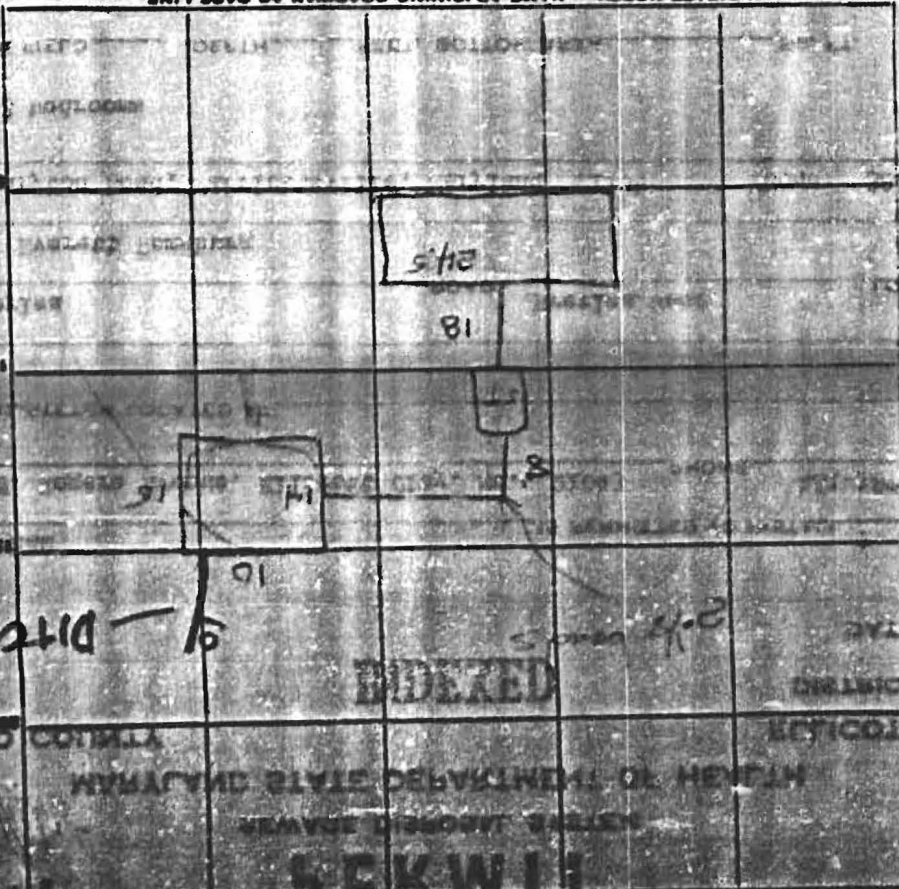

INDEXED

PERMIT

STATE DEPARTMENT OF HEALTH

NEW YORK STATE DEPARTMENT OF HEALTH

NEW YORK STATE DEPARTMENT OF HEALTH