

APPLICATION

A 09640

SEWAGE DISPOSAL TESTING

P _____

MARYLAND STATE DEPARTMENT OF HEALTH

HOWARD COUNTY

ELLICOTT CITY

Septic Tank - 3 bedrooms - 750 gal
" " " " - 1000 gal

DISTRICT 3

Day well - 400 sq ft ^{tile field} ~~below~~ ~~in~~ ~~at~~ ~~pipe~~ ~~for~~ ~~bedroom~~
~~Under~~ ~~at~~ ~~below~~ ~~grade~~

DATE 2/17/65

Place ^{tile field} ~~Day well~~ 166 ft from front lot line and 45 ft from right
sideline as seen when flying lot from Evergreen Way

All charges P. J. W. - 4/18/67

TO: THE COUNTY HEALTH OFFICER
ELLICOTT CITY, MARYLAND

I, HEREBY, APPLY FOR THE NECESSARY TESTS IN ORDER TO CONSTRUCT (OR RECONSTRUCT) A SEWAGE DISPOSAL SYSTEM.

PROPERTY OWNER Hudson Construction Company, Inc.

ADDRESS 363 Chapel Avenue, Ellicott City, Md. PHONE HO 5-2205

PROPERTY LOCATION:

SUBDIVISION Evergreen Valley Estates LOT NO. 8 Sec. 4

ROAD AND DESCRIPTION Evergreen Way

OCCUPANT _____ PHONE _____

PERSON TO CONSTRUCT SYSTEM _____

ADDRESS _____ PHONE _____

SIZE OF LOT 43,750 sq. ft. TYPE BLDG. 3 or 4
NUMBER OF BEDROOMS

IF NOT SINGLE RESIDENCE DESCRIBE _____

SIGNATURE OF APPLICANT /s/ Madeline Leonardi


APPROVED BY J. Halmore FOR Day Well DATE 6-2-65
(KIND OF SYSTEM)

REJECTED BY _____ FOR _____ DATE _____
(KIND OF SYSTEM)

HOLD PENDING FURTHER TESTS _____ DATE _____

REASONS FOR REJECTION OR HOLDING _____

THIS IS NOT A PERMIT

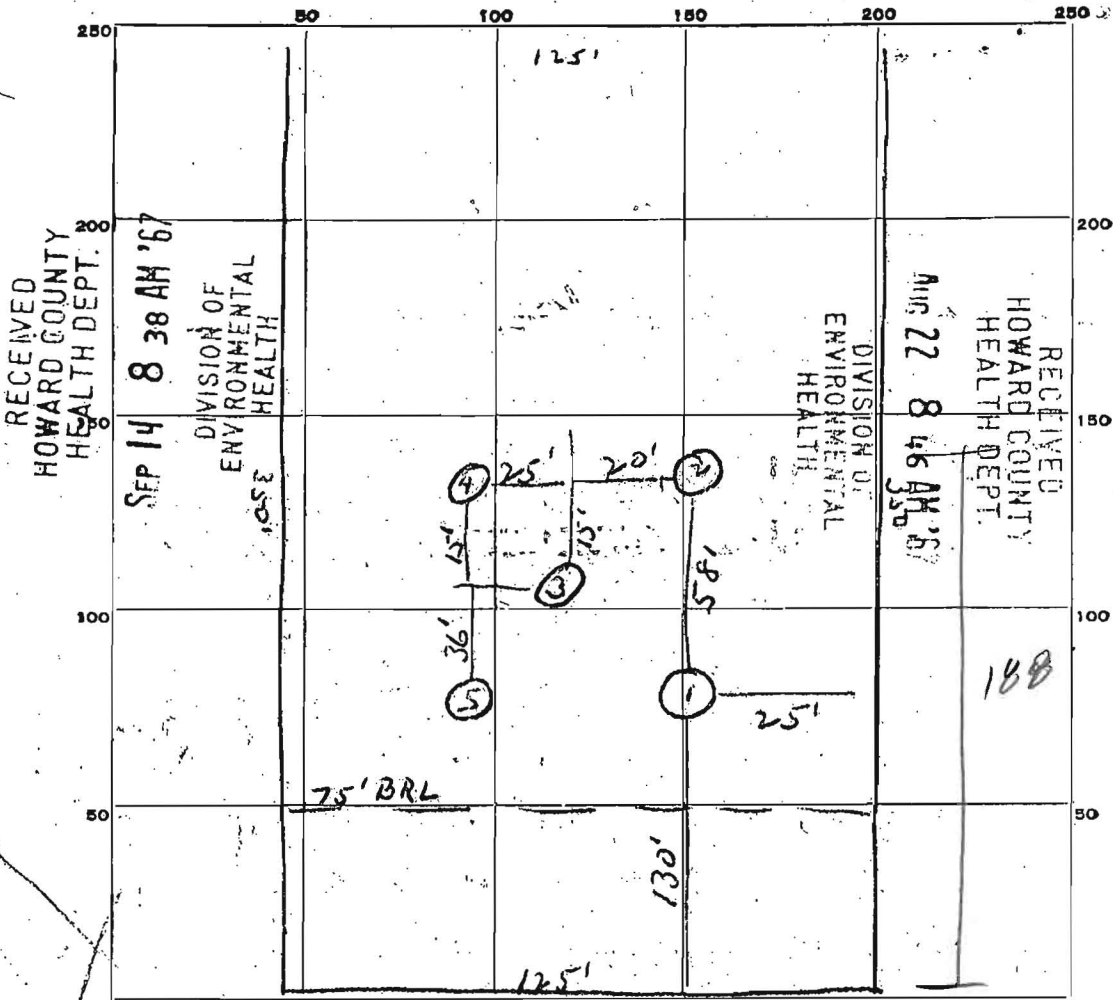

RECEIVED
HOWARD COUNTY
HEALTH DEPT.
SEP 14 8 38 AM '67

DIVISION OF
ENVIRONMENTAL
HEALTH

DIVISION OF
ENVIRONMENTAL
HEALTH

RECEIVED
HOWARD COUNTY
HEALTH DEPT.
AUG 22 8 46 AM '67

INDICATE NORTH. - NAME ADJOINING ROADWAY AS BASE LINE.

EVERGREEN WAY

DATE	TEST NO.	DEPTH	PRE-WET		TEST - 1" DROP		TIME
			START	STOP	START	STOP	
2/19/65	1	5'	11:17	11:25	11:25	11:34	9
"	2	5'	11:20	11:22	11:22	11:24	2
"	3	11'	11:32	11:33	11:33	11:35	2
"	4	5'	11:25	11:26	11:26	11:27	1
"	5	5'	11:27	11:30	11:30	11:34	4

Same as
repair
trench
bottom

SOIL AUGER FINDING

TESTED BY

JHR

REMARKS

See notes on p. 4