

# APPLICATION

A 22909

## SEWAGE DISPOSAL TESTING

P \_\_\_\_\_

STATE OF MARYLAND - DEPARTMENT OF HEALTH AND MENTAL HYGIENE

HOWARD COUNTY HEALTH DEPARTMENT  
ENVIRONMENTAL HEALTH SERVICES  
P. O. BOX 476, ELLICOTT CITY, MARYLAND 21043  
TELEPHONE: 465-5000, EXT. 356

DISTRICT 3<sup>RD</sup>

DATE 2/25/76

TO: THE COUNTY HEALTH OFFICER  
ELLICOTT CITY, MARYLAND

I, HEREBY, APPLY FOR THE NECESSARY TEST IN ORDER TO CONSTRUCT (OR RECONSTRUCT) A SEWAGE DISPOSAL SYSTEM.

PROPERTY OWNER G.R. KNAPP

ADDRESS 8816 BESTHOLD GARTH COLUMBIA PHONE 997-2656  
(953-700 X 72391 BUS.)

PROPERTY LOCATION:

SUBDIVISION BEHIND GREENHEDGE LOT NO. BEHIND LOT 29

ROAD AND DESCRIPTION END OF EVERGREEN CT; OFF OF EVERGREEN WAY  
WHICH IS ABOUT 1 MILE S. OF RT 144 ON TRIADELPHIA RD

SIZE OF LOT 5.25 A TYPE BLDG. SINGLE FAMILY 4 BDRM  
NUMBER OF BEDROOMS

IF NOT SINGLE RESIDENCE DESCRIBE \_\_\_\_\_

THE SYSTEM INSTALLED UNDER THIS APPLICATION IS ACCEPTABLE ONLY UNTIL PUBLIC FACILITIES BECOME AVAILABLE.

SIGNATURE OF APPLICANT [Signature]


APPROVED BY \_\_\_\_\_ FOR \_\_\_\_\_ DATE \_\_\_\_\_  
(KIND OF SYSTEM)

REJECTED BY \_\_\_\_\_ FOR \_\_\_\_\_ DATE \_\_\_\_\_  
(KIND OF SYSTEM)

HOLD PENDING FURTHER TESTS \_\_\_\_\_ DATE \_\_\_\_\_

REASONS FOR REJECTION OR HOLDING \_\_\_\_\_

# THIS IS NOT A PERMIT

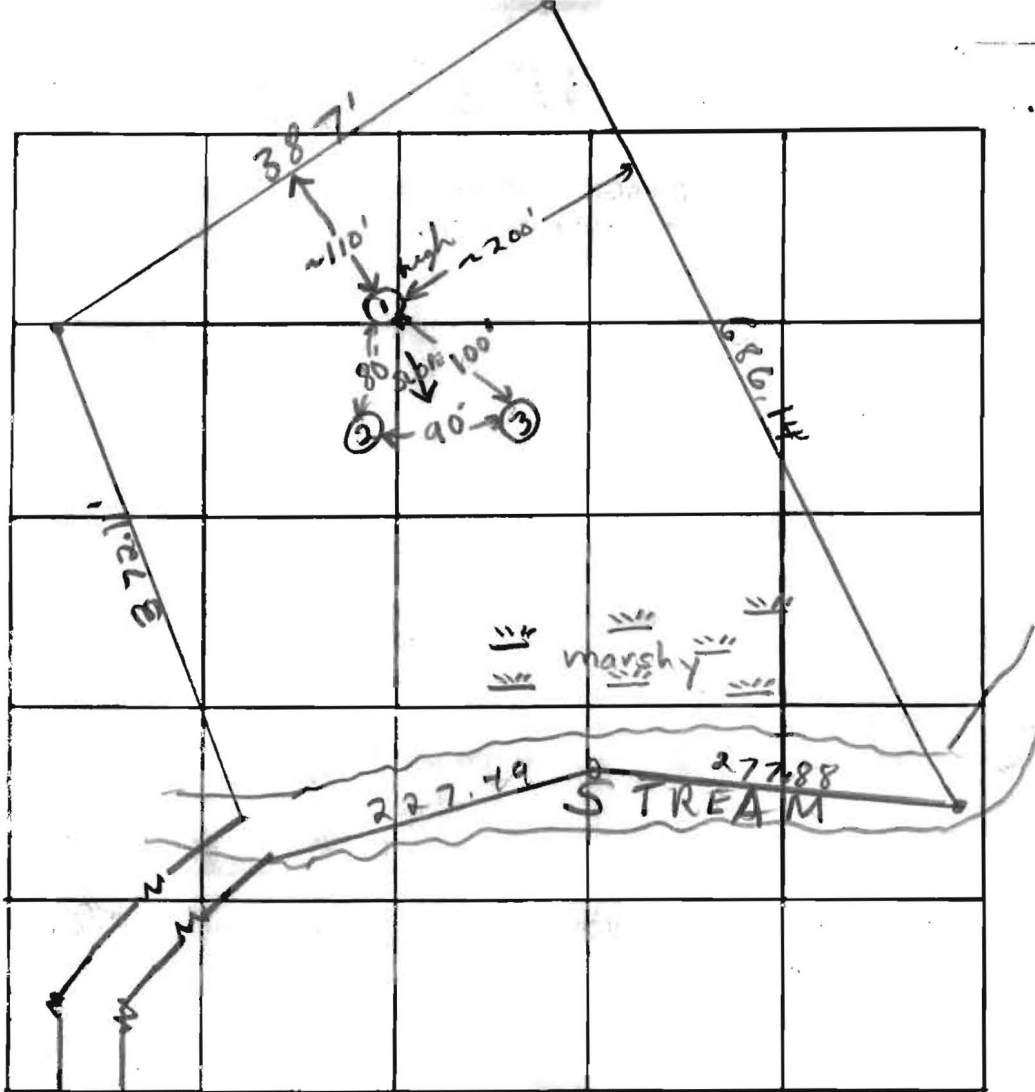

INDICATE NORTH. - NAME ADJOINING ROADWAY AS BASE LINE.

Evergreen Way

DATE	TEST NO.	DEPTH	PRE-WET		TEST - 1" DROP		TIME
			START	STOP	START	STOP	
3/19/76	1 high	12'	Water at 12'		clayey to 3'		silty loam below
	2	6'	Water at 6'				
	3	10'	Water at 10'				

REMARKS

TYPE OF SOIL

*silty-sandy loam below top ~ 3-4 clayey soil*

TESTED BY

*F.S.*

ALSO PRESENT:

*Mr. Knapp*

Fill out in triplicate.  
Make \$30.00 check payable:  
Howard County Health Dept. - Sanitation

# APPLICATION

A 22909

P \_\_\_\_\_

*Preliminary*

*4-13' holes  
on 10,000 ft.*

SEWAGE DISPOSAL TESTING

STATE OF MARYLAND - DEPARTMENT OF HEALTH AND MENTAL HYGIENE

DISTRICT ✓ 3RD

DATE ✓ 2/25/76

*3/19/76  
9:30*

HOWARD COUNTY HEALTH DEPARTMENT  
ENVIRONMENTAL HEALTH SERVICES  
P. O. BOX 476, ELLICOTT CITY, MARYLAND 21043  
TELEPHONE: 465-5000, EXT. 356

TO: THE COUNTY HEALTH OFFICER  
ELLICOTT CITY, MARYLAND

I, HEREBY, APPLY FOR THE NECESSARY TEST IN ORDER TO CONSTRUCT (OR RECONSTRUCT) A SEWAGE DISPOSAL SYSTEM.

PROPERTY OWNER ✓ G.R. KNAPP

ADDRESS ✓ 8816 BESTHOLD GARTH <sup>21045</sup> COLUMBIA PHONE ✓ 997-2656

PROPERTY LOCATION:

SUBDIVISION ✓ BEHIND GREENHEDGE LOT NO. ✓ BEHIND LOT 29

ROAD AND DESCRIPTION *direction* END OF EVERGREEN CT.; OFF OF EVERGREEN WAY  
WHICH IS ABOUT 1 MILE S. OF RT 144 ON TRIADELPHIA RD.

SIZE OF LOT ✓ 5.25 A (including pipe stem) TYPE BLDG. ✓ SINGLE FAMILY 4 BDRM  
NUMBER OF BEDROOMS

IF NOT SINGLE RESIDENCE DESCRIBE \_\_\_\_\_

THE SYSTEM INSTALLED UNDER THIS APPLICATION IS ACCEPTABLE ONLY UNTIL PUBLIC FACILITIES BECOME AVAILABLE.

SIGNATURE OF APPLICANT *[Signature]*

APPROVED BY \_\_\_\_\_ FOR \_\_\_\_\_ DATE \_\_\_\_\_  
(KIND OF SYSTEM)

REJECTED BY \_\_\_\_\_ FOR \_\_\_\_\_ DATE \_\_\_\_\_  
(KIND OF SYSTEM)

HOLD PENDING FURTHER TESTS \_\_\_\_\_ DATE \_\_\_\_\_

REASONS FOR REJECTION OR HOLDING 3/22/76 Failed perc test in area tested F.S.

# THIS IS NOT A PERMIT


INDICATE NORTH - NAME ADJOINING ROADWAY AS BASE LINE.

DATE	TEST NO.	DEPTH	PRE-WET		TEST - 1" DROP		TIME
			START	STOP	START	STOP	

REMARKS \_\_\_\_\_

TYPE OF SOIL \_\_\_\_\_

TESTED BY \_\_\_\_\_ ALSO PRESENT: \_\_\_\_\_

March 22, 1976

Mr. G. R. Knapp  
8816 Besthold Garth  
Columbia, Maryland 21045

Dear Mr. Knapp:

This is to advise that the percolation test run on your property located at the end of Evergreen Court on March 19, 1976 failed the percolation tests in the area tested.

Very truly yours,

Frank Skinner,  
Sanitarian

FS:hs

SEALED WITH STRIPS  
SOUTH-WESTERN COMPANY  
ECONOMY 2-LINE BOND

