



APPLICATION

FOR PERCOLATION TESTING AND SITE EVALUATION

TEST DATE(S) _____ TEST TIME _____

AP 544533

AGENCY REVIEW: _____

DATE 2-13-13

DO NOT WRITE ABOVE THIS LINE

I HEREBY APPLY FOR THE NECESSARY TESTING/EVALUATION PRIOR TO ISSUANCE OF SEWAGE DISPOSAL SYSTEM PERMIT(S) TO:

CHECK AS NEEDED:

- CONSTRUCT NEW SEPTIC SYSTEM(S)
- REPAIR/ADD TO AN EXISTING SEPTIC SYSTEM
- REPLACE AN EXISTING SEPTIC SYSTEM

CHECK AS NEEDED:

- NEW STRUCTURE(S)
- ADDITION TO AN EXISTING STRUCTURE
- REPLACE AN EXISTING STRUCTURE

CHECK ONE:

- CREATE NEW LOT(S)
- BUILD ON AN EXISTING LOT IN A SUBDIVISION
- BUILD ON AN EXISTING PARCEL OF RECORD

IS THE PROPERTY WITHIN 2500' OF ANY RESERVOIR?

- YES
- NO

THE TYPE OF STRUCTURE IS:

- RESIDENTIAL WITH UNKNOWN PROPOSED BEDROOMS IN THE COMPLETED STRUCTURE (NOTE **UNKNOWN** IF APPROPRIATE)
- COMMERCIAL (PROVIDE DETAIL OF NUMBERS AND TYPES OF EMPLOYEES/ CUSTOMERS ON ACCOMPANYING PLAN)
- INSTITUTIONAL/GOVERNMENT (PROVIDE DETAIL OF NUMBERS AND TYPES OF EMPLOYEES/USERS ON ACCOMPANYING PLAN)

PROPERTY OWNER(S) Joseph T. Judd & Norma S. Judd

DAYTIME PHONE 252-636-8362 CELL _____ FAX _____

MAILING ADDRESS 117 Friburg Rd. New Bern NC 28562
STREET CITY/TOWN STATE ZIP

APPLICANT Vistas Homebuilders LLC

DAYTIME PHONE 410-259-4195 CELL 410-259-4195 FAX 410-552-6710

MAILING ADDRESS 1935 Babbs Ct. Marriottsville MD 21104
STREET CITY/TOWN STATE ZIP

APPLICANT'S ROLE: DEVELOPER BUILDER BUYER RELATIVE/FRIEND REALTOR CONSULTANT

PROPERTY LOCATION
SUBDIVISION/PROPERTY NAME Woodmark LOT NO. _____



PROPERTY ADDRESS Etchison Road Ellicott City
STREET TOWN/POST OFFICE

TAX MAP PAGE(S) 23 GRID 0001 PARCEL(S) 0106 PROPOSED LOT SIZE 2.787ac

AS APPLICANT, I UNDERSTAND THE FOLLOWING: THE SYSTEM INSTALLED SUBSEQUENT TO THIS APPLICATION IS ACCEPTABLE ONLY UNTIL PUBLIC SEWERAGE IS AVAILABLE. THIS APPLICATION IS COMPLETE WHEN ALL APPLICABLE FEES AND A SUITABLE SITE PLAN HAVE BEEN RECEIVED. I ACCEPT THE RESPONSIBILITY FOR COMPLIANCE WITH ALL M.O.S.H.A. AND "MISS UTILITY" REQUIREMENTS. APPROVAL IS BASED UPON SATISFACTORY REVIEW OF A PERC CERTIFICATION PLAN.

TEST RESULTS WILL BE MAILED TO APPLICANT. [Signature] SIGNATURE OF APPLICANT

HOWARD COUNTY HEALTH DEPARTMENT, BUREAU OF ENVIRONMENTAL HEALTH, WELL AND SEPTIC PROGRAM
7178 COLUMBIA GATEWAY DRIVE COLUMBIA, MARYLAND 21046 (410) 313-2640 FAX (410) 313-2648
TDD (410) 313-2323 TOLL FREE 1-877-4MD-DIIMH

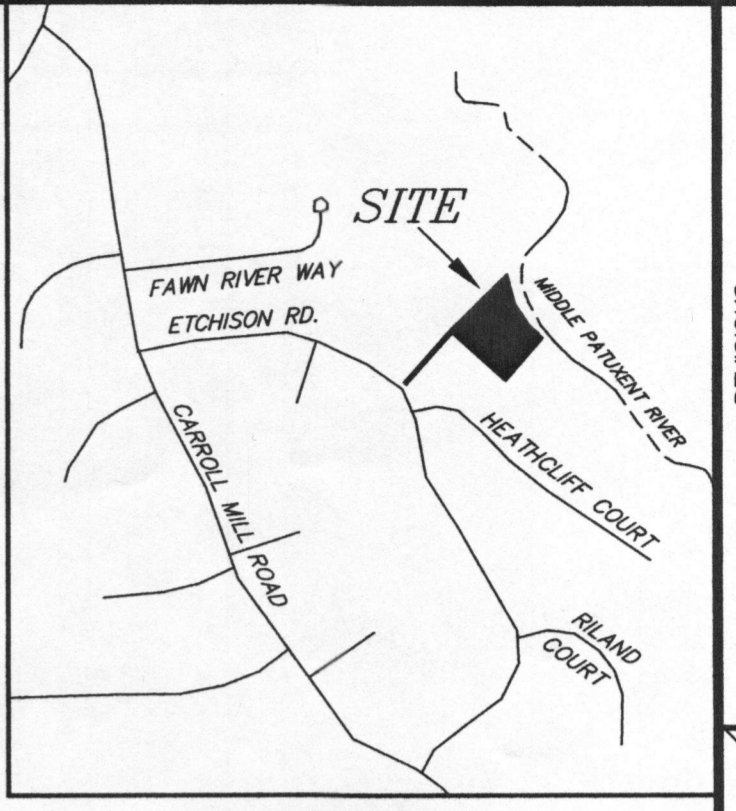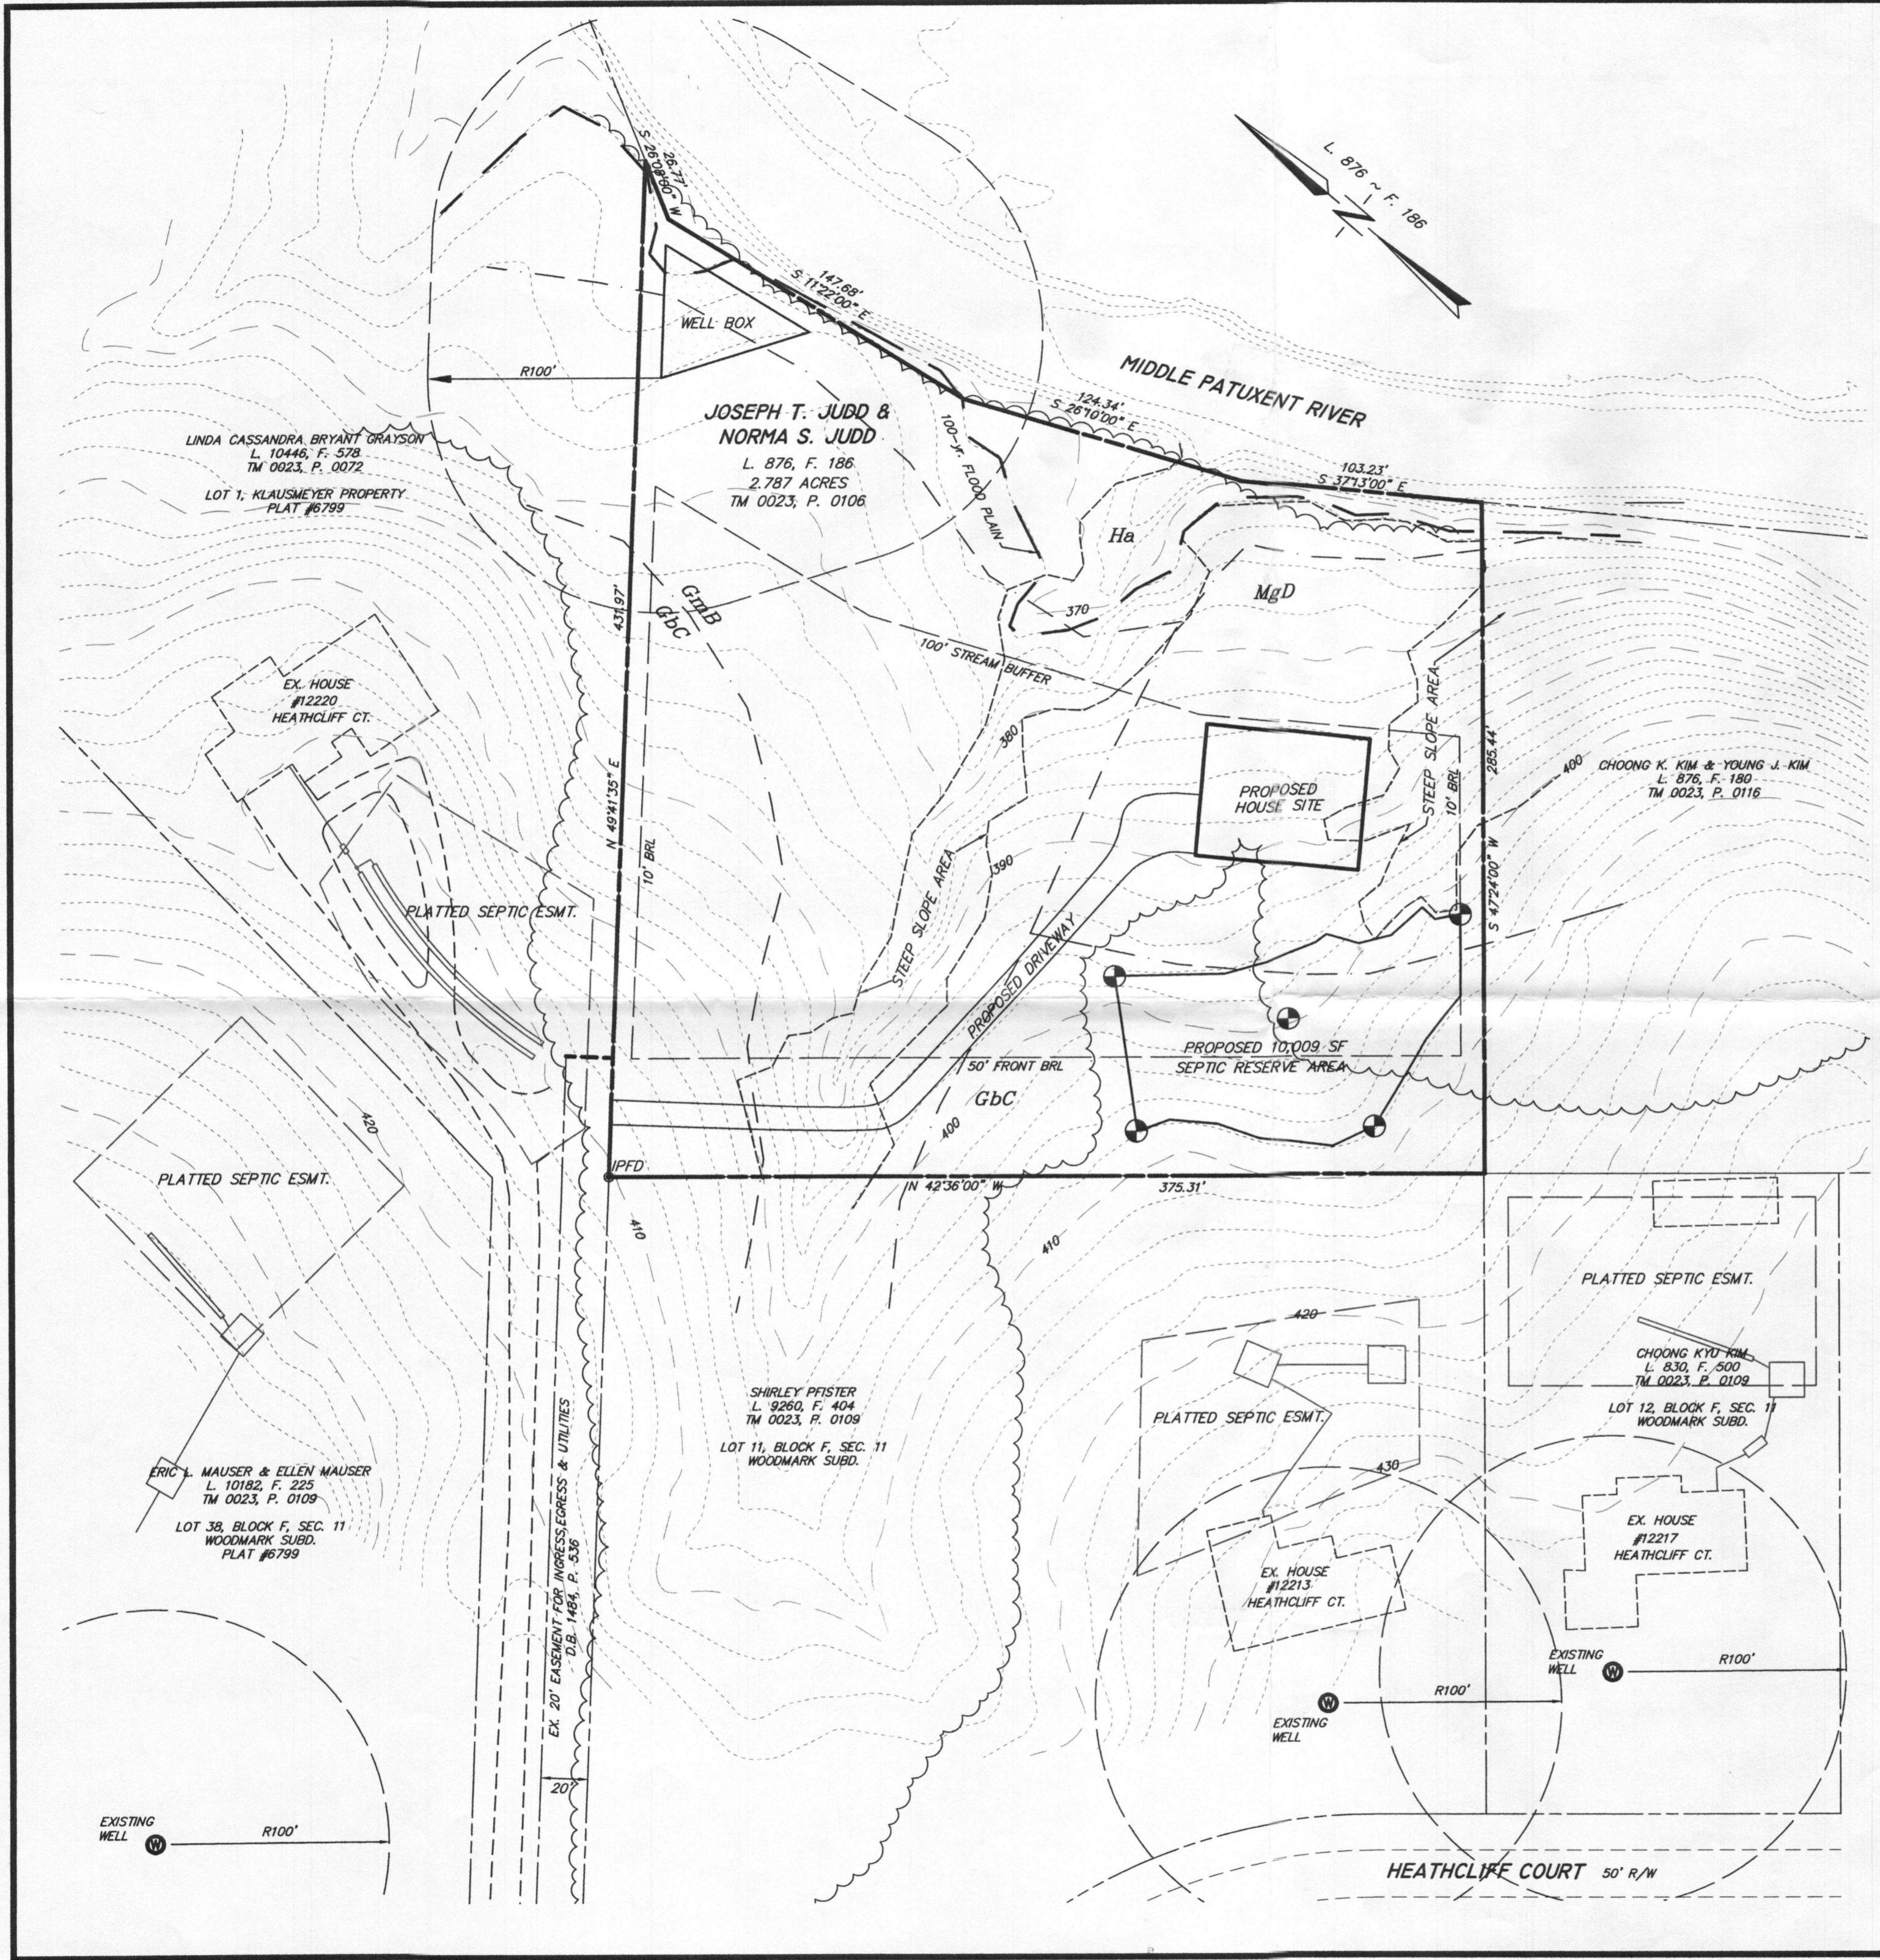

VICINITY MAP
1" = 1000'±

NOTES:

1. This plat has been prepared without the benefit of a title report and does not necessarily indicate all encumbrances on the subject property.
2. Boundary information shown hereon is taken from public records, and has not been field verified by this firm.
3. Topography shown hereon is from Howard County GIS, dated spring 2011. Contour interval is 2'.
4. Septic information received from Howard County Health Department and transferred to the best of the ability of Lavelle & Associates.

OWNER:

JOSEPH T. JUDD &
NORMA S. JUDD
117 FRIBURG RD.
NEW BERN, NC 28562

DEVELOPER:

VISTA HOMEBUILDERS LLC
MARK FRIZZERA
1935 BABBS COURT
MARRIOTTVILLE, MD 21104
410-259-4195



Daniel P. Lavelle
License Exp. / Renewal
Date: 4/1/2014

MAP LEGEND

- ⊕ PROPOSED TEST PIT LOCATION

- REVISIONS
- 1) Plan revised per Health Department comments dated March 4, 2013. (BJA)
 - 2) Plan revised per Health Department comments dated April 17, 2013. (BJA)

LAVELLE & ASSOCIATES
INCORPORATED

PLANNERS • SURVEYORS

5732 INDUSTRY LANE, FREDERICK, MARYLAND 21704
TEL: (301) 695-9722; FAX: (301) 695-9766

PERCOLATION TEST SITE PLAN

ON THE PROPERTY OF
JOSEPH T. JUDD & NORMA S. JUDD

L. 876, F. 186
3rd ELECTION DISTRICT
HOWARD COUNTY, MARYLAND
TAX MAP 0023, PARCEL 0106

DATE: JANUARY 30, 2013

SCALE: 1" = 50'


PROJ. No. 13-001

FILE: \LP3\JUDD\Wks-Judd.dwg

DRAWN: RSL

PAGE 1

OF 1

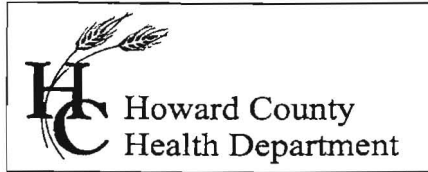

7178 Columbia Gateway Drive, Columbia MD 21046
(410) 313-2640 Fax (410) 313-2648
TDD (410) 313-2323 Toll Free 1-866-313-6300
website: www.hchealth.org

Maura J. Rossman, M.D. Health Officer

MEMORANDUM

TO: Lavelle & Associates, Inc.

FROM: Heidi Scott
Well and Septic Program
Development Coordination Section

RE: Percolation Test Site Plan
Judd Property
Etchison Road – Tax Map 23, Parcel 106

DATE: April 17, 2013

The following comments apply to the above referenced plan. These comments must be addressed prior to scheduling of percolation testing:

- Revise the wellbox location per the attached markup. This location is recommended by this office due to the depths and age of the septic systems located upgradient at 12213 and 12217 Healthcliff Court.
- Revise the proposed septic reserve area per the markup. The house location and driveway must be relocated to accommodate the new wellbox and septic reserve area locations.

Cc:
File