

PUB. SEWER STATUS VERIFIED BY _____

ISSUE DATE: _____

APPROVAL DATE: _____

PERMIT INDEXED

P 519049-F

A Re-indexed

ON-SITE SEWAGE DISPOSAL SYSTEM HOWARD COUNTY HEALTH DEPARTMENT BUREAU OF ENVIRONMENTAL HEALTH

05-371015

IS PERMITTED TO INSTALL ALTER

ADDRESS: _____ PHONE NUMBER: _____

SUBDIVISION: Beaverbrook LOT NUMBER: 7

ADDRESS: 5034 East Durham Road PROPERTY OWNER: Charles Daniels

SEPTIC TANK CAPACITY (GALLONS): _____

PUMP CHAMBER CAPACITY (GALLONS): _____

NUMBER OF BEDROOMS: _____

SQUARE FEET PER BEDROOM: _____

LINEAR FEET OF TRENCH REQUIRED: _____


TRENCHES:	Trench to be _____ feet wide. Inlet _____ feet below original grade. Bottom maximum depth _____ feet below original grade. Effective area begins at _____ feet below original grade. _____ feet of stone below distribution pipe.
LOCATION:	_____
PURPOSE:	File re-indexed.

PLANS APPROVED: _____ DATE: _____

- NOTE: PERMIT VOID AFTER 2 YEARS
- NOTE: CONTRACTOR RESPONSIBLE FOR SCHEDULING A PRE-CONSTRUCTION INSPECTION FOR ALL INSTALLATIONS
- NOTE: WATERTIGHT SEPTIC TANKS REQUIRED
- NOTE: ALL PARTS OF SEPTIC SYSTEM SHALL BE 100 FEET FROM ANY WATER WELL
- NOTE: MANHOLE RISERS REQUIRED ON ALL SEPTIC TANKS AND PUMP CHAMBERS

**NEITHER THE HOWARD COUNTY COUNCIL NOR THE HEALTH DEPARTMENT IS
RESPONSIBLE FOR THE SUCCESSFUL OPERATION OF ANY SYSTEM
PERMITTEE RESPONSIBLE FOR OBTAINING FINAL APPROVAL ON THIS PERMIT
CALL 410-313-2640 FOR INSPECTION OF SEPTIC SYSTEM**

PS19049-F

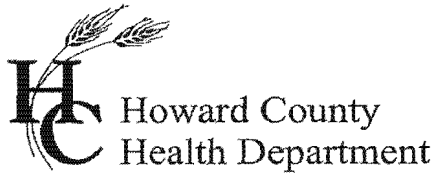

Bureau of Environmental Health
7178 Columbia Gateway Drive, Columbia MD 21046
(410) 313-2640 Fax (410) 313-2648
TDD (410) 313-2323 Toll Free 1-866-313-6300
website: www.hchealth.org

Peter L. Beilenson, M.D., M.P.H., Health Officer

July 12, 2010

Charles Daniels
5034 Durham Road East
Columbia, MD 21044

RE: **Variance Approval**
5034 Durham Road East
Columbia, MD 21044

Dear Sir:

This letter is being issued as follow up to the Health Department's verbal approval of your waiver request. The Department of Health received your variance request dated June 30, 2010 for the above referenced property. This agency will grant **approval** of the waiver to waive the required connection to public sewer as required by the *Howard County Code, Subtitle 8, and Section 3.802*. The waiver has been approved on the basis that the proposed tool shed does not increase the wastewater flow from the single family residence and does not impact future sewage disposal area in the event that public sewer is not available when the existing on-site sewage disposal system fails.

Any future addition that increases living space will require connection to public sewer. Any questions regarding this decision may be directed to the Well and Septic Program of the Howard County Health Department.

Respectfully,

Michael J. Davis, R.S.
Assistant Director
Bureau of Environmental Health

c: File

0/30/10

HOWARD COUNTY HEALTH DEPT.
7178 COLUMBIA GATEWAY DRIVE
COLUMBIA, MD 21046

CHARLES DANIELS
5034 DUEKING RD E.
COLUMBIA, MD
21044

CALL 410 490-8597

ATTN: MICHAEL DAVIS:

I WOULD LIKE TO APPLY FOR A VARIANCE FROM THE COUNTY REQUIREMENT TO CONNECT TO PUBLIC SEWAGE. I CURRENTLY HAVE A WORKING, WELL MAINTAINED, SEPTIC TANK FOR THE WIFE AND I ONLY.

I EXAGUERE OF CONNECTING TO PUBLIC UTILITIES AT THIS TIME PRESENT A HARDSHIP BECAUSE IT WOULD BE NO SMALL TASK TO RE-PLUMB THE HOUSE, FOR THE SIMPLE REQUEST OF ASKING A 'TOOL SITES' TO MY HOME.

I REALIZE CONNECTION TO PUBLIC UTILITIES IS IN MY FUTURE WITH ANOTHER BUILDING ADDITION SCHEDULED TO SEVERAL YEARS.


THANK YOU
Charles Daniels

7/7/10
M Davis
Approval

DURHAM ROAD EAST

23.6' Mac Baring - 50' R/W

Mac Baring

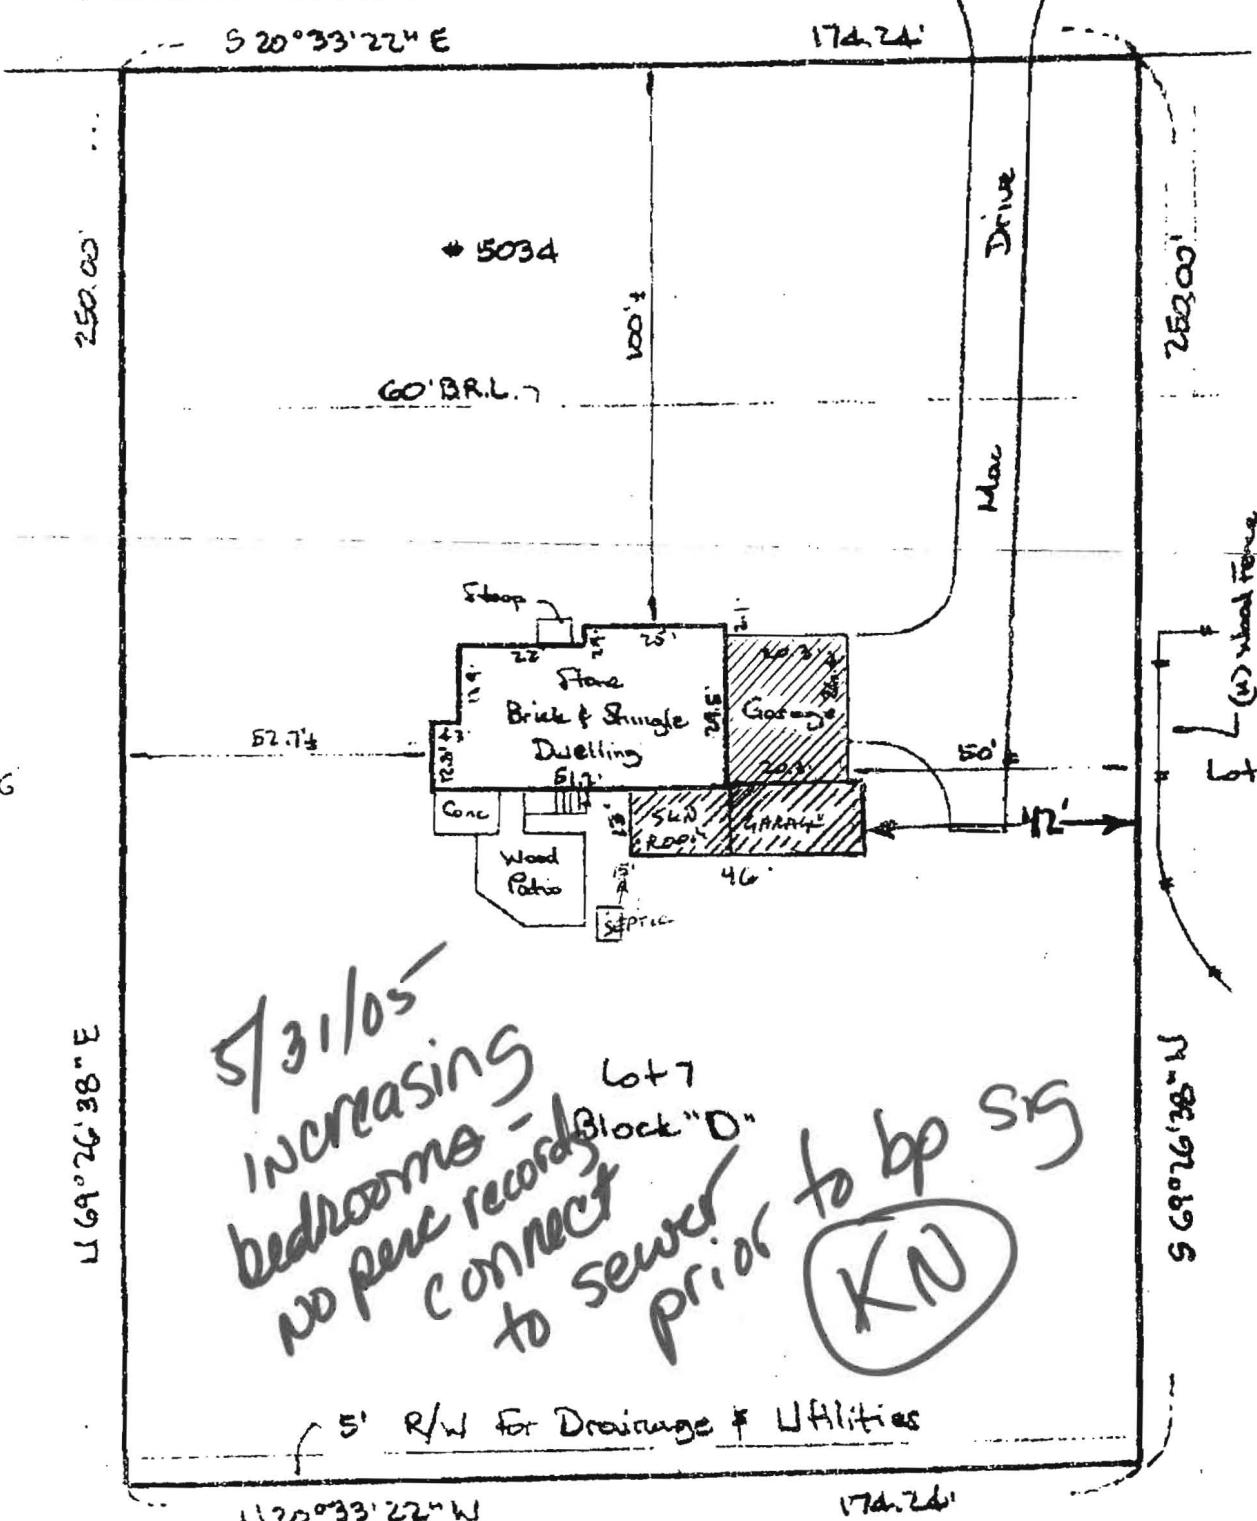

Lot 6

Lot 8
Wood Fence
Others

5/31/05
 increasing
 bedrooms -
 no perc records
 connect
 to sewer
 prior
 to bp
 KN

N 69° 26' 38" E

N 86° 02' 09" S

N 20° 33' 22" W

174.24'

THE LOT SHOWN HEREON IS IN FLOOD
 ZONE C PER F.E.M.A. FLOOD INSURANCE
 RATE MAP PANEL # 240044-0028B



Charles Daniels
 5034 Durham Rd. E
 Columbia, MD 21044-1421