

LAYOUT _____ INSP 4 _____
INSP 2 _____ INSP 5 _____
INSP 3 _____ INSP 6 _____

ISSUE DATE: _____
APPROVAL DATE: _____

PERMIT
INDEXED

03-299260

P _____
A 516962-B

ON-SITE SEWAGE DISPOSAL SYSTEM
HOWARD COUNTY HEALTH DEPARTMENT
BUREAU OF ENVIRONMENTAL HEALTH

_____ IS PERMITTED TO INSTALL ALTER

ADDRESS: _____ PHONE NUMBER: _____

SUBDIVISION: Woodmark II LOT NUMBER: 28, Blk E

ADDRESS: 12203 Etchison Road PROPERTY OWNER: Cahady

SEPTIC TANK CAPACITY (GALLONS): _____ OUTLET BAFFLE FILTER REQUIRED

PUMP CHAMBER CAPACITY (GALLONS): _____ COMPARTMENTED TANK REQUIRED

NUMBER OF BEDROOMS: _____

SQUARE FEET PER BEDROOM: _____

LINEAR FEET OF TRENCH REQUIRED: _____

TRENCHES:	Trench to be _____ feet wide. Inlet _____ feet below original grade. Bottom maximum depth _____ feet below original grade. Effective area begins at _____ feet below original grade. _____ feet of stone below distribution pipe.
LOCATION:	
NOTES:	

PLANS APPROVED: _____ DATE: _____

- NOTE: PERMIT VOID AFTER 2 YEARS
- NOTE: CONTRACTOR RESPONSIBLE FOR SCHEDULING A PRE-CONSTRUCTION INSPECTION FOR ALL INSTALLATIONS
- NOTE: WATERTIGHT SEPTIC TANKS REQUIRED
- NOTE: ALL PARTS OF SEPTIC SYSTEM SHALL BE 100 FEET FROM ANY WATER WELL
- NOTE: MANHOLE RISERS REQUIRED ON ALL SEPTIC TANKS AND PUMP CHAMBERS UNLESS SPECIFICALLY AUTHORIZED

NEITHER THE HOWARD COUNTY COUNCIL NOR THE HEALTH DEPARTMENT IS RESPONSIBLE FOR THE SUCCESSFUL OPERATION OF ANY SYSTEM PERMITTEE RESPONSIBLE FOR OBTAINING FINAL APPROVAL ON THIS PERMIT CALL 410-313-2640 FOR INSPECTION OF SEPTIC SYSTEM

BUILDING PERMIT SIGNED

AND RETURNED 5-20-02
600135905-DECK

A 516962-B

5/24/76

PERMIT

SEWAGE DISPOSAL SYSTEM

MARYLAND STATE DEPARTMENT OF HEALTH

HOWARD COUNTY

ELLICOTT CITY

INDEXED

DISTRICT 3

DATE 5/3/76

Superior A Bell IS PERMITTED TO INSTALL 2 ALTER

ADDRESS 10331 South Belfield, Orange Hills, Md PHONE 263-0880

SEWAGE DISPOSAL SYSTEM LOCATED AT _____

URDIVISION Foodbank ROAD 12205 Etchison Road LOT 20, Blk. B, Sec. 11

PROPERTY OWNER Robert J. Kowalski

ADDRESS _____

BUILDING PERMIT SIGNED AND RETURNED

6200
B00135905

SPECIFICATIONS - 4 bedrooms

DRAIN FIELD _____ DEPTH _____ FEET, BOTTOM AREA _____ SQ. FT.

SEWAGE PITS _____ ABSORBENT SIDE-WALL AREA _____ SQ. FT.

SEPTIC TANK CAPACITY 1,250 GALLONS

FOR GARBAGE GRINDER, INCREASE DISPOSAL AREA 25% & TANK CAPACITY 50%.

OTHER Dry well to have 125 sq. ft. effective absorbent sidewall area for bedrooms

below inlet. Inlet to be 3 ft. below original grade and maximum depth 11 ft. Location:

10 ft. off left property line and 25 ft. from front property line when facing lot from

road. (per hole 4 & 5).

NOTE: ALL PIPE FROM HOUSE TO DISPOSAL AREA MUST BE CAST IRON.
PERMIT VOID AFTER THREE YEARS.

NOTE: INSTALL STAND PIPE ON SEPTIC TANK AND DRY WELL. STAND PIPE MUST BE 6" IN DIA.,
CAST IRON, CONCRETE OR TERRA COTTA ACCEPTED.


PLANS APPROVED BY C. B. Strecker DATE 5/4/76

CALL SEPTIC TANK AND DISTRIBUTION BOX WITH WATER BEFORE CALLING FOR AN INSPECTION. COVER NO WORK UNTIL INSPECTED AND APPROVED.

NEITHER THE HOWARD COUNTY COMMISSIONERS NOR THE HEALTH DEPARTMENT IS RESPONSIBLE FOR THE SUCCESSFUL OPERATION OF ANY SYSTEM.

10/20/76
BUILDING PERMIT SIGNED

BLDG. PERMIT SIGNED AND RETURNED 10/20/76

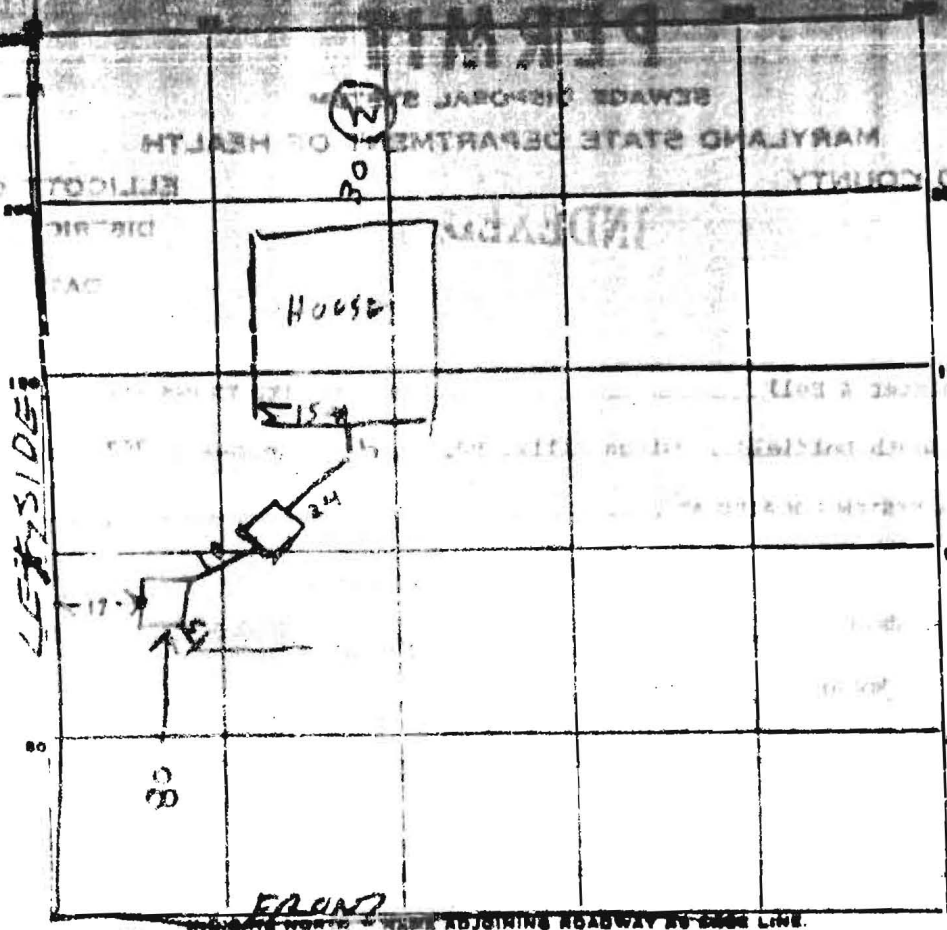

PERMIT CARD

DW | TANK

SEPTIC TANK, LEVEL 1200 TOP
2 FT BELOW GRADE

CLEANOUTS GI | OIS

DISTRIBUTION BOX, LEVEL

DITCH, DEPTH 2 FT. TRENCH WIDTH 1 FT.


GRAVEL DEPTH 8 FT IN. TOTAL LENGTH 21 FT.

NUMBER OF TRENCHES _____ TOTAL ^{SIDE} BOTTOM AREA 168 SQ. FT.

SEEPAGE PITS, INSIDE DIAMETER 42 FT. DEPTH BELOW INLET 8.5 FT.

ABSORBENT AREA 400 SQ. FT.

REMARKS 5/11/76 - INLET 3 FT BELOW GRADE TO BOTH
DRY WELL & DITCH TOTAL 576 SQ FT ABSORBENT
AREA 488 - 500 SQ FT REQUIRED

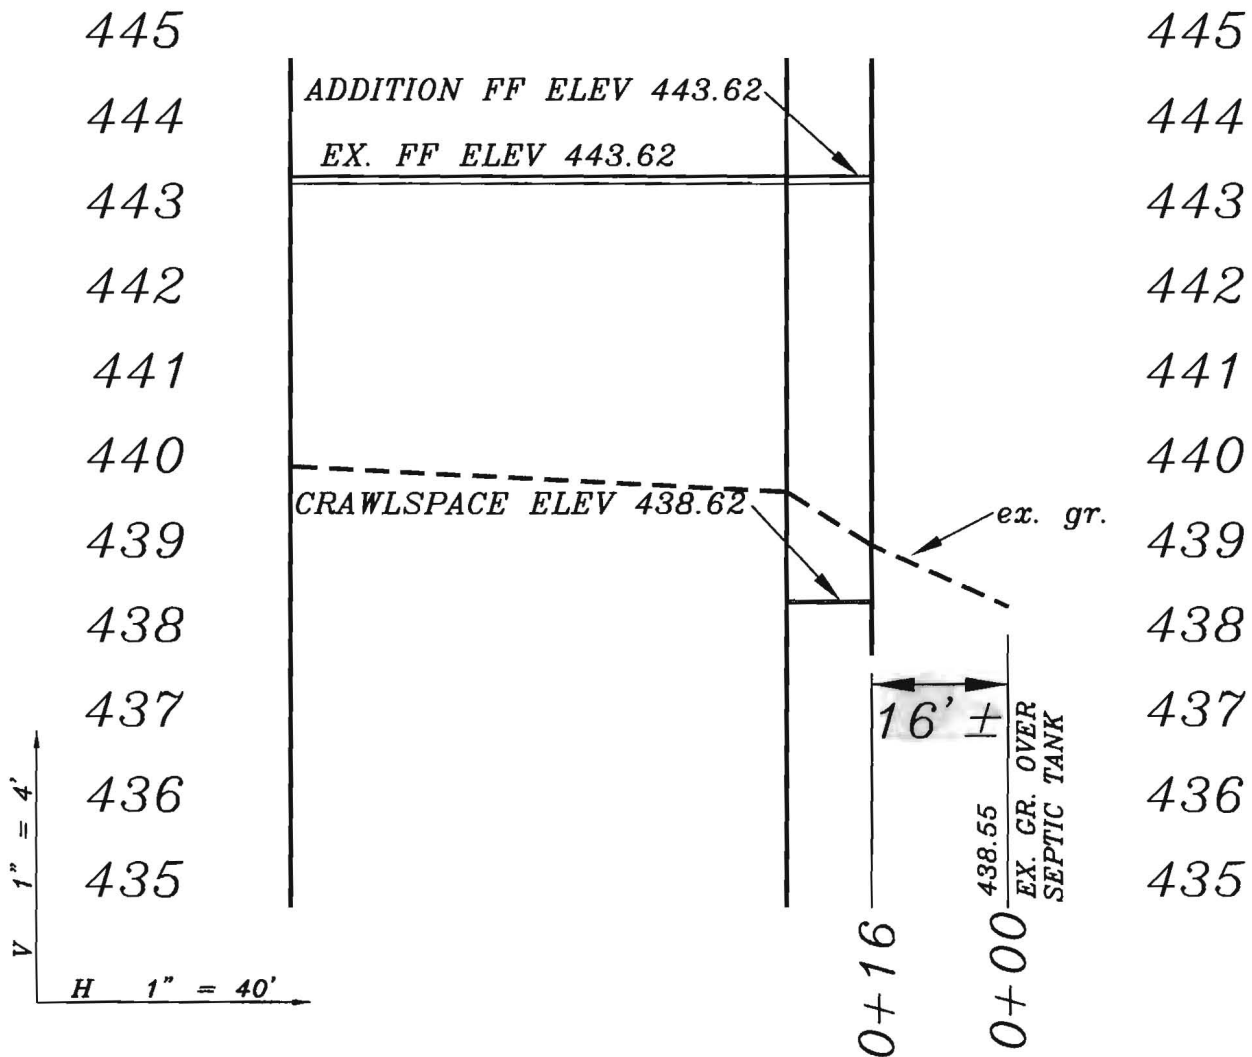

PROFILE OF HOUSE,
 ADDITION, & SEPTIC
 LOT 28, WOODMARK
 SEC II, BLOCK E

SCALE: 1" = 40' HOR., 1" = 4' VERT.

JUNE 29, 2007