

APPLICATION

1973

SEWAGE DISPOSAL TESTING

STATE OF MARYLAND - DEPARTMENT OF HEALTH AND MENTAL HYGIENE

HOWARD COUNTY HEALTH DEPARTMENT
ENVIRONMENTAL HEALTH SERVICES
P. O. BOX 479, ELLICOTT CITY, MARYLAND 21043
TELEPHONE: 443-8000, EXT. 308

DISTRICT 3rd
DATE 4-30-73

TO: THE COUNTY HEALTH OFFICER
ELLICOTT CITY, MARYLAND

I, HEREBY, APPLY FOR THE NECESSARY TEST IN ORDER TO CONSTRUCT (OR RECONSTRUCT) A SEWAGE DISPOSAL SYSTEM.

PROPERTY OWNER Mark Wakefield

ADDRESS Castoll Mill Rd., RD, PHONE 532-5072

PROPERTY LOCATION:

SUBDIVISION Woodmark LOT NO. 30, Blk. E., Sec. 11

ROAD AND DESCRIPTION Itchinson Rd.

SIZE OF LOT 49,300 sq. ft. TYPE BLDG. 3 of 4 Bedrooms
NUMBER OF BEDROOMS

IF NOT SINGLE RESIDENCE DESCRIBE _____

THE SYSTEM INSTALLED UNDER THIS APPLICATION IS ACCEPTABLE ONLY UNTIL PUBLIC FACILITIES BECOME AVAILABLE.

SIGNATURE OF APPLICANT Mark Wakefield /s/


APPROVED BY _____ FOR _____ DATE _____
(KIND OF SYSTEM)

REJECTED BY _____ FOR _____ DATE _____
(KIND OF SYSTEM)

HOLD PENDING FURTHER TESTS _____ DATE _____

REASONS FOR REJECTION OR HOLDING _____

ROTATION

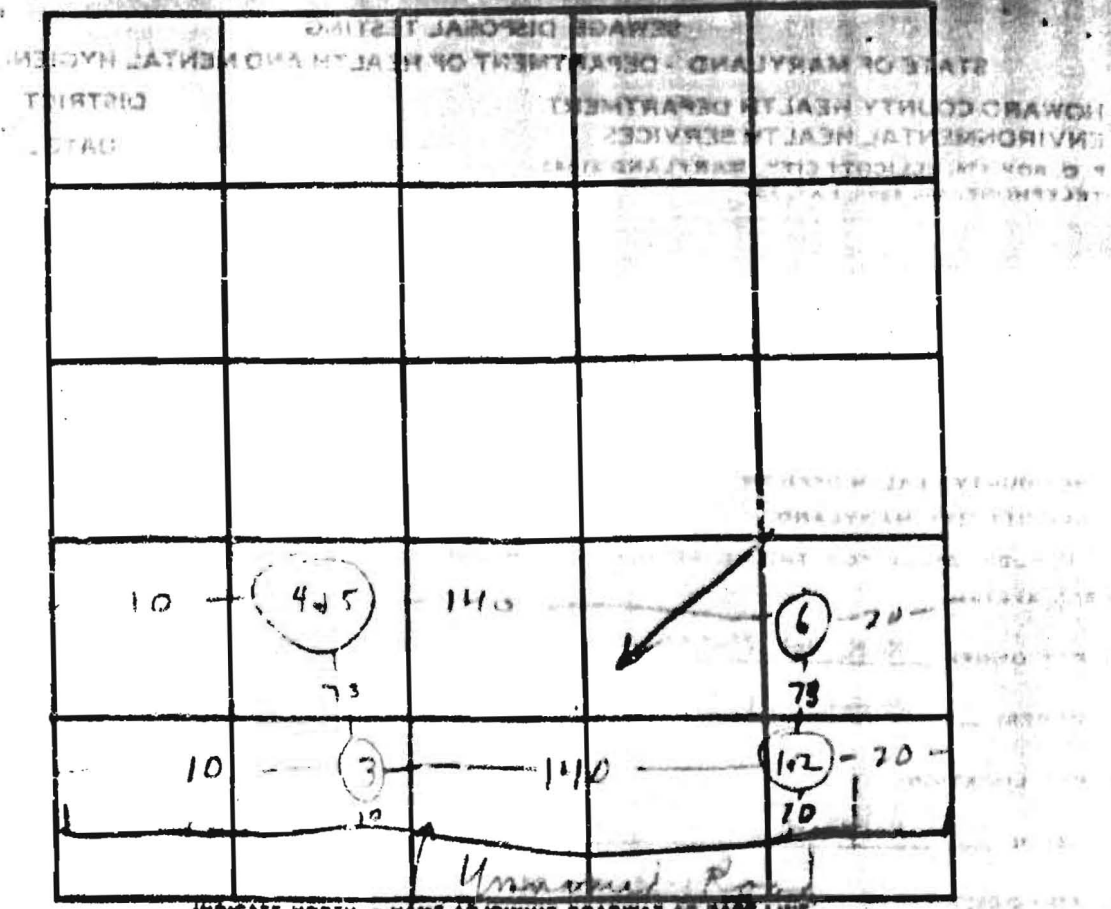

DATE	TEST NO.	DEPTH	PRE-WET		TEST - 1" DROP		TIME
			START	STOP	START	STOP	
7/17/54	1	3 1/2'	10:35	10:36	10:36	10:36	2 min
7/17/54	2	10 1/2'	10:36	10:37	10:37	10:40	3 min
	3	1 1/2'	Visual determination				4 45
7/17/54	4	3' 5"	10:41	10:43	10:43	10:50	7 min
7/17/54	5	11' 0"	10:41	10:42	10:42	10:44	2 min
	6	2 1/2'	Visual determination				142 1/2
						4/14	4 min

John J. [unclear]