

PRELIMINARY

APPLICATION

18556

A XXXX

SEWAGE DISPOSAL TESTING

P _____

STATE OF MARYLAND - DEPARTMENT OF HEALTH AND MENTAL HYGIENE

HOWARD COUNTY HEALTH DEPARTMENT
ENVIRONMENTAL HEALTH SERVICES

DISTRICT 3rd

P. O. BOX 476, ELLICOTT CITY, MARYLAND 21043
TELEPHONE: 483-3000, EXT. 386

DATE 6/8/73

TO: THE COUNTY HEALTH OFFICER
ELLICOTT CITY, MARYLAND

I, HEREBY, APPLY FOR THE NECESSARY TEST IN ORDER TO CONSTRUCT (OR RECONSTRUCT) A SEWAGE DISPOSAL SYSTEM.

PROPERTY OWNER Ex Edward W. & Helen T. Twining (Contract Purchaser - Jos. P. Crosby
5512 S. Medwick Garth, Balto. 21228)

ADDRESS _____ PHONE 646-3729

PROPERTY LOCATION:

SUBDIVISION _____ LOT NO. _____

ROAD AND DESCRIPTION Driver Road - approximately 1.3 mile before Novitate - quarry at bottom

SIZE OF LOT 27.445 acres TYPE BLDG. 5 bedrooms
NUMBER OF BEDROOMS

IF NOT SINGLE RESIDENCE DESCRIBE _____

THE SYSTEM INSTALLED UNDER THIS APPLICATION IS ACCEPTABLE ONLY UNTIL PUBLIC FACILITIES BECOME AVAILABLE.

SIGNATURE OF APPLICANT /s/ Joseph P. Crosby


APPROVED BY _____ FOR _____ DATE _____
(KIND OF SYSTEM)

REJECTED BY _____ FOR _____ DATE _____
(KIND OF SYSTEM)

HOLD PENDING FURTHER TESTS _____ DATE _____

REASONS FOR REJECTION OR HOLDING _____

THIS IS NOT A PERMIT

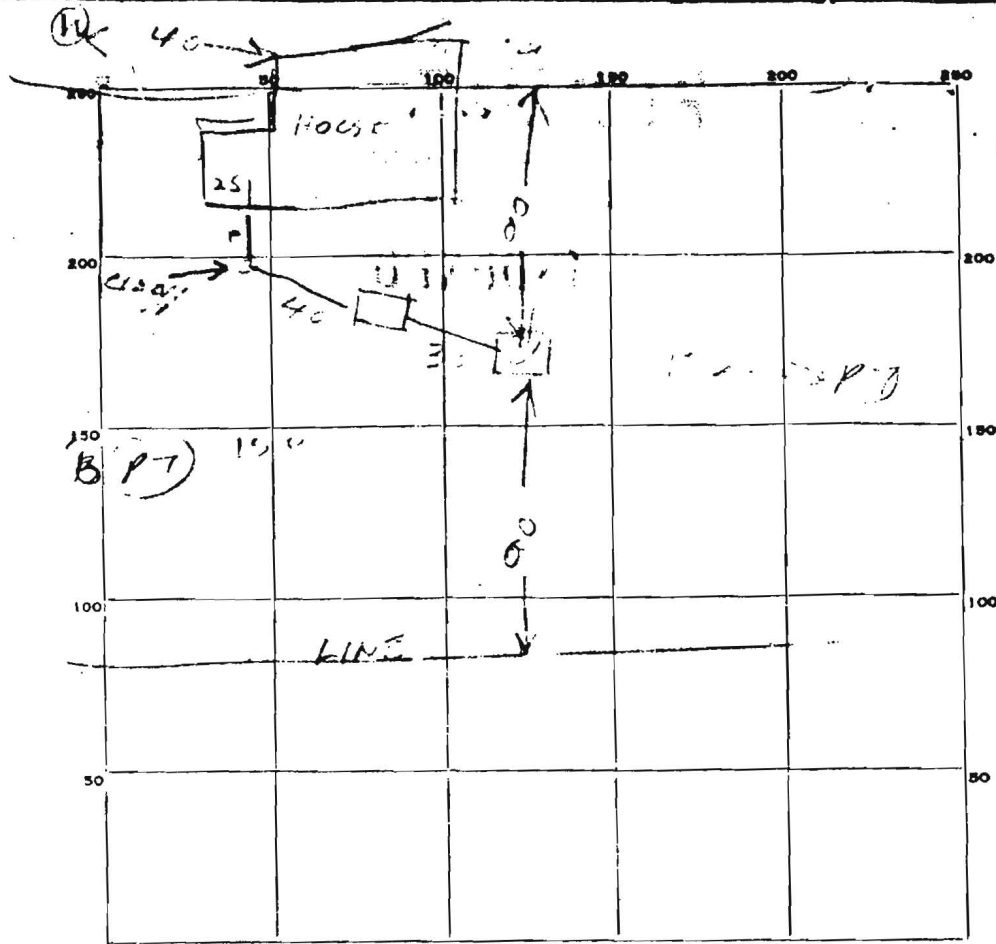

INDICATE NORTH - NAME ADJOINING ROADWAY AS BASE LINE.

PERMIT CARD _____

SEPTIC TANK, LEVEL 1.00 CLEANOUTS W/ENRINGS

DISTRIBUTION BOX, LEVEL TOP 3/4" BELOW GRADE

TILE FIELD, DEPTH _____ FT. TRENCH WIDTH _____ FT.

GRAVEL DEPTH _____ IN. TOTAL LENGTH _____ FT.

NUMBER OF TRENCHES 1 TOTAL BOTTOM AREA _____

SEEPAGE PITS, INSIDE DIAMETER 12 FT. DEPTH BELOW INLET 9 1/2 FT.

ABSORBENT AREA 544 SQ. FT.

REMARKS 7/1/74 - DN INLET 1/2" BELOW GRADE

3/4" DIA. 10' SQ FT. TRENCH

7/1/74 - 1/2" DIA. 10' SQ FT. TRENCH OK

2/10/74 - 1/2" DIA. 10' SQ FT. TRENCH

DATE SYSTEM APPROVED 7/1/74 INSPECTOR [Signature]

64
320
512
1536

1536