

LAYOUT \_\_\_\_\_ INSP 4 \_\_\_\_\_  
INSP 2 \_\_\_\_\_ INSP 5 \_\_\_\_\_  
INSP 3 \_\_\_\_\_ INSP 6 \_\_\_\_\_

ISSUE DATE: 10/26/2007

P 527884

APPROVAL DATE: 11/8/07

A 527883

# PERMIT

*Logged Into Permit Manager*

## ON-SITE SEWAGE DISPOSAL SYSTEM HOWARD COUNTY HEALTH DEPARTMENT BUREAU OF ENVIRONMENTAL HEALTH

Barnard Brothers Construction IS PERMITTED TO INSTALL  ALTER   
~~16400 Ed Warfield Rd~~  
ADDRESS: 1045 St Michaels Road PHONE NUMBER: 410-489-7621  
SUBDIVISION: \_\_\_\_\_ LOT NUMBER: \_\_\_\_\_  
ADDRESS: 16400 Ed Warfield Rd. PROPERTY OWNER: Greg and Carol Nolf  
SEPTIC TANK CAPACITY (GALLONS): 2000\* OUTLET BAFFLE FILTER REQUIRED   
PUMP CHAMBER CAPACITY (GALLONS): N/A COMPARTMENTED TANK REQUIRED   
NUMBER OF BEDROOMS: 4  
SQUARE FEET PER BEDROOM: N/A  
LINEAR FEET OF TRENCH REQUIRED: N/A

TRENCHES:	No alteration to septic trenches under this permit
LOCATION:	Install an additional 750 gallons (minimum) of septic tank storage capacity or abandon the existing tank and install a new 2000 gallon septic tank to meet the 2000 gallon tank size requirement for homes over 3500 square feet.
NOTES:	* Total septic tank storage to equal 2000 gallons Permit fee for tank: \$165.00 <i>In support of Building Permit B07003759</i>


PLANS APPROVED: Gabriel A. Creighton DATE: 10/10/2007

- NOTE: PERMIT VOID AFTER 2 YEARS
- NOTE: CONTRACTOR RESPONSIBLE FOR SCHEDULING A PRE-CONSTRUCTION INSPECTION FOR ALL INSTALLATIONS
- NOTE: WATERTIGHT SEPTIC TANKS REQUIRED
- NOTE: ALL PARTS OF SEPTIC SYSTEM SHALL BE 100 FEET FROM ANY WATER WELL
- NOTE: MANHOLE RISERS REQUIRED ON ALL SEPTIC TANKS AND PUMP CHAMBERS UNLESS SPECIFICALLY AUTHORIZED

**NEITHER THE HOWARD COUNTY COUNCIL NOR THE HEALTH DEPARTMENT IS  
RESPONSIBLE FOR THE SUCCESSFUL OPERATION OF ANY SYSTEM  
PERMITTEE RESPONSIBLE FOR OBTAINING FINAL APPROVAL ON THIS PERMIT  
CALL 410-313-1771 FOR INSPECTION OF SEPTIC SYSTEM**

NOT TO SCALE

HO-81-0125

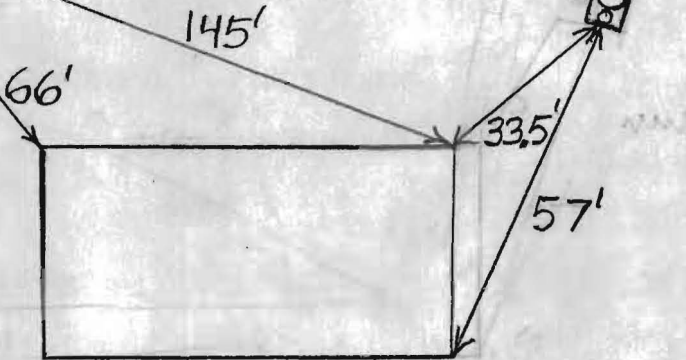

FRENCH/DRAINFIELD DATA		
WIDTH	INLET	BOTTOM
_____	_____	_____
NUMBER OF TRENCHES _____		
TOTAL LENGTH _____		
ABSORPTION AREA _____		
DISTRIBUTION BOX LEVEL _____		
DISTRIBUTION BOX BAFFLE _____		
DISTRIBUTION BOX PORT <u>No</u>		

SEPTIC TANK DATA	
SEPTIC TANK 1 LEVEL	<u>Yes</u>
CAPACITY	<u>1250?</u> GAL
SEAM LOC	<u>Midseam</u>
TANK LID DEPTH	<u>2'</u>
BAFFLES	<u>Told Installer to Check</u>
BAFFLE FILTER	<u>No</u> Baffles
MANHOLE LOC	<u>Middle</u>
6" PORT LOC	<u>Front</u>
WATERTIGHT TEST	<u>No</u>
3x6	
SEPTIC TANK 2 LEVEL	<u>Yes</u>
CAPACITY	<u>1000</u> GAL
SEAM LOC	<u>Top</u>
TANK LID DEPTH	<u>2-2.5'</u>
BAFFLES	<u>Yes</u>
BAFFLE FILTER	<u>No</u>
MANHOLE LOC	<u>Middle</u>
6" PORT LOC	<u>None</u>
WATERTIGHT TEST	<u>No</u>

PRE-CONSTRUCTION

\_\_\_\_\_

\_\_\_\_\_

\_\_\_\_\_

\_\_\_\_\_

Ed Warfield ROAD

INSTALLATION: 11/8/07 New 1000 gallon tank installed behind existing tank. O.K. to backfill. (BB)

FINAL INSPECTOR B. Baber DATE OF APPROVAL 11/8/07