



**B 1** **9867** SEQUENCE NO. (DP USE ONLY)  
 (THIS NUMBER IS TO BE PUNCHED IN COLS. 3-6 ON ALL CARDS)

**STATE OF MARYLAND**  
**PERMIT TO DRILL WELL**  
 please print or type

STATE PERMIT NUMBER  
**40-88-0325**  
 fill-in this form completely

Date Received (APA) **0808**  
**NICK PROTAS** OWNER INFORMATION  
**PROTAS HOMES**  
 15 Last Name Owner First Name 34  
**11200 LORCKWOOD DR**  
 36 Street or RFD 55  
**SILVER SPRING MD 20901**  
 57 Town 70 State 72 Zip 76

**B 3** LOCATION OF WELL **R-42860**  
**40 RD**  
**10/27/88**  
**HOWARD** COUNTY 8  
**MARIEKAI HOSEH** SUBDIVISION 23  
 SECTION **16** LOT **16**  
**DAISY** NEAREST TOWN 52  
 MILES FROM TOWN (enter 0 if in town) **MI**

**DRILLER INFORMATION**  
**George F. Easterday**  
 Driller's Name 40  
**L. Franklin Easterday, Inc.** 77 License No. 80  
 Firm Name  
**9205 Brown Church Rd., Mt. Airy, Md. 21771**  
 Address  
**George F. Easterday** 10/19/88  
 Signature Date

**B 4** DIRECTION OF WELL FROM TOWN (CIRCLE BOX)  
**ED WARFIELD RD (16170)** NEAR WHAT ROAD 11  
 ON WHICH SIDE OF ROAD (CIRCLE APPROPRIATE BOX)  
 NORTH N  
 WEST W  
 EAST E  
 SOUTH S  
 DISTANCE FROM ROAD **3800** 37  
 ENTER FT or MI **FT** 38 39

**B 2** WELL INFORMATION  
 APPROX. PUMPING RATE (GAL. PER MIN.) **5**  
 AVERAGE DAILY QUANTITY NEEDED (GAL. PER DAY) **500**

USE FOR WATER (CIRCLE APPROPRIATE BOX)  
 HOME (SINGLE OR DOUBLE HOUSEHOLD UNIT ONLY)  
 FARMING (LIVESTOCK WATERING & AGRICULTURAL IRRIGATION)  
 INDUSTRIAL, COMMERCIAL, STATE AND FEDERAL GOV. OTHER (REQUIRES APPROPRIATION PERMIT)  
 PUBLIC OR PRIVATE WATER COMPANY (REQUIRES APPROPRIATION PERMIT AND STATE HEALTH DEPARTMENT APPROVAL)  
 TEST, OBSERVATION, MONITORING (MAY REQUIRE APPROPRIATION PERMIT)

NOT TO BE FILLED IN BY DRILLER HEALTH DEPARTMENT APPROVAL  
**HOWARD** COUNTY NAME  
**A# 29925** COUNTY NO.  
 STATE SIGNATURE **Jane E. Maden** INSERT S  
 DATE ISSUED **5-30-89** C.80  
 CO SIGNATURE EXP. DATE  
 NORTH GRID **532000** EAST GRID **0779000**


APPROXIMATE DEPTH OF WELL **200** FEET

APPROXIMATE DIAMETER OF WELL **6** NEAREST INCH

METHOD OF DRILLING (circle one)  
 BORED (or Augered) JETTED Jetted & DRIVEN  
 AIR-ROtary AIR-PERcussion ROTARY (Hydraulic Rotary)  
 CABLE REVERSE-ROtary DRIVE-POINT  
 other \_\_\_\_\_

SHOW MAJOR FEATURES OF BOX & LOCATE WELL WITH AN X  
 SOURCES OF DRILLING WATER WELL  
 1. **12/14/88 2pm**  
**14 BAGS CEMENT**  
**60FT CASING**  
**2FT A.G.**  
**SOFT OPEN**  
**000 TAG OK**  
 WRITE THE BOX NUMBER FROM THE MAP HERE  
 E **779 9**  
 N **536 9**


REPLACEMENT OR DEEPEINED WELLS (CIRCLE APPROPRIATE BOX)  
 THIS WELL WILL NOT REPLACE AN EXISTING WELL  
 THIS WELL WILL REPLACE A WELL THAT WILL BE ABANDONED AND SEALED.  
 THIS WELL WILL REPLACE A WELL THAT WILL BE USED AS A STANDBY  
 THIS WELL WILL DEEPEIN AN EXISTING WELL  
 PERMIT NUMBER OF WELL TO BE REPLACED OR DEEPEINED (IF AVAILABLE) \_\_\_\_\_

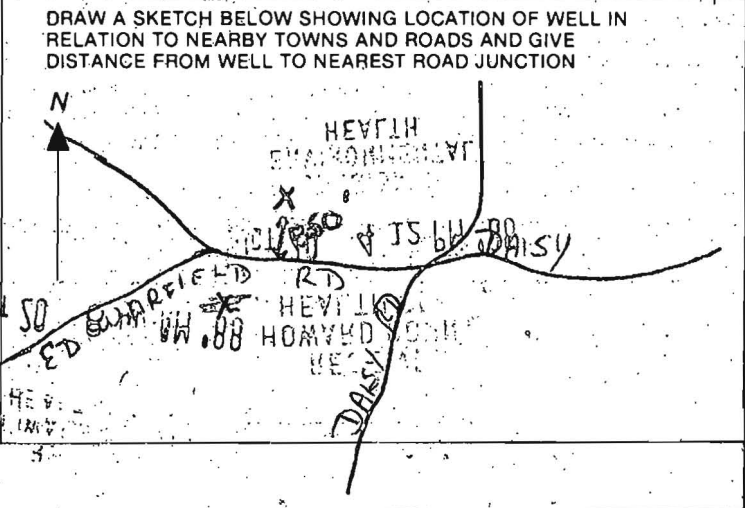

Not to be filled in by driller (OEP USE ONLY)  
 APPROP. PERMIT NUMBER **GAP**  
 FORCE  WRITE INITIALS IN BOX PERMIT NO. **40-88-0325**

SPECIAL CONDITIONS



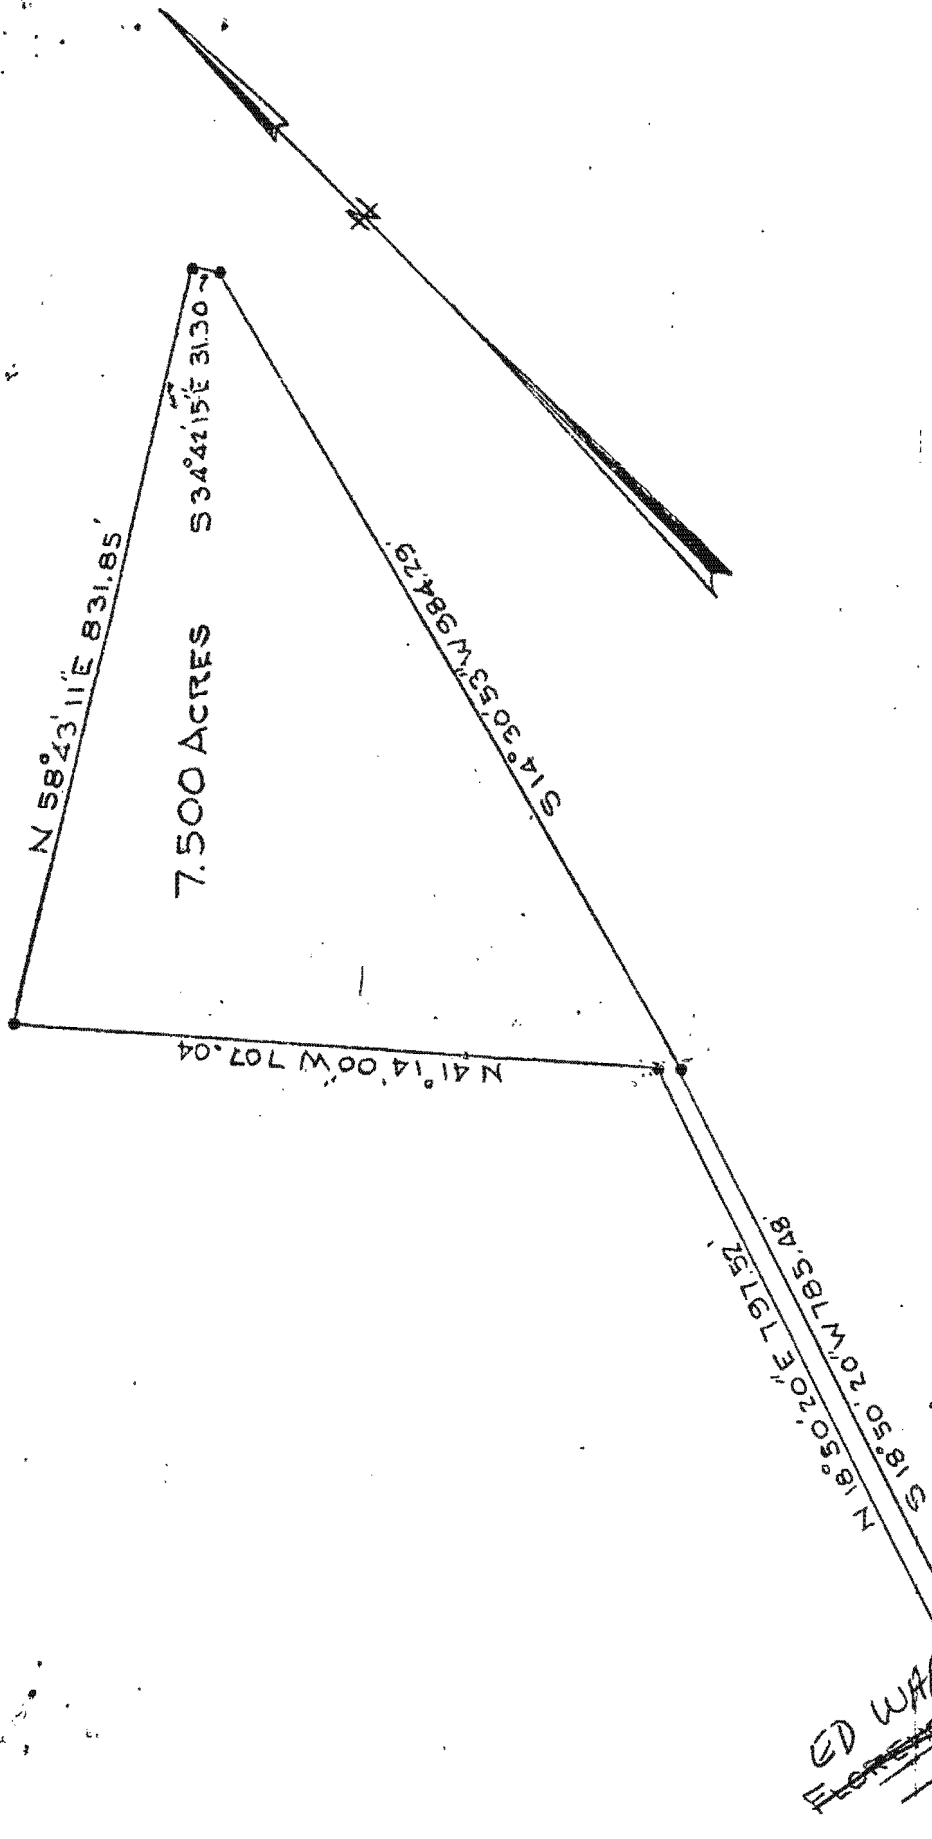

PLAT OF SURVEY  
 FOR  
 MORDECAI HOSEH  
 FOURTH ELECTION DISTRICT, HOWARD COUNTY  
 WOODBINE, MARYLAND.

SCALE: 1 IN = 200 FT  
 JANUARY 31, 1973.

*Claude M. Skinner Jr.*  
 Claude M. Skinner, Jr.  
 Reg. Professional Engineer &  
 Land Surveyor No. 2237