

LAYOUT 1/4/05 - 11/1/04 INSP 4 _____
 INSP 2 1-11-05 INSP 5 _____
 INSP 3 _____ INSP 6 _____

ISSUE DATE: 12/10/2004 P 521614

PERMIT 04-316231

APPROVAL DATE: 1-11-05 A 515344-A

**ON-SITE SEWAGE DISPOSAL SYSTEM
 HOWARD COUNTY HEALTH DEPARTMENT
 BUREAU OF ENVIRONMENTAL HEALTH**

Level Land Inc. IS PERMITTED TO INSTALL ALTER

ADDRESS: PO Box 100, Lisbon, MD 21765 PHONE NUMBER: 443-677-0627

SUBDIVISION: _____ LOT NUMBER: _____

ADDRESS: 2425 Duvall Road (Tenant House) PROPERTY OWNER: Covered Bridge Farm LLC

SEPTIC TANK CAPACITY (GALLONS): ~~1250~~ 1500 OUTLET BAFFLE FILTER REQUIRED

PUMP CHAMBER CAPACITY (GALLONS): N/A COMPARTMENTED TANK REQUIRED

NUMBER OF BEDROOMS: 4

SQUARE FEET PER BEDROOM: 210

LINEAR FEET OF TRENCH REQUIRED: ~~280~~ 210 (New spec)



TRENCHES:	Trench to be 3.0 feet wide. Inlet 2.5 feet below original grade. Bottom maximum depth 4.5 feet below original grade. Effective area begins at 2.5 feet below original grade. 2.0 feet of stone below distribution pipe.
LOCATION:	Place the distribution box midway between the two upper corner easement stakes. Run trenches on contour in both directions.
NOTES:	<u>Clean outs every 70'</u>

PLANS APPROVED: Brian Baker OK 12/16/02 (SO) DATE: 7/25/2002


- NOTE: PERMIT VOID AFTER 2 YEARS
- NOTE: CONTRACTOR RESPONSIBLE FOR SCHEDULING A PRE-CONSTRUCTION INSPECTION FOR ALL INSTALLATIONS
- NOTE: WATERTIGHT SEPTIC TANKS REQUIRED
- NOTE: ALL PARTS OF SEPTIC SYSTEM SHALL BE 100 FEET FROM ANY WATER WELL
- NOTE: MANHOLE RISERS REQUIRED ON ALL SEPTIC TANKS AND PUMP CHAMBERS UNLESS SPECIFICALLY AUTHORIZED

NEITHER THE HOWARD COUNTY COUNCIL NOR THE HEALTH DEPARTMENT IS RESPONSIBLE FOR THE SUCCESSFUL OPERATION OF ANY SYSTEM

**PERMITTEE RESPONSIBLE FOR OBTAINING FINAL APPROVAL ON THIS PERMIT
 BUILDING PERMIT SIGNED AND RETURNED
 CALL 410-313-2640 FOR INSPECTION OF SEPTIC SYSTEM**

3-2-05 800 152 327-UG ROTANE TANK

NOT TO SCALE

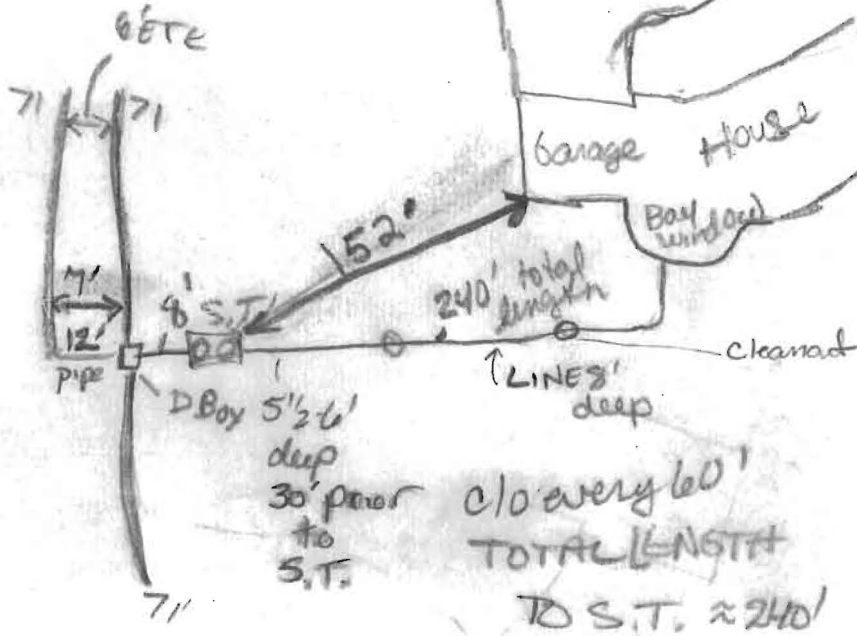

TRENCH/DRAINFIELD DATA		
WIDTH	INLET	BOTTOM
3'	2 1/2	4 1/2
NUMBER OF TRENCHES		3
TOTAL LENGTH		213
ABSORPTION AREA		840 ft ²
DISTRIBUTION BOX LEVEL		yes w/ levelers
DISTRIBUTION BOX BAFFLE		yes
DISTRIBUTION BOX PORT		NO

SEPTIC TANK DATA	
SEPTIC TANK 1 LEVEL <u>yes</u>	
CAPACITY	1500 GAL
SEAM LOC	TOP
TANK LID DEPTH	18-20"
BAFFLES	yes
BAFFLE FILTER	NO
MANHOLE LOC	front
6" PORT LOC	back
WATERTIGHT TEST	NO
SEPTIC TANK 2 LEVEL <u>N/A</u>	
CAPACITY	_____ GAL
SEAM LOC	_____
TANK LID DEPTH	_____
BAFFLES	_____
BAFFLE FILTER	_____
MANHOLE LOC	_____
6" PORT LOC	_____
WATERTIGHT TEST	_____

PRE-CONSTRUCTION 1/4/05 - SRA stated contour accurate, Inst #3
70' trenches on contour (S) 1-11-05
 INSTALLATION 1-11-05 installed 30K to cover WELL LINE
INSP TO come... (KN)

FINAL INSPECTOR Karen Norman DATE OF APPROVAL 1-11-05

BUILDING PERMIT SIGNED AND RETURNED

SITE INSPECTION SHEET

A515344-A

OWNER: Old Covered Bridge Farm, LLC PHONE #: _____


ADDRESS: 2435 Duwall Rd CONTRACTOR: _____

WELL TAG #: HO-94-3264

SUBDIVISION: Ag. Pres. LOT: Parcel 354 Lot 1 COUNTY #: Howard A515344A

PROPOSAL: _____

LOCATION DIAGRAM

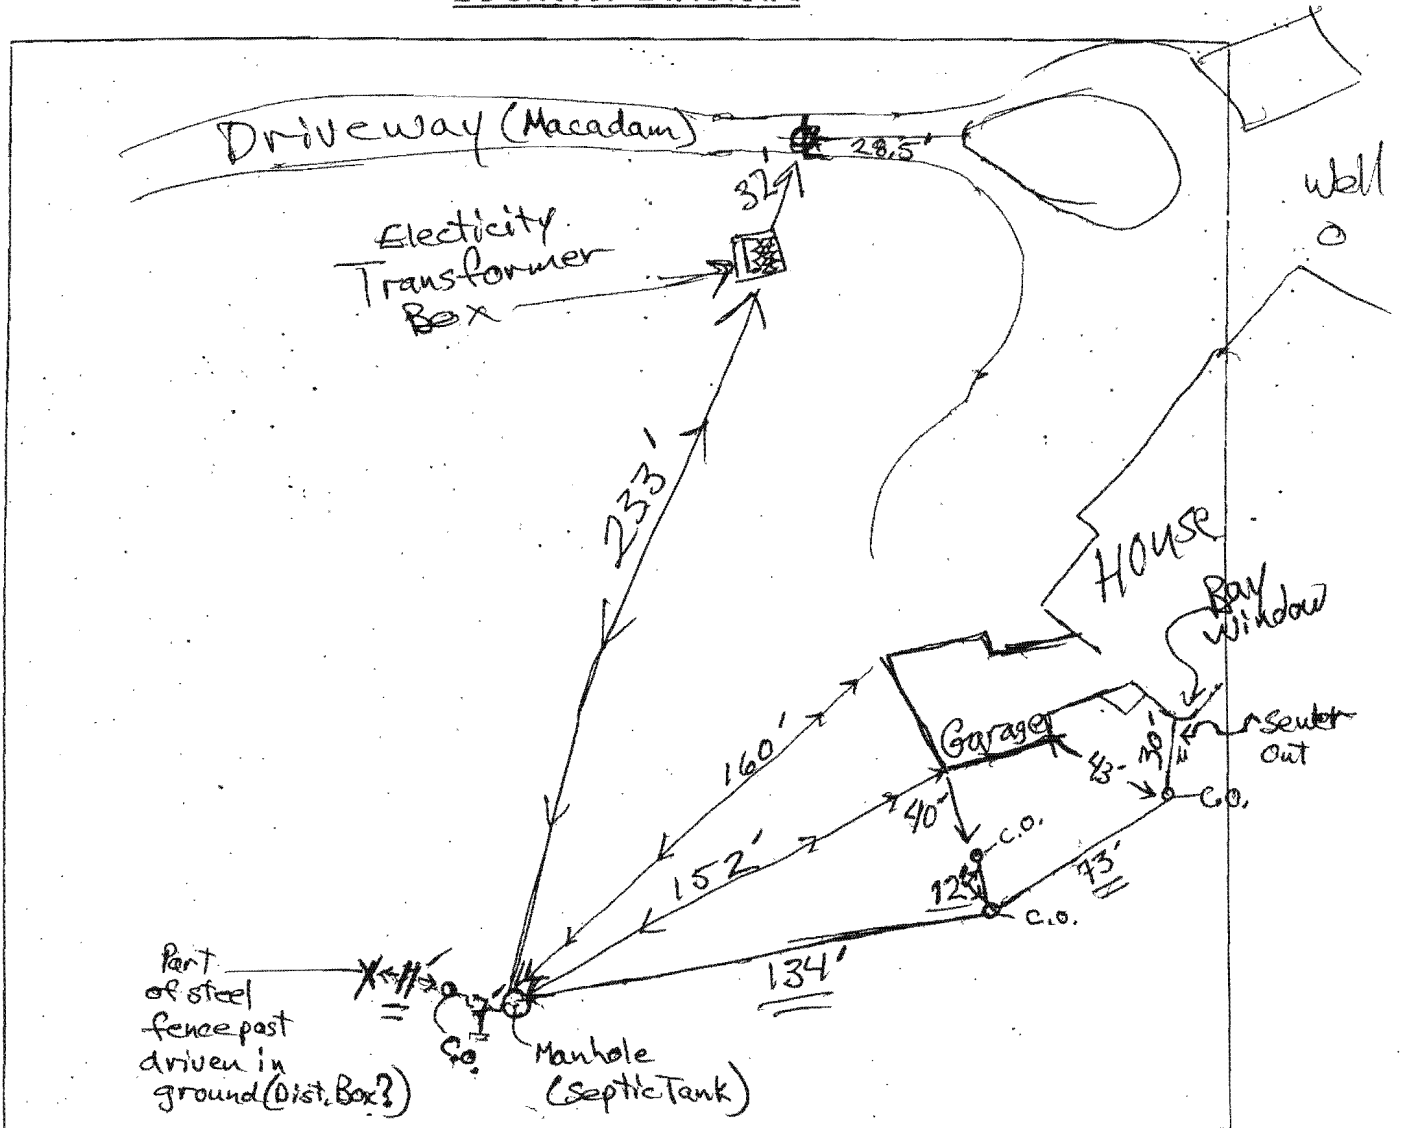

COMMENTS: Sketch of septic system line from residence to septic tank. Confirms distance and location of 'as built' drawing. feb 2/1/07