

1/16/96
10:00 AM
SEPTIC CO. / WOL
03-307832

PERMIT

SEWAGE DISPOSAL SYSTEM

DEPARTMENT OF HEALTH AND MENTAL HYGIENE

P 516615

A 28490

DISTRICT 3rd

HOWARD COUNTY HEALTH DEPARTMENT

BUREAU OF ENVIRONMENTAL HEALTH

~~313-2640~~ 313-2640

6/19/96
K+K TO CONTACT
WILDER BUILDING TO
GET TRANSFER
OF PERMIT. OK
6/19/96 ISSUE RESOLVED! SS

INDEXED

DATE 5/10/96

DATE SYSTEM APPROVED 7-16-96

INSPECTOR [Signature]

J. Joseph Gartland (PLUMBING CONTRACTOR) IS PERMITTED TO INSTALL X ALTER

ADDRESS 1835 West Old Liberty Road Westminster, MD 21157 PHONE 875-2400

SUBDIVISION Laukenmann Property LOT 8 ROAD 1070 Driver Road

PROPERTY OWNER Wilder Building Corp. / MC MURTRIE

ADDRESS _____

SEPTIC TANK CAPACITY 1250 GALLONS
NUMBER OF BEDROOMS 4

****TWO DRYWELLS**:**
*720 total square feet, each drywell to be 15 foot square, providing 360 feet (60' perimeter X 6' deep) square foot of clean area.

180 SQUARE FEET PER BEDROOM

LINEAR FEET OF TRENCH REQUIRED _____

TRENCHES - Inlet 4 feet below original grade. Bottom maximum depth 10 feet below original grade. Effective area begins at 4 feet below original grade.

LOCATION - Place the center of the upper drywell 60' from the front lot line and 30' from the right lot line. Center of second drywell to be 45' downhill from center of upper drywell. Use distribution box or similar device to split effluent equally between the two drywells.

OK 1/2 PG Dykes

6-5-96 SITE INSPECTION - GRAVITY SERVICE SHOULD BE IN PLACE TO ALL PORTIONS OF THE SEWAGE EASEMENT - WILL CONFLICT WITH HIGHER PORTION OF SEWAGE EASEMENT.

PLANS APPROVED BY Craig Williams DATE 10/5/95

COVER NO WORK UNTIL INSPECTED AND APPROVED

NEITHER THE HOWARD COUNTY COUNCIL NOR THE HEALTH DEPARTMENT IS RESPONSIBLE FOR THE SUCCESSFUL OPERATION OF ANY SYSTEM

NOTE: CLEANOUT REQUIRED EVERY 70 FEET OF SEWER LINE AND/OR AT 90° SWEEPS IN LINES FROM HOUSE TO DRAIN FIELDS, 90° ELBOWS NOT ACCEPTABLE.

NOTE: ALL PARTS OF SEPTIC SYSTEMS (I.E. TANK, DISTRIBUTION BOX TRENCHES) TO BE 100 FEET FROM WELL (UNLESS OTHERWISE SPECIFICALLY AUTHORIZED)

NOTE: IF DEEP TRENCH(ES) ARE USED CALL FOR INSPECTION BEFORE AND AFTER PLACING GRAVEL IN TRENCH(ES)

NOTE: NO DRY WELL SHALL EXCEED 15 FOOT IN DIAMETER NO ABSORPTION TRENCH TO EXCEED 100 FEET IN LENGTH

NOTE: ALL PIPE FROM HOUSE TO SEPTIC TANK MUST BE CAST IRON OR SCHEDULE 35/40 PVC OR ABS


PERMIT VOID AFTER TWO YEARS

NOTE: INSTALL STAND PIPE ON SEPTIC TANK AND DRY WELL STAND PIPES MUST BE 6 INCHES IN DIAMETER CAST IRON, CONCRETE OR TERRA COTTA OR PVA OR ABS ACCEPTED. IF TOP OF SEPTIC TANK IS DEEPER THAN 3 FEET, MANHOLE TO GRADE REQUIRED.

NOTE: DISTRIBUTION BOXES MUST HAVE BAFFLES

***INSTALLER IS RESPONSIBLE FOR OBTAINING FINAL APPROVAL ON THIS PERMIT**

A 28490

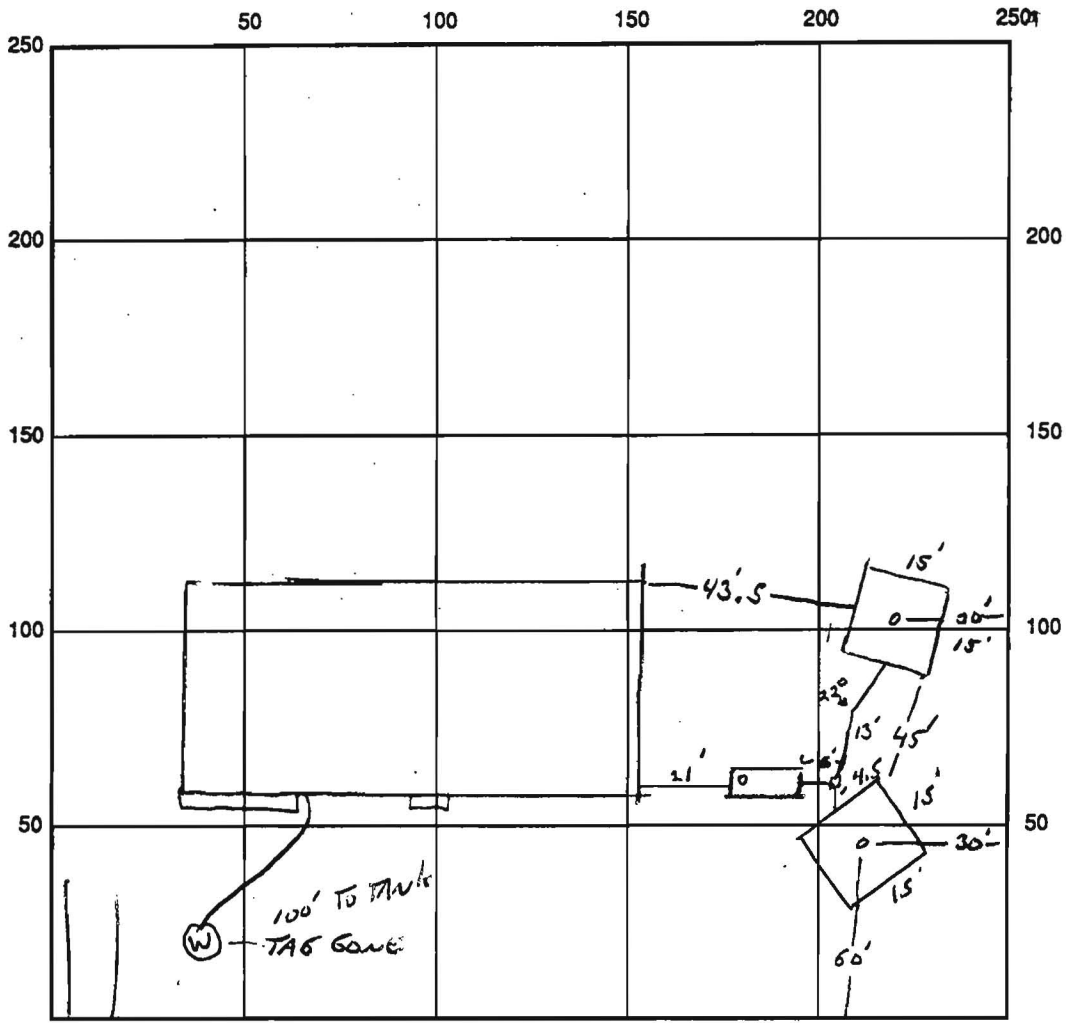

7/16/96
WPI OK
EB

SEPTIC TANK LEVEL OK, RAFFLE W CLEANOUTS 100' TANK, 1 ON EACH DAYWELL
 DISTRIBUTION BOX LEVEL OK
 DRAIN FIELD/TITLE DEPTH 10 FT. TRENCH WIDTH NA FT. INLET DEPTH 4 FT.
 EFFECTIVE GRAVEL DEPTH 6-7' FT. TOTAL LENGTH — FT.
 NUMBER OF TRENCHES NA ~~ONE~~ SIDEWALL/BOTTOM AREA 720 SQ. FT.
 DRYWALL INSIDE DIAMETER 60 FT. EFFECTIVE DEPTH BELOW INLET 6 FT.
 ABSORBENT AREA 720 SQ. FT.

REMARKS: 7-16-96 SEPTIC SYSTEM OK TO COVER.

DATE SYSTEM APPROVED 7-16-96 INSPECTOR Hal Jones

