

APPLICATION

SEWAGE DISPOSAL TESTING

MARYLAND STATE DEPARTMENT OF HEALTH

HOWARD COUNTY

ELLICOTT CITY

DISTRICT 3rd

DATE 3/23/72

A 16872

P _____

TO: THE COUNTY HEALTH OFFICER
ELLICOTT CITY, MARYLAND

I, HEREBY, APPLY FOR THE NECESSARY TESTS IN ORDER TO CONSTRUCT (OR RECONSTRUCT) A SEWAGE DISPOSAL SYSTEM.

PROPERTY OWNER Hudson Construction Company, Inc.

ADDRESS 8957 Chapel Drive, Ellicott City, Md. PHONE 465-2205

PROPERTY LOCATION:

SUBDIVISION Evergreen Valley Estates LOT NO. 7, Blk. B. Sec. 7

ROAD AND DESCRIPTION Cor. Evergreen Way & Emerald Valley Ri.

OCCUPANT _____ PHONE _____

PERSON TO CONSTRUCT SYSTEM _____

ADDRESS _____ PHONE _____

SIZE OF LOT 41,730 sq. ft. TYPE BLDG. 3 or 4

IF NOT SINGLE RESIDENCE DESCRIBE _____
(Single Fam. Dwllg)

SIGNATURE OF APPLICANT /s/ Madeline Leonardi

APPROVED BY _____ FOR _____ DATE _____


(KIND OF SYSTEM)

REJECTED BY _____ FOR _____ DATE _____

(KIND OF SYSTEM)

HOLD PENDING FURTHER TESTS _____ DATE _____

REASONS FOR REJECTION OR HOLDING _____

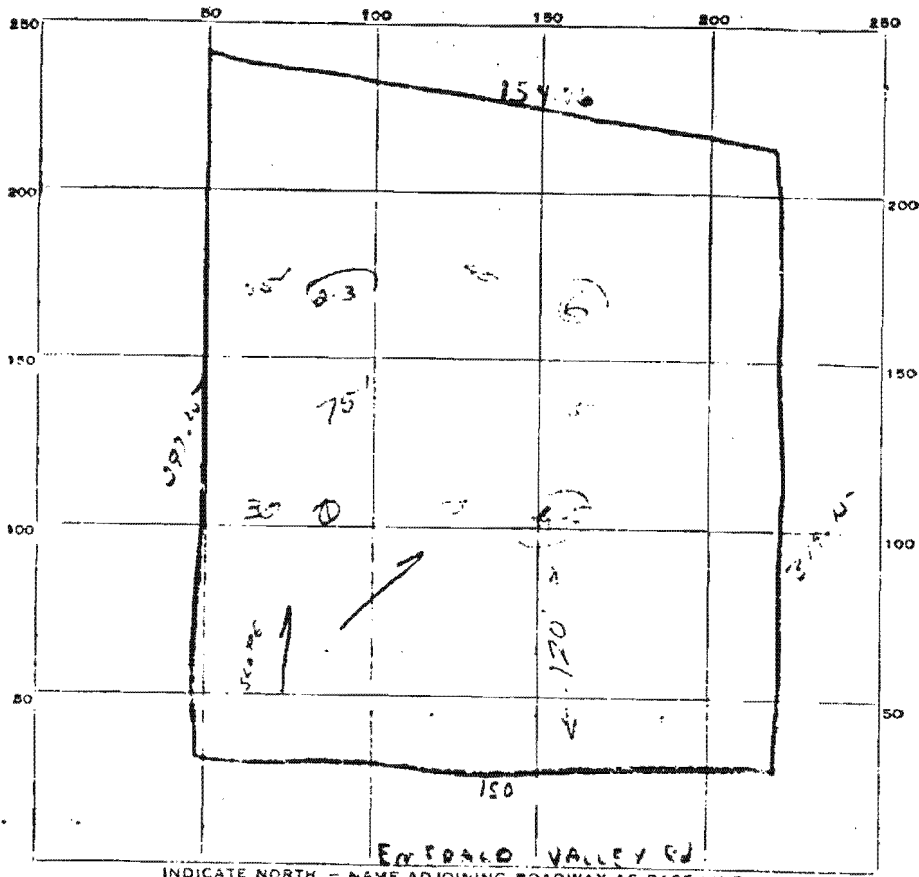

INDICATE NORTH - NAME ADJOINING ROADWAY AS BASE LINE

LOT 12

DATE	TEST NO	DEPTH	PRE-WET		TEST - 1" DROP		TIME
			START	STOP	START	STOP	
	1	10					
	2	11	3:3	3:5		3:23	6
	3	4	3:12	3:5	3:5	3:5	5
	4	4	3:0	3:31	3:31	3:31	7
	5	10	3:20	3:38	3:38	3:38	2
	6	10					

1.7m
with 2 1/2 ft

SOIL AUGER FINDING _____
 TESTED BY _____
 REMARKS _____