

PRELIMINARY

# APPLICATION

A 25583

P \_\_\_\_\_

## SEWAGE DISPOSAL TESTING

STATE OF MARYLAND - DEPARTMENT OF HEALTH AND MENTAL HYGIENE

HOWARD COUNTY HEALTH DEPARTMENT  
ENVIRONMENTAL HEALTH SERVICES  
P. O. BOX 476, ELLICOTT CITY, MARYLAND 21043  
TELEPHONE: 465-5000, EXT. 356

DISTRICT 5th

DATE 4/6/77

TO: THE COUNTY HEALTH OFFICER  
ELLICOTT CITY, MARYLAND

I, HEREBY, APPLY FOR THE NECESSARY TEST IN ORDER TO CONSTRUCT (OR RECONSTRUCT) A SEWAGE DISPOSAL SYSTEM.

PROPERTY OWNER Paul Bauman property Any questions call Mr. Snovell  
ADDRESS 4811 Nebraska Ave., Washington, D.C. 20016 PHONE 465-8518

PROPERTY LOCATION:

SUBDIVISION \_\_\_\_\_ LOT NO. 2

ROAD AND DESCRIPTION Pindell School Road

SIZE OF LOT 2.96 acres m/l TYPE BLDG. 3 or 4 bedrooms  
NUMBER OF BEDROOMS

IF NOT SINGLE RESIDENCE DESCRIBE \_\_\_\_\_

THE SYSTEM INSTALLED UNDER THIS APPLICATION IS ACCEPTABLE ONLY UNTIL PUBLIC FACILITIES BECOME AVAILABLE.

SIGNATURE OF APPLICANT /s/ Ted Snovell


APPROVED BY *Robert F. Jones* FOR \_\_\_\_\_ DATE 6/22/77  
(KIND OF SYSTEM)

REJECTED BY \_\_\_\_\_ FOR \_\_\_\_\_ DATE \_\_\_\_\_  
(KIND OF SYSTEM)

HOLD PENDING FURTHER TESTS \_\_\_\_\_ DATE \_\_\_\_\_

REASONS FOR REJECTION OR HOLDING \_\_\_\_\_

# THIS IS NOT A PERMIT

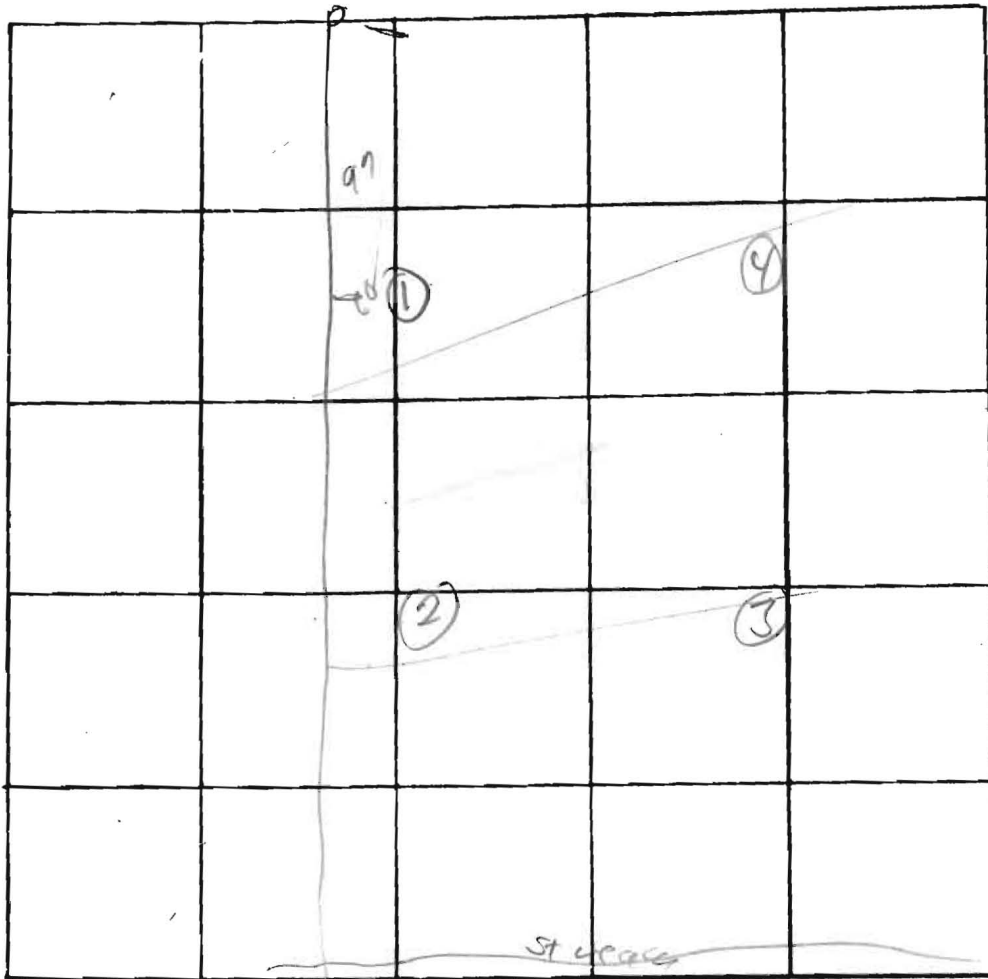

INDICATE NORTH - NAME ADJOINING ROADWAY AS BASE LINE

DATE	TEST NO.	DEPTH	PRE-WET		TEST - 1" DROP		TIME
			START	STOP	START	STOP	
5/19/64	1	1 1/2'	104	106	106	109	3
		9 1/4'	110	124	124	143	19
	2 S	4 (soil)	130	134	134	143	9
	4	12	132	136	136	146	10
	3 S	3	150	152	152	159	2
	d	13	150	153	153	205	13
	4	2-12'	Visual				

INLET  
2'  
BOTTOM  
9'

REMARKS hole 1 Rock 10' - 6-10 mostly sand - mica - rock  
 TYPE OF SOIL in thin layers - OK for sewer disposal  
 TESTED BY DJOH ALSO PRESENT: Robinson  
Snow