

12/8  
NCCW

# PERMIT

SEWAGE DISPOSAL SYSTEM

MARYLAND STATE DEPARTMENT OF HEALTH

P 40739

A REPAIR

DISTRICT \_\_\_\_\_

DATE 12/31/87

12/8/87

DATE SYSTEM APPROVED \_\_\_\_\_

INSPECTOR (Signature)

**HOWARD COUNTY**  
BUREAU OF ENVIRONMENTAL HEALTH  
461-9933

## INDEXED

Jack Fyock

IS PERMITTED TO INSTALL \_\_\_\_\_ ALTER X

ADDRESS \_\_\_\_\_ PHONE 988-9270

SUBDIVISION MAP 22 Q15 1/0 P.390 ROAD 13334 Folly Quarter Rd LOT 8

PROPERTY OWNER David A. Zellers Robert + Pamela Kulp.

ADDRESS \_\_\_\_\_

IF GARBAGE GRINDER IS USED INCREASE SEPTIC TANK CAPACITY BY 50% AND ABSORPTION AREA BY 22%.

GARBAGE GRINDER? YES \_\_\_\_\_ NO X

SEPTIC TANK CAPACITY 1000 GALLONS NUMBER OF BEDROOMS 3

REPAIR - CALL FOR INSPECTION WHEN GROUND IS OPENED UP SO SANITARIAN CAN RECOMMEND REPAIR.

Soils: orange / yellow clay (fairly heavy) 3 1/2'  
changing to orange / tan silty mica clay  
w/ few scattered hard rock frags.

PLANS APPROVED BY C. Williams DATE 11/24/87

COVER NO WORK UNTIL INSPECTED AND APPROVED.

NEITHER THE HOWARD COUNTY COUNCIL NOR THE HEALTH DEPARTMENT IS RESPONSIBLE FOR THE SUCCESSFUL OPERATION OF ANY SYSTEM.

NOTE: CLEANOUT REQUIRED EVERY 70 FEET OF SEWER LINE AND/OR AT 90° SWEEPS IN LINES FROM HOUSE TO DRAIN FIELDS.

NOTE: ALL PARTS OF SEPTIC SYSTEMS (I.E., TANK, DISTRIBUTION BOX, TRENCHES) TO BE 100 FEET FROM WELL. (UNLESS OTHERWISE SPECIFICALLY AUTHORIZED)

NOTE: IF DEEP TRENCH(IES) ARE USED CALL FOR INSPECTION BEFORE AND AFTER PLACING GRAVEL IN TRENCH(IES).

NOTE: NO DRY WELL SHALL EXCEED 15 FOOT IN DIAMETER. NO ABSORPTION TRENCH TO EXCEED 100 FEET IN LENGTH.

NOTE: ALL PIPE FROM HOUSE TO SEPTIC TANK MUST BE CAST IRON OR SCHEDULE 40 PVC OR ABS.

PERMIT VOID AFTER TWO YEARS.

NOTE: INSTALL STAND PIPE ON SEPTIC TANK AND DRY WELL. STAND PIPES MUST BE 6 INCHES IN DIAMETER. CAST IRON, CONCRETE OR TERRA COTTA OR PVC OR ABS ACCEPTED. IF TOP OF SEPTIC TANK IS DEEPER THAN 3 FEET, MANHOLE TO GRADE REQUIRED.

NOTE: DISTRIBUTION BOXES MUST HAVE BAFFLES.


BLDG PERMITS SHOWN  
AND RETURNED 11/8/00  
80027346 Fire plac

BLDG. PERMIT SIGNED  
AND RETURNED 7/9/93  
Serial # 49647-Addition

**\*INSTALLER IS RESPONSIBLE FOR OBTAINING FINAL APPROVAL ON THIS PERMIT**

\*CALL 461-9933 FOR INSPECTION OF SEPTIC SYSTEMS.

40739

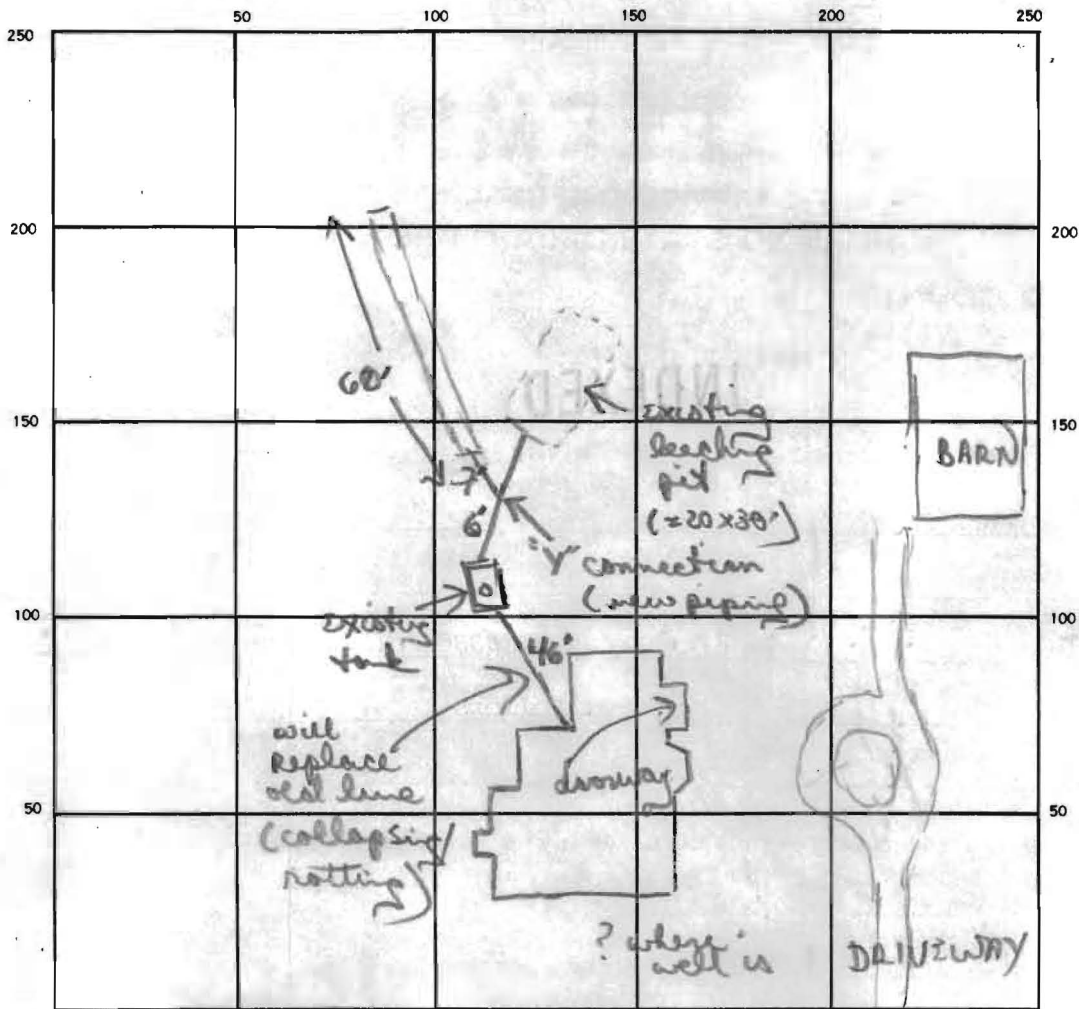

INDICATE NORTH — NAME ADJOINING ROADWAY AS BASE LINE

TRIAD RD ← FOLLY QUARTER RD

SEPTIC TANK. LEVEL 750 existing (concrete) CLEANOUTS 1 S.T. 60  
6.5  
30  
390

DISTRIBUTION BOX. LEVEL —

DRAIN FIELD/TILE FIELD. DEPTH 11 FT. TRENCH WIDTH 2 FT. INLET DEPTH 4 1/2 FT.

EFFECTIVE GRAVEL DEPTH 6 1/2 FT. TOTAL LENGTH 60 FT.

NUMBER OF TRENCHES 1 ONE SIDEWALL/BOTTOM AREA 390 SQ. FT.

DRYWELL INSIDE DIAMETER — FT. EFFECTIVE DEPTH BELOW INLET — FT.

ABSORBENT AREA 390 SQ. FT.

REMARKS 1/27/87 OK to go 4 1/2 - 11" w/ stone. Connected back to pit though pit full presently. OK to finish adding stone pipe paper to trench. OK to replace lines from house. OK to cover trench /y" connection + all work

DATE SYSTEM APPROVED 1/28/87 INSPECTOR B Nixon

SITE INSPECTION SHEET

410-531-5534

OWNER: Gil Gawthrop

DATE REQUESTED: 3/26/99 11:00

ADDRESS: 13334 Folly Quarter Rd.


DRILLER: G. Easterday

WELL TAG #

COUNTY # A 40739

PROPOSAL: To drill replacement well in order to replace existing hand dug well

LOCATION DIAGRAM

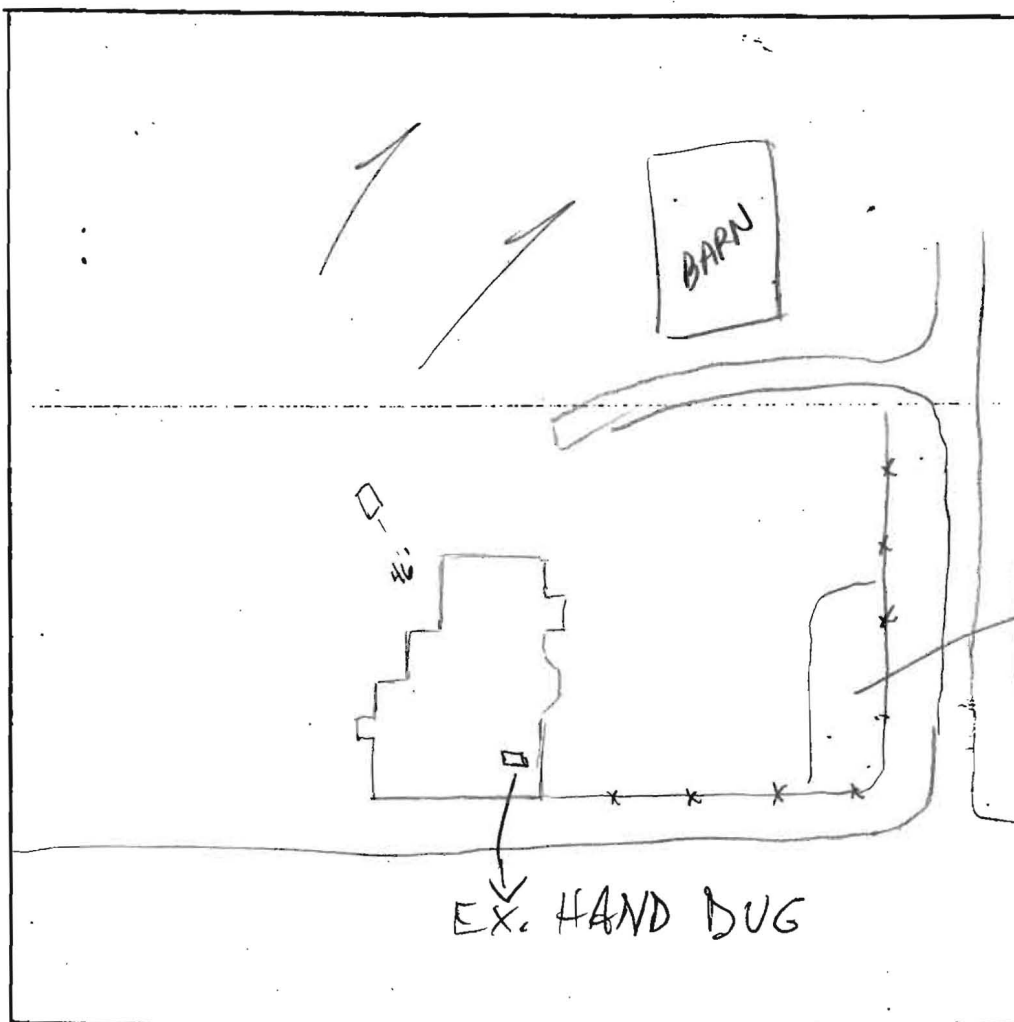

COMMENTS: 3/26/99 Existing well is in basement

5/19/99 NO WPI INSPECTION

DATE: 3/26/99

INSPECTOR: A McMillan