

*4/25/74*  
*4/29/74*

*file WWSZ*

*4/25/74*  
*Permit*

# PERMIT

SEWAGE DISPOSAL SYSTEM

MARYLAND STATE DEPARTMENT OF HEALTH

HOWARD COUNTY

P 19742

A

ELLCOTT CITY

DISTRICT 4

DATE 4/1/74

INDEXED

Herman Sirk IS PERMITTED TO INSTALL ALTER

ADDRESS Annapolis Rock Road, Woodbine, Md. PHONE 489-4724

A SEWAGE DISPOSAL SYSTEM LOCATED AT \_\_\_\_\_

SUBDIVISION \_\_\_\_\_ ROAD 14035 Forsythe Rd. LOT \_\_\_\_\_

PROPERTY OWNER Sam T. Crouch & Catherine Crouch  
1st house on right off Rt. 97

ADDRESS \_\_\_\_\_

SPECIFICATIONS

DRAIN FIELD \_\_\_\_\_ DEPTH \_\_\_\_\_ FEET, BOTTOM AREA \_\_\_\_\_ SQ. FT.

SEEPAGE PITS \_\_\_\_\_ ABSORBENT SIDE-WALL AREA \_\_\_\_\_ SQ. FT.

SEPTIC TANK CAPACITY \_\_\_\_\_ GALLONS

FOR GARBAGE GRINDER, INCREASE DISPOSAL AREA 22% & TANK CAPACITY 50%

OTHER REPAIR - Call for inspection when ground is opened up and Sanitarian can  
recommend repair system. 50ft trench - 8ft deep with 6" poly stone

R.T.


PLANS APPROVED BY P. F. Wine DATE 4/1/74

FILL SEPTIC TANK AND DISTRIBUTION BOX WITH WATER BEFORE CALLING FOR AN INSPECTION. COVER NO WORK UNTIL INSPECTED AND APPROVED.

NEITHER THE HOWARD COUNTY COMMISSIONERS NOR THE HEALTH DEPARTMENT IS RESPONSIBLE FOR THE SUCCESSFUL OPERATION OF ANY SYSTEM.

*Well ?*  
*3 bedroom - 58'*  
*4 bedroom - 78'*  
*0.27*

*P 19742*

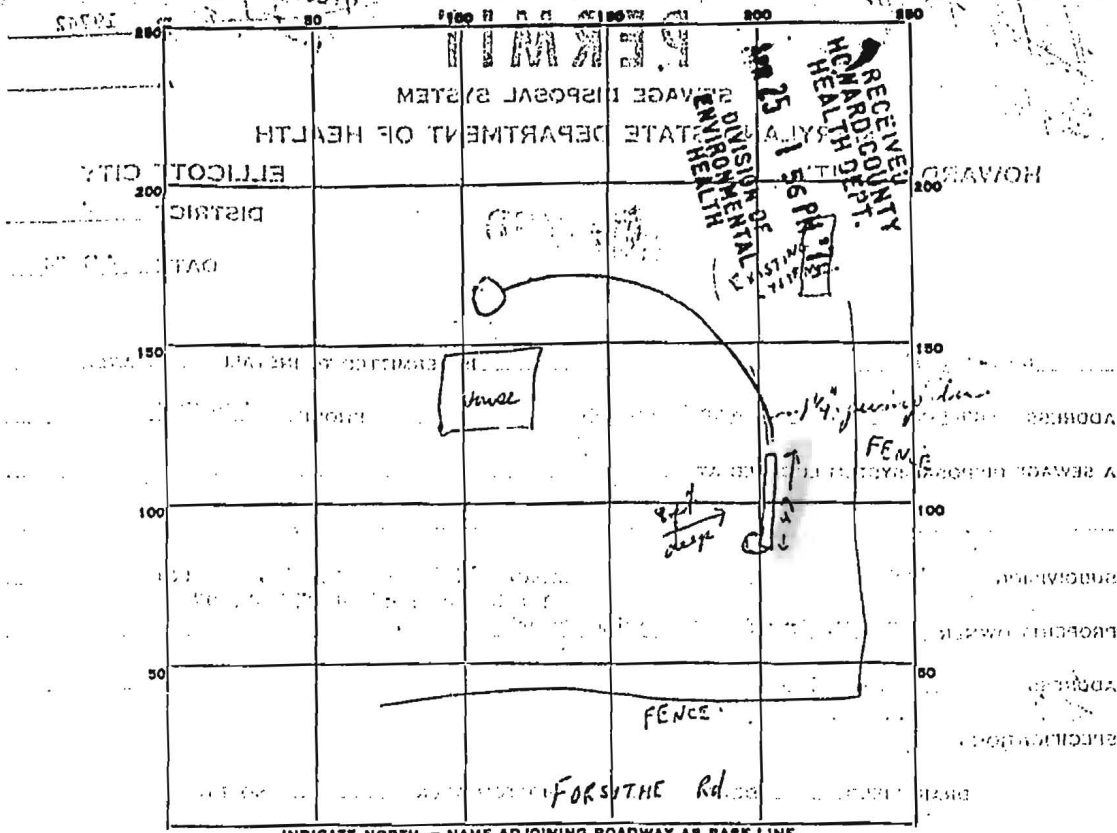

INDICATE NORTH. - NAME ADJOINING ROADWAY AS BASE LINE.

PERMIT CARD \_\_\_\_\_

SEPTIC TANK, LEVEL \_\_\_\_\_ CLEANOUTS \_\_\_\_\_

DISTRIBUTION BOX, LEVEL \_\_\_\_\_

Trench  
FIELD, DEPTH 8 FT. TRENCH WIDTH 9 1/2 FT.

GRAVEL DEPTH \_\_\_\_\_ IN. TOTAL LENGTH \_\_\_\_\_ FT.

NUMBER OF TRENCHES 1 Individual  
TOTAL BOTTOM AREA \_\_\_\_\_

SEEPAGE PITS, INSIDE DIAMETER \_\_\_\_\_ FT. DEPTH BELOW INLET \_\_\_\_\_ FT.

ABSORBENT AREA \_\_\_\_\_ SQ. FT.

REMARKS 4/26/74 - Nothing rock at bottom of trench. Soil appears good.

Gave OK to fill with stone. Use 6" ft system.

4/29/74 1/2 in to w/in 10' of top of ground. 1 1/2' dia

(VC) from pump pit to trench.

DATE SYSTEM APPROVED 4/29/74 INSPECTOR William H. Zapp