

# APPLICATION

PERCOLATION TESTING

A 40503  
P \_\_\_\_\_

HOWARD COUNTY HEALTH DEPARTMENT  
BUREAU OF ENVIRONMENTAL HEALTH  
P.O. BOX 476 ELLICOTT CITY, MARYLAND 21043  
TELEPHONE: 461-9933

*1/21/88  
perc OK'd pending  
pld (12)*

DISTRICT \_\_\_\_\_

DATE \_\_\_\_\_

TO: THE COUNTY HEALTH OFFICER  
ELLICOTT CITY, MARYLAND

I, HEREBY, APPLY FOR THE NECESSARY TEST IN ORDER TO CONSTRUCT (OR RECONSTRUCT) A SEWAGE DISPOSAL SYSTEM.

PROPERTY OWNER \_\_\_\_\_

ADDRESS \_\_\_\_\_ PHONE \_\_\_\_\_

PROSPECTIVE BUYER \_\_\_\_\_

ADDRESS \_\_\_\_\_ PHONE \_\_\_\_\_

PROPERTY LOCATION:

SUBDIVISION TSW OAKS LOT NO. 3

ROAD AND DESCRIPTION perc field to be dug for lot 3 on what was back area of lot 1 on sketch plan

TAX MAP \_\_\_\_\_ PARCEL # \_\_\_\_\_

SIZE OF LOT \_\_\_\_\_ TYPE BLDG \_\_\_\_\_  
(SINGLE FAMILY DWELLING OR COMMERCIAL)

THE SYSTEM INSTALLED UNDER THIS APPLICATION IS ACCEPTABLE ONLY UNTIL PUBLIC FACILITIES BECOME AVAILABLE. I FULLY UNDERSTAND THE FEE CONNECTED WITH THE FILING OF THIS PERC TEST APPLICATION IS NON-REFUNDABLE UNDER ANY CIRCUMSTANCES. I ALSO AGREE TO COMPLY WITH ALL M.O.S.H.A. REQUIREMENTS IN TESTING THIS LOT.

(SIGNATURE OF APPLICANT)

APPROVED BY \_\_\_\_\_ FOR \_\_\_\_\_ DATE \_\_\_\_\_

REJECTED BY \_\_\_\_\_ FOR \_\_\_\_\_ DATE \_\_\_\_\_

HOLD PENDING FURTHER TESTS \_\_\_\_\_ DATE \_\_\_\_\_


REASONS FOR REJECTION OR HOLDING for field located holes, lot line redesign house & well sets

HD-216

# THIS IS NOT A PERMIT

A + E  
SOIL PROFILE

purple/brown  
clay 3'  
clay/silt  
loam 4 1/2'  
to gritty  
sandy  
silty loam 7 1/2'  
white gritty  
kaolinitic  
silty/silt  
loam 12 1/2' D

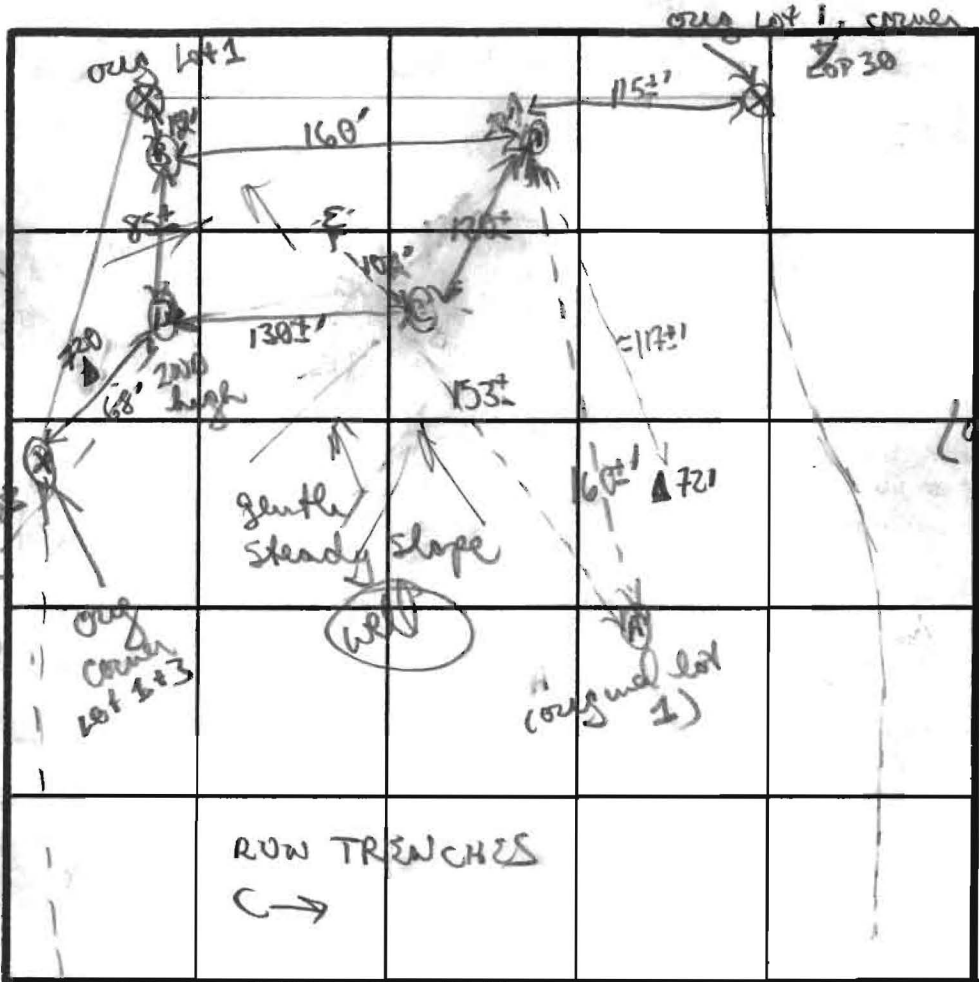

C  
brown/red  
purple  
clay loam  
(4-5' few  
frag) 4 1/2'  
silty mica  
loam 2-5%  
small  
hard  
weathered  
frag  
13 1/2' D  
INLET 4'  
MAX D 8'

B  
purple/orange  
clay loam 4'  
to gritty/  
gravelly tan  
purple silty  
loam  
13'  
D

purple/orange  
clay/gravelly  
loam  
(4-5' few  
gravel frags)  
to mostly  
purple/orange  
silty loam w/  
5-10% few

INDICATE NORTH - NAME ADJOINING ROADWAY AS BASE LINE.

will be field located as

DATE	TEST NO.	DEPTH	PRE-WET		TEST - 1" DROP		TIME	
			START	STOP	START	STOP		
1/2/58	(G) A	4 1/2' S	245	249	249	258	9min	
		12 1/2' D	bottom (see profile)					
	(H) B	4' S	245	248	248	252	4min	
		8' M	245	252	252	307	15min	
		13' D	bottom (see profile)					
	(I) C	3 1/2' S	311	314	314	320	6min	
		13 1/2' D	bottom (see profile)					
	(J) D	4 1/2' S	259	301	301	306	5min	
		12 1/2' D	bottom (see profile)					
	(K) E	Visual only	12' D	GOOD	SOILS	4" ↓		

REMARKS Lot line redesign (Lot 1+3 will be necessary)  
TYPE OF SOIL Purple clays; purple tan/brown silty mica loams  
TESTED BY B Wilson ALSO PRESENT John S., Keith, Brian

# APPLICATION

PERCOLATION TESTING

A 40503

P \_\_\_\_\_

HOWARD COUNTY HEALTH DEPARTMENT  
BUREAU OF ENVIRONMENTAL HEALTH  
P.O. BOX 476 ELLICOTT CITY, MARYLAND 21043  
TELEPHONE: 461-9933

*1/13/88  
perc unsatisfactory  
1/19/88  
visual hole unsat.*

DISTRICT 5TH

DATE 10-29-87

TO: THE COUNTY HEALTH OFFICER  
ELLICOTT CITY, MARYLAND

I, HEREBY, APPLY FOR THE NECESSARY TEST IN ORDER TO CONSTRUCT (OR RECONSTRUCT) A SEWAGE DISPOSAL SYSTEM.

PROPERTY OWNER LOWRIE SARGENT

ADDRESS 13243 WESTMEATH LANE PHONE 498-4334  
CLARKSVILLE, MARYLAND 21029

PROSPECTIVE BUYER \_\_\_\_\_

ADDRESS \_\_\_\_\_ PHONE \_\_\_\_\_

PROPERTY LOCATION:

SUBDIVISION TEN OAKS LOT NO. 3

ROAD AND DESCRIPTION WEST OF HIGHLAND ROAD, NORTH OF TRIADELPHIA ROAD

TAX MAP 28+34 PARCEL # 60, 59  
30+64

SIZE OF LOT 3.0 Ac. TYPE BLDG SFD  
(SINGLE FAMILY DWELLING OR COMMERCIAL)

THE SYSTEM INSTALLED UNDER THIS APPLICATION IS ACCEPTABLE ONLY UNTIL PUBLIC FACILITIES BECOME AVAILABLE. I FULLY UNDERSTAND THE FEE CONNECTED WITH THE FILING OF THIS PERC TEST APPLICATION IS NON-REFUNDABLE UNDER ANY CIRCUMSTANCES. I ALSO AGREE TO COMPLY WITH ALL M.O.S.H.A. REQUIREMENTS IN TESTING THIS LOT.

*[Signature]*  
(SIGNATURE OF APPLICANT)

APPROVED BY \_\_\_\_\_ FOR \_\_\_\_\_ DATE \_\_\_\_\_

REJECTED BY \_\_\_\_\_ FOR \_\_\_\_\_ DATE \_\_\_\_\_


HOLD PENDING FURTHER TESTS \_\_\_\_\_ DATE \_\_\_\_\_

REASONS FOR REJECTION OR HOLDING heavy clays to deep (6-7') levels. Insuff. depth to get system in. H<sub>2</sub>O in 200 high hole

# THIS IS NOT A PERMIT

**B**  
SOIL PROFILE

D  
heavy brown  
orange clay  
4 1/2  
to gritty  
orange brown  
clay sandy  
loam  
5 1/2  
to mostly  
white gravelly  
silty sandstone  
13' D

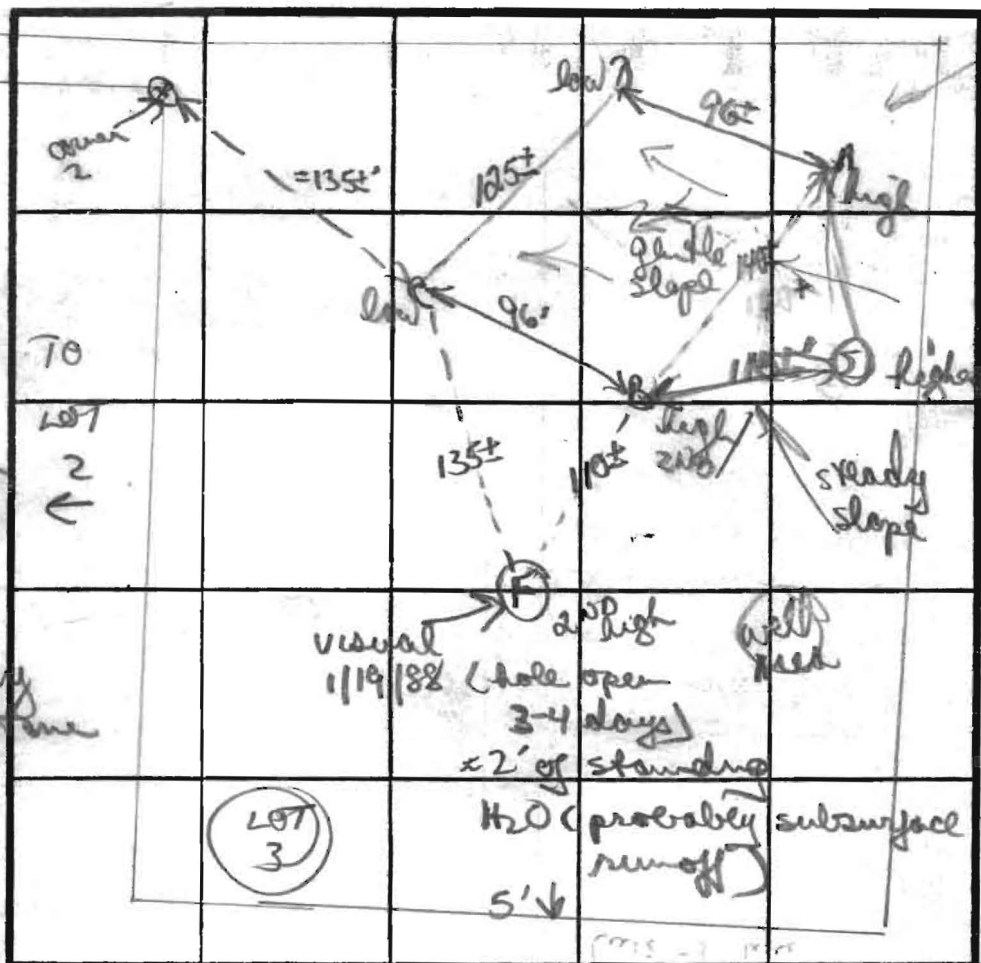

A & Z  
similar  
to B w/  
clays to 6'  
gradually  
to white  
gravelly  
micaceous  
mix  
13' D + 20  
F  
yellow brown  
clay (chunky  
gritty)

C  
orange/brown  
chunky gravelly  
clay 5'  
changing to  
tan white  
orange gritty  
gravelly mic  
silty loam 6'

12' D  
D  
similar to  
C w/ gravelly  
clays to  
6'


INDICATE NORTH - NAME ADJOINING ROADWAY AS BASE LINE

E 6 1/2 S 337 400 STOPPED = 341°

DATE	TEST NO.	DEPTH	PRE-WET		TEST - 1" DROP		TIME	
			START	STOP	START	STOP		
1/13/88	A	5' S	226	239	239	303	24min = 7' D	
		8' M	228	238	236	252	16min	
		13' D	bottom (see profile)					
	C	6' S	240	301	301	336	35min	
		13' D	bottom (see profile)					
	D	7' S	249	310	310	342	27min	
		12' D	bottom (see profile)					
	A	6' S	DID NOT TEST					
		≈ 9' M	300	321	321	351	≈ 1/2 - 3/4"	
		13' D	bottom (see profile)					

added extra hole for A area / slow pores

REMARKS: deep clays on all holes, silty clays w/ white gravelly mic. (short below)  
 TYPE OF SOIL: \_\_\_\_\_  
 TESTED BY: B Nyfan ALSO PRESENT: Keith, Pat

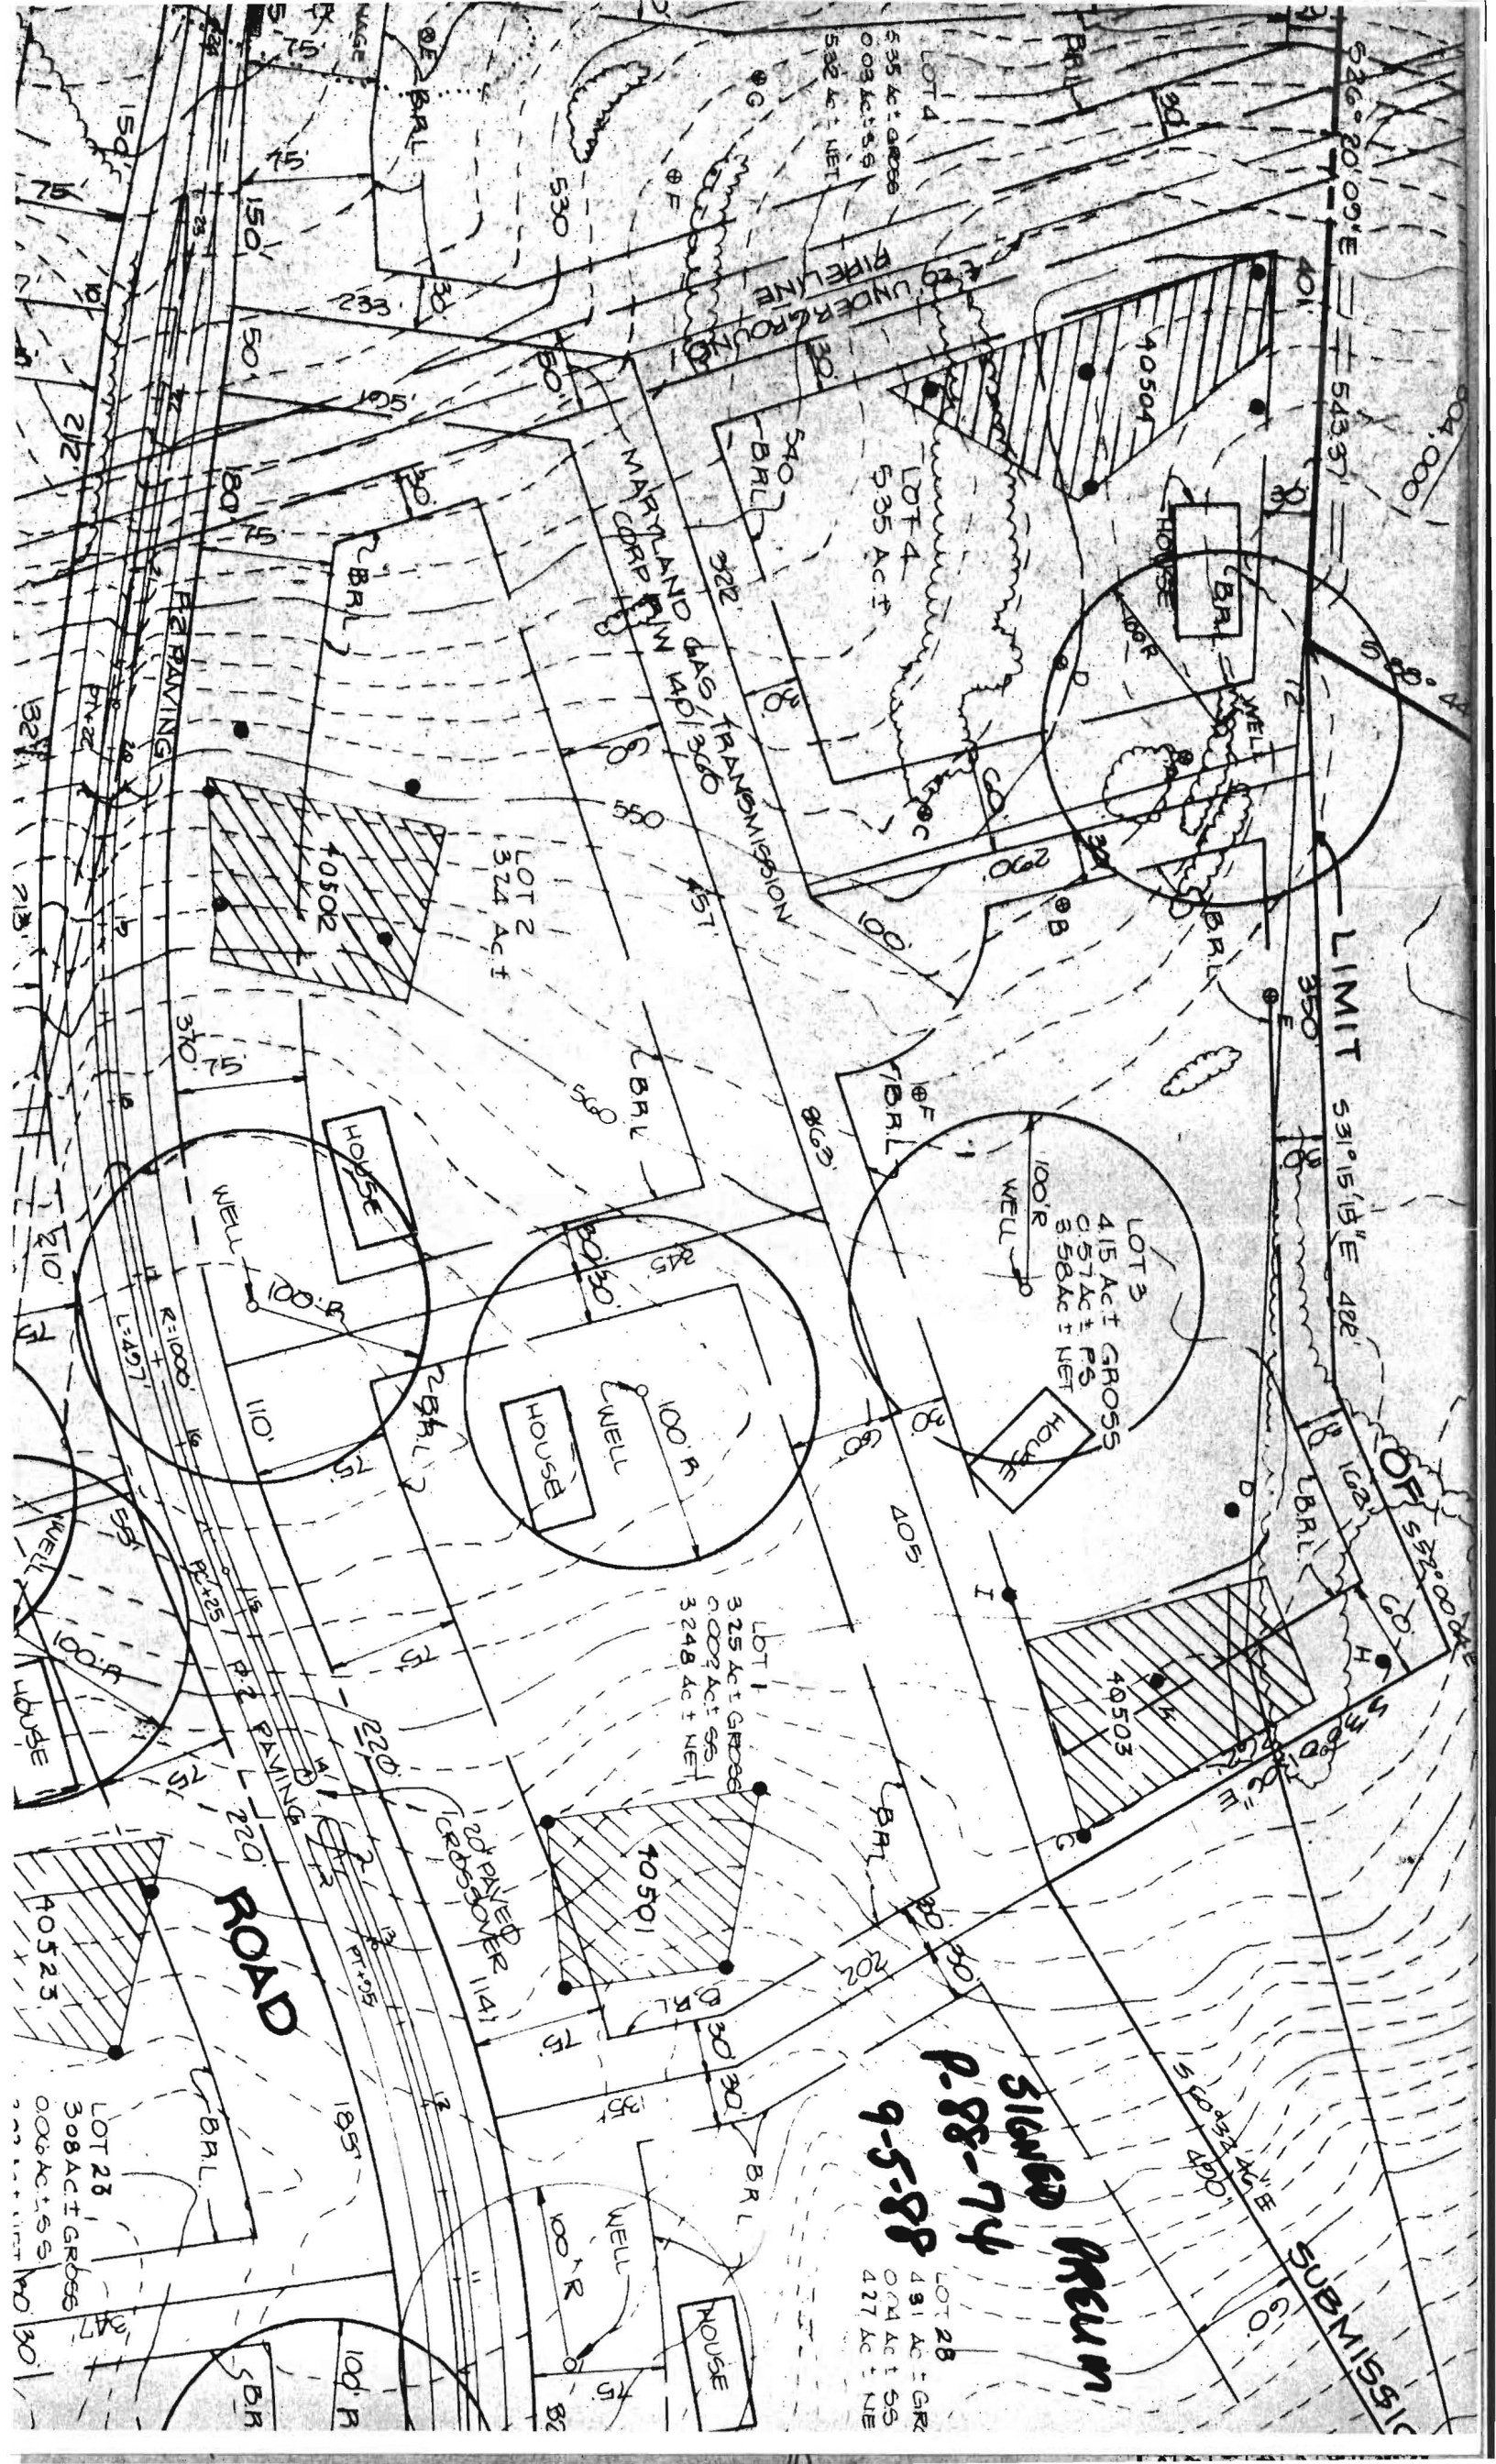

526° 20' 09" E = 543.37'

LIMIT 531° 15' 15" E 482'

SUBMISSION

SIGNED PERMITS  
 P-88-74  
 9-5-88

LOT 28  
 4.91 AC ± GR  
 0.04 AC ± SS  
 4.27 AC ± NE

LOT 4  
 5.35 AC ± GROSS  
 0.03 AC ± SS  
 5.32 AC ± NET

LOT 4  
 5.35 AC ± F

LOT 2  
 3.74 AC ± F

LOT 1  
 3.25 AC ± GROSS  
 0.002 AC ± SS  
 3.248 AC ± NE

LOT 28  
 3.08 AC ± GROSS  
 0.06 AC ± SS

ROAD

ELECTRIC UNDERGROUND

NATURAL GAS TRANSMISSION

PARKING

PARKING

ROAD

BARN

BARN

HOUSE

HOUSE

WELL

WELL

30'

30'

150'

150'

50'

50'

150'

150'


150'

150'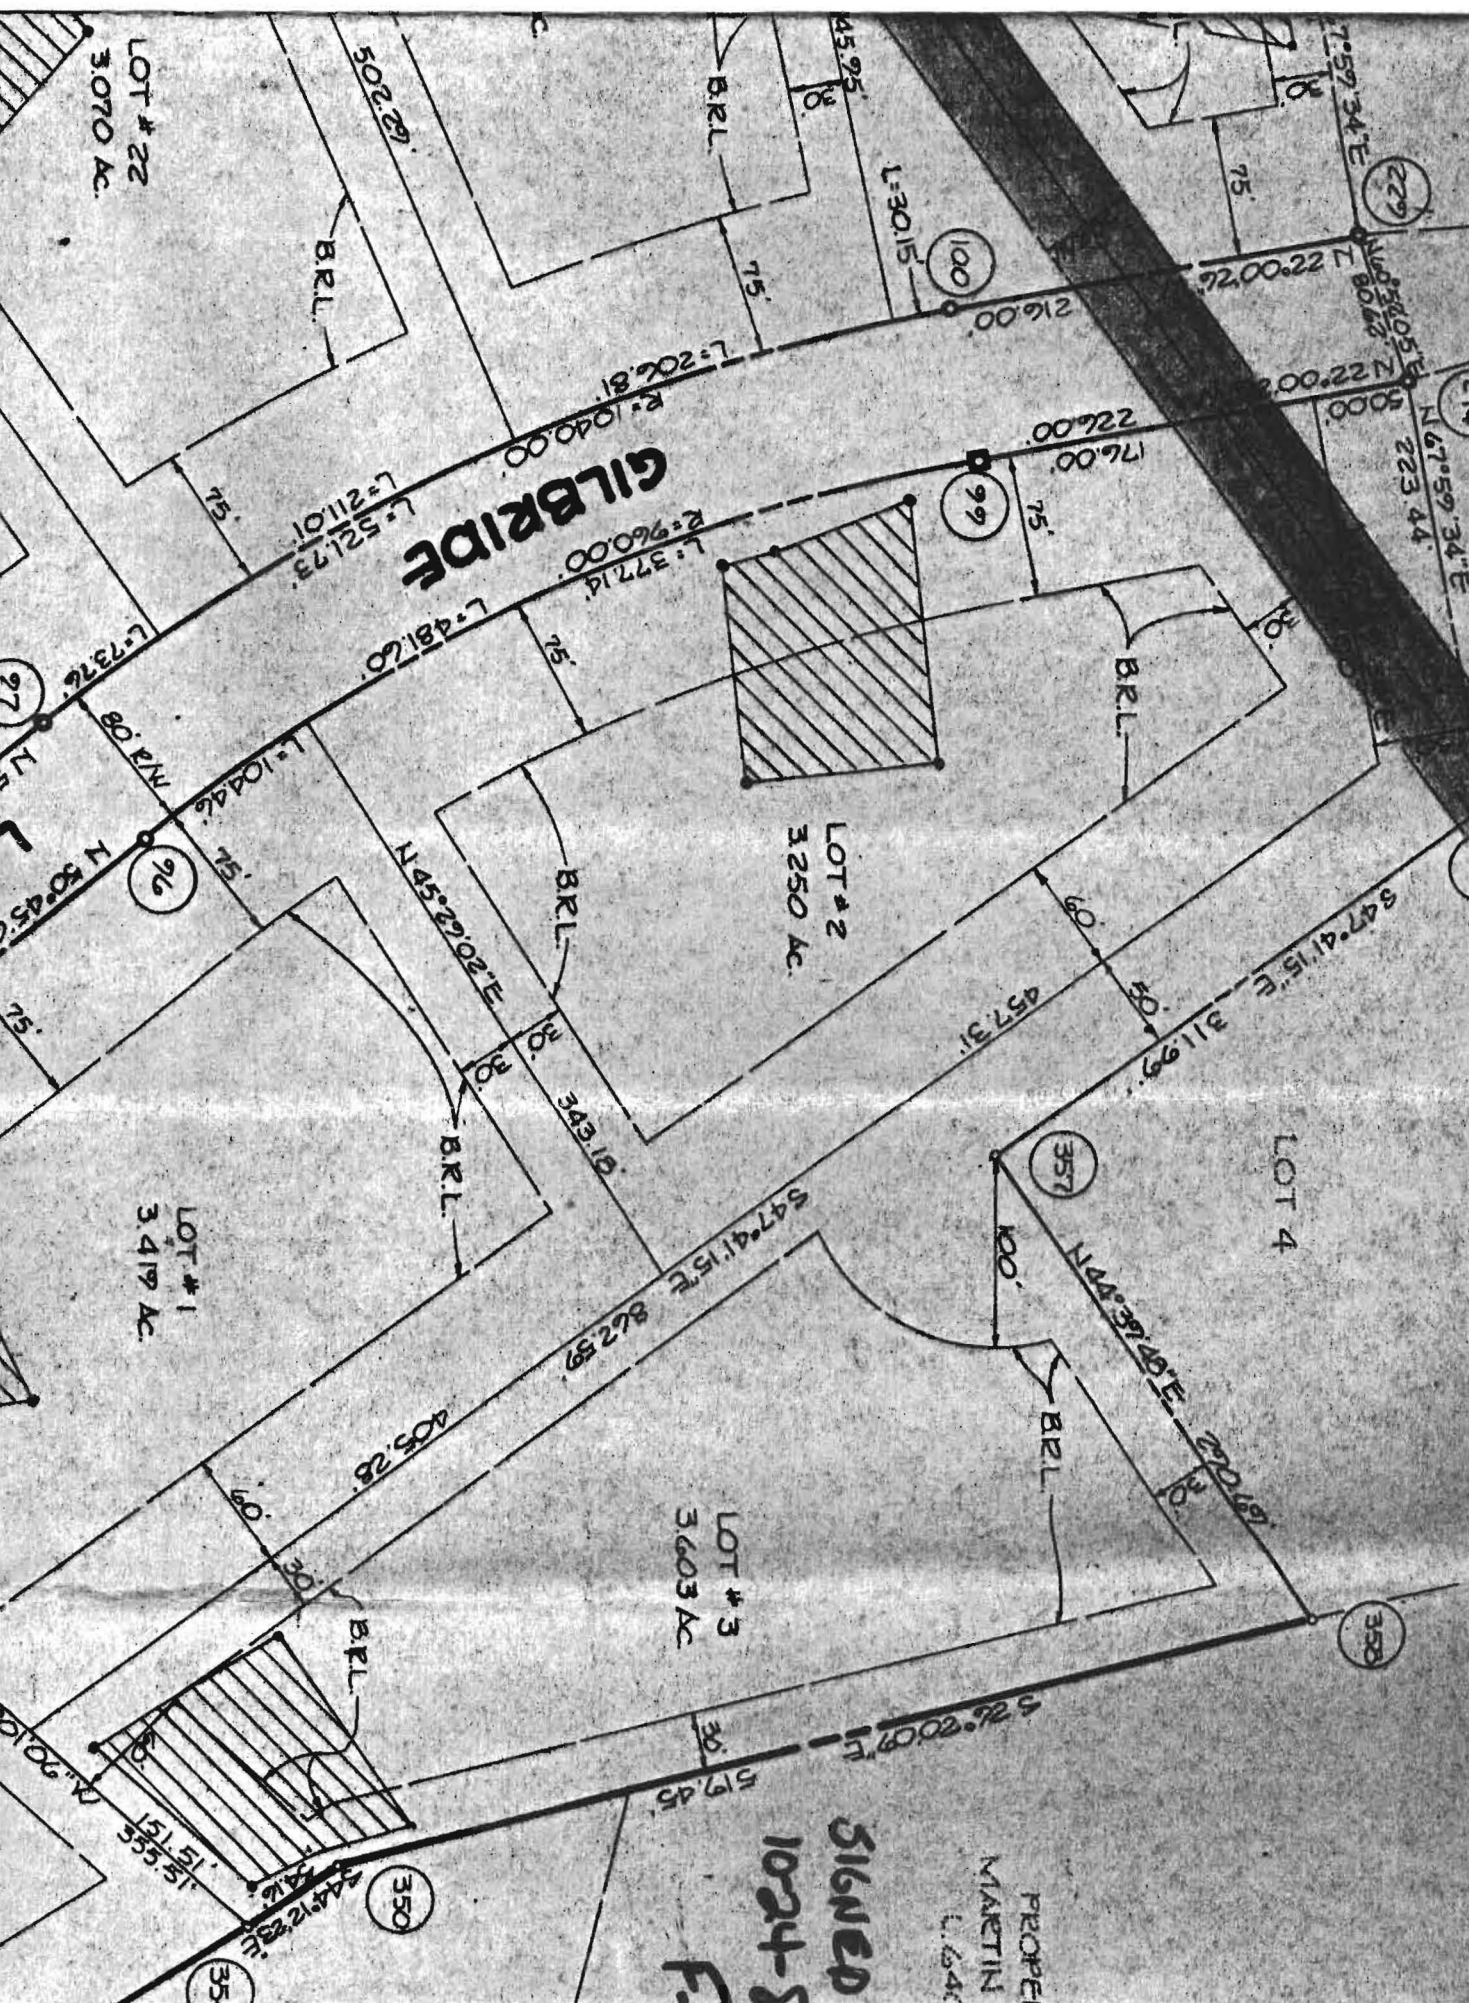

**GILBRIDE**


**SIGNED RMT**  
**1024-89**  
**F-89-111**

PROPERTY OF  
 MARTIN S. THALER  
 L. 640, F. 271

PROPERTY OF  
 MARTIN S. THALER  
 L. 1911, F. 636

No	RAD.	Δ
293-92	760.00'	13° 31'
97-100	1040.00'	28° 44'
99-96	960.00'	28° 44'
91-248	840.00'	13° 31'
248-245	840.00'	16° 18'
91-245	840.00'	29° 49'

Click here for a plain text ADA compliant screen.

	<b>Maryland Department of Assessments and Taxation</b> <b>HOWARD COUNTY</b> <b>Real Property Data Search</b>	<a href="#">Go Back</a> <a href="#">View Map</a> <a href="#">New Search</a>
---	--	---

**Account Identifier:** District - 05 Account Number - 411629

Owner Information
-------------------

<b>Owner Name:</b>	SHAW DANIEL J SHAW DAWN R T/E	<b>Use:</b>	RESIDENTIAL
		<b>Principal Residence:</b>	NO
<b>Mailing Address:</b>	13622 GILBRIDE LN CLARKSVILLE MD 21029-1018	<b>Deed Reference:</b>	1) / 5399/ 21 2)

Location & Structure Information
----------------------------------

<b>Premises Address</b>	<b>Zoning</b>	<b>Legal Description</b>
NE GILBRIDE LN CLARKSVILLE 21029	RRDEO	LOT 3 3.603 A GILBRIDE LN HEDGEROW SEC 1

Map	Grid	Parcel	Sub District	Subdivision	Section	Block	Lot	Group	Plat No:	8932
28	20	30					3	81	Plat Ref:	

<b>Special Tax Areas</b>	<b>Town Ad Valorem Tax Class</b>	NO A/V, NO M/P, RURAL FIRE TAX
--------------------------	----------------------------------	--------------------------------

<b>Primary Structure Built</b>	<b>Enclosed Area</b>	<b>Property Land Area</b>	<b>County Use</b>
0000		3.60 AC	

<b>Stories</b>	<b>Basement</b>	<b>Type</b>	<b>Exterior</b>

Value Information
-------------------

	Base Value	Value As Of 01/01/2002	Phase-in Assessments As Of 07/01/2003	Phase-in Assessments As Of 07/01/2004
<b>Land:</b>	178,500	268,500		
<b>Improvements:</b>	0	0		
<b>Total:</b>	178,500	268,500	238,500	268,500
<b>Preferential Land:</b>	0	0	0	0

Transfer Information
----------------------

<b>Seller:</b> GANT JOHN CALVIN	<b>Date:</b> 03/28/2001	<b>Price:</b> \$335,000
<b>Type:</b> UNIMPROVED ARMS-LENGTH	<b>Deed1:</b> / 5399/ 21	<b>Deed2:</b>
<b>Seller:</b> HEDGEROW ASSOCIATED	<b>Date:</b> 10/01/1996	<b>Price:</b> \$145,000
<b>Type:</b> UNIMPROVED ARMS-LENGTH	<b>Deed1:</b> / 3823/ 556	<b>Deed2:</b> / 1920/ 665
<b>Seller:</b>	<b>Date:</b>	<b>Price:</b>
<b>Type:</b>	<b>Deed1:</b>	<b>Deed2:</b>

Exemption Information
-----------------------

<b>Partial Exempt Assessments</b>	<b>Class</b>	07/01/2003	07/01/2004
<b>County</b>	000	0	0
<b>State</b>	000	0	0
<b>Municipal</b>	000	0	0


**Tax Exempt:** NO  
**Exempt Class:**

**Special Tax Recapture:**

\* NONE \*

	<b>Maryland Department of Assessments and Taxation</b> <b>HOWARD COUNTY</b> <b>Real Property Data Search</b>	<a href="#">Go Back</a> <a href="#">View Map</a> <a href="#">New Search</a>
--	--	---

District - 05 Account Number - 411629

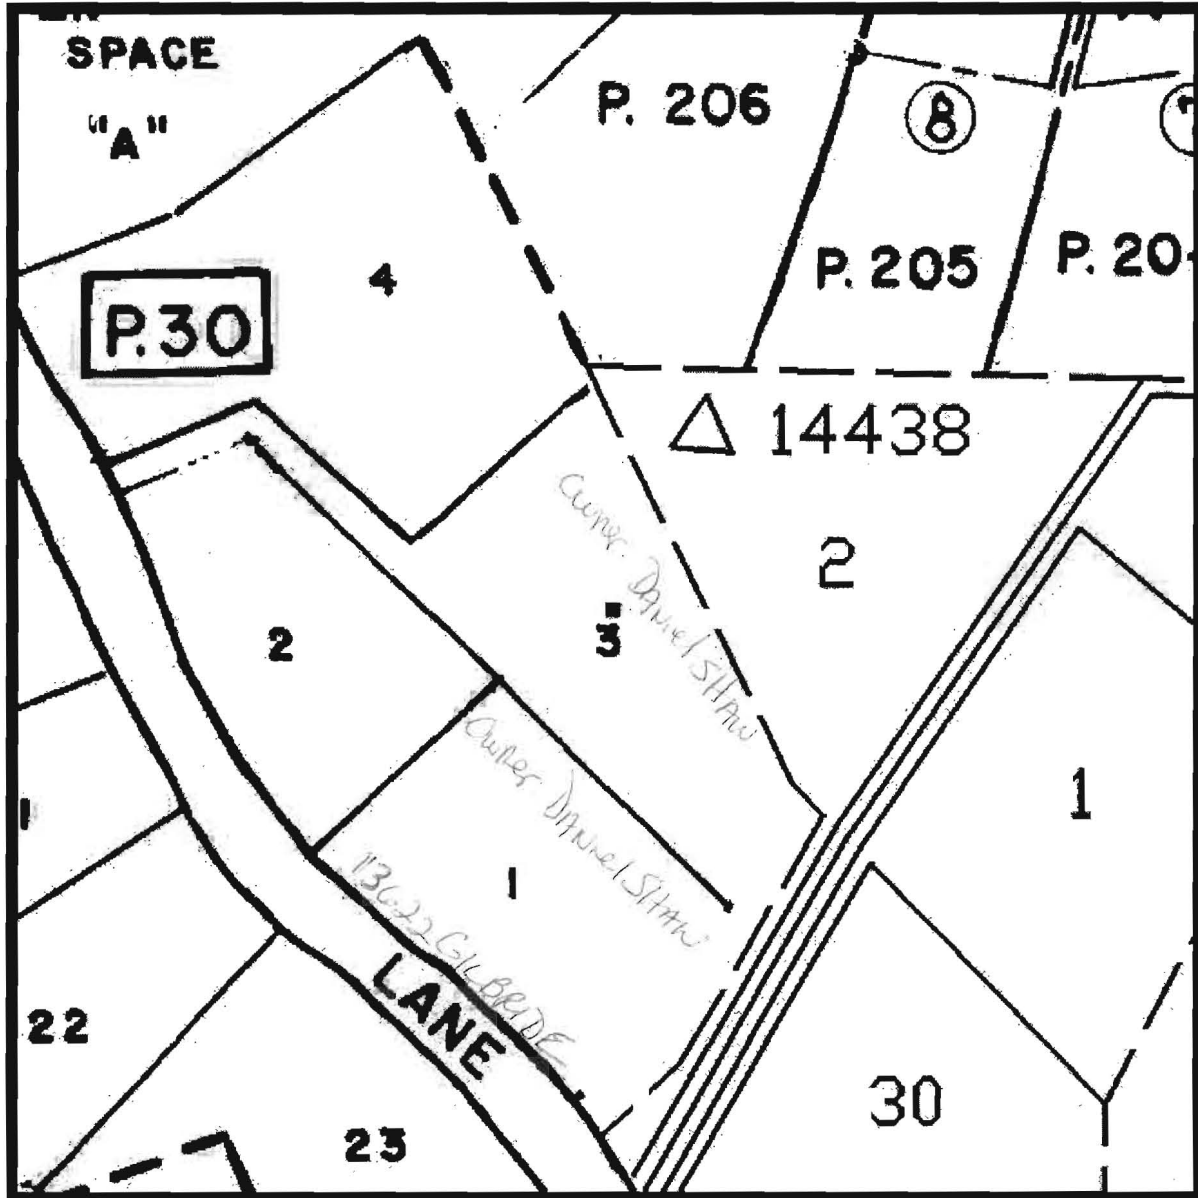

Property maps provided courtesy of the Maryland Department of Planning ©2001.  
For more information on electronic mapping applications, visit the Maryland Department of Planning  
web site at [www.mdp.state.md.us/webcom/index.html](http://www.mdp.state.md.us/webcom/index.html)