

DEPARTMENT OF INSPECTIONS, LICENSES & PERMITS 3430 COURT HOUSE DRIVE ELLICOTT CITY, MD 21043 PERMITS (410) 313-2455 INSPECTIONS (410) 313-1850	HOWARD COUNTY RESIDENTIAL HEATING-VENTILATION-AIR CONDITIONING AND REFRIGERATION PERMIT APPLICATION	HVACR PERMIT # <u>M100000-76</u> BUILDING PERMIT #
---	---	---

BUILDING ADDRESS: SUITE/A T: <u>2850 GLENWOOD SPRINGS DRIVE</u> SUBDIVISION: CENSUS TRACT: SECTION: AREA: <u>2</u> LOT: <u>22</u> TAX MAP: PARCEL: BLOCK: ZONE: PROPERTY ID: MAP COORDINATES: <u>14-17-</u> <u>04-346653</u> REPAIR- <u>229</u> TYPE OF IMPROVEMENTS: MENT USE: <u>RES</u>	OWNERS NAME: <u>DENNIS SMITH</u> ADDRESS: <u>2850 GLENWOOD SPRINGS DRIVE</u> CITY: <u>GLENWOOD</u> STATE: <u>MD</u> ZIP CODE: <u>21738</u> HOME PHONE: <u>443-717-4079</u> WORK PHONE:
--	--

CHECK ONE	HOW MANY	COMPANY NAME: Ground Loop Heating & Air Cond., Inc. LICENSEE NAME: Michael E. Cullum ADDRESS: 1701 Whiteford Road CITY: Darlington STATE: MD ZIP CODE: 21034 PHONE: 410-866-1706 HVACR LICENSE NO: 6539
SINGLE FAMILY DWELLING ZONES <input checked="" type="checkbox"/>	<u>2</u>	<div style="position: absolute; top: 50%; left: 50%; transform: translate(-50%, -50%); opacity: 0.5;"> 2/12/2010 Mechanical Permit Approved (BB) </div>
SINGLE FAMILY TOWNHOUSE ZONES <input type="checkbox"/>		
MULTI-FAMILY / HOTEL/MOTEL UNITS <input type="checkbox"/>		

New <input type="checkbox"/> Heating and Air Conditioning Replacement <input type="checkbox"/> Heating <input type="checkbox"/> Air Conditioning <input checked="" type="checkbox"/> Heating and Air Conditioning	EQUIPMENT: <u>WATER FURNACE</u> <input type="checkbox"/> Heating System Only <input checked="" type="checkbox"/> Other Work (Describe): <u>GEOTHERMAL</u> Additions and Alterations <input type="checkbox"/> Heating <input type="checkbox"/> Air Conditioning <input type="checkbox"/> Heating and Air Conditioning
--	---

Zones Permit Fee = # of Zones x \$40 = <u>80.00</u> Technology Fee (10% of Permit Fee) = <u>8.00</u> Plus Application Fee <u>\$50</u> Total Fees Due = <u>\$138.00</u>	Units Permit Fee = # of Units x \$80 = _____ Technology Fee (10% of Permit Fee) = _____ Plus Application Fee \$50 _____ Total Fees Due = <u>\$50</u>
--	--

I HAVE CAREFULLY EXAMINED AND READ THIS APPLICATION AND KNOW IT IS TRUE AND CORRECT. THE WORK DESCRIBED HEREIN WILL BE PERFORMED BY A STATE HVACR LICENSED PERSON(S), AND ALL WORK WILL BE PERFORMED IN COMPLIANCE WITH APPLICABLE CODES AND STANDARDS OF HOWARD COUNTY THE STATE OF MARYLAND.

SIGNATURE OF LICENSEE: Michael E. Cullum
 DATE: 1-20-10
 PRINT NAME OF LICENSEE: _____

Validation Check Number: <u>14562</u> Cash: _____ Receipt Number: <u>195366</u>

Make check payable to: DIRECTOR OF FINANCE OF HOWARD COUNTY
 Word doc: HVAC APPLICATION - JUNE 2004

Glenwood Springs
 51 Lot 22
 4346653

WELL & SEPTIC



2850 Glenwood Springs Dr, Glenwood, MD 21738

Image U.S. Geological Survey
© 2009 Europa Technologies
© 2009 Google


Google

Imagery Date: Mar 1, 2007

39°17'31.18" N 77°01'23.49" W elev 564 ft

Eye alt 893 ft

HOME OWNER:
 DENNIS SMITH
 2850 GLENWOOD SPRINGS
 GLENWOOD, MD 21738-9700

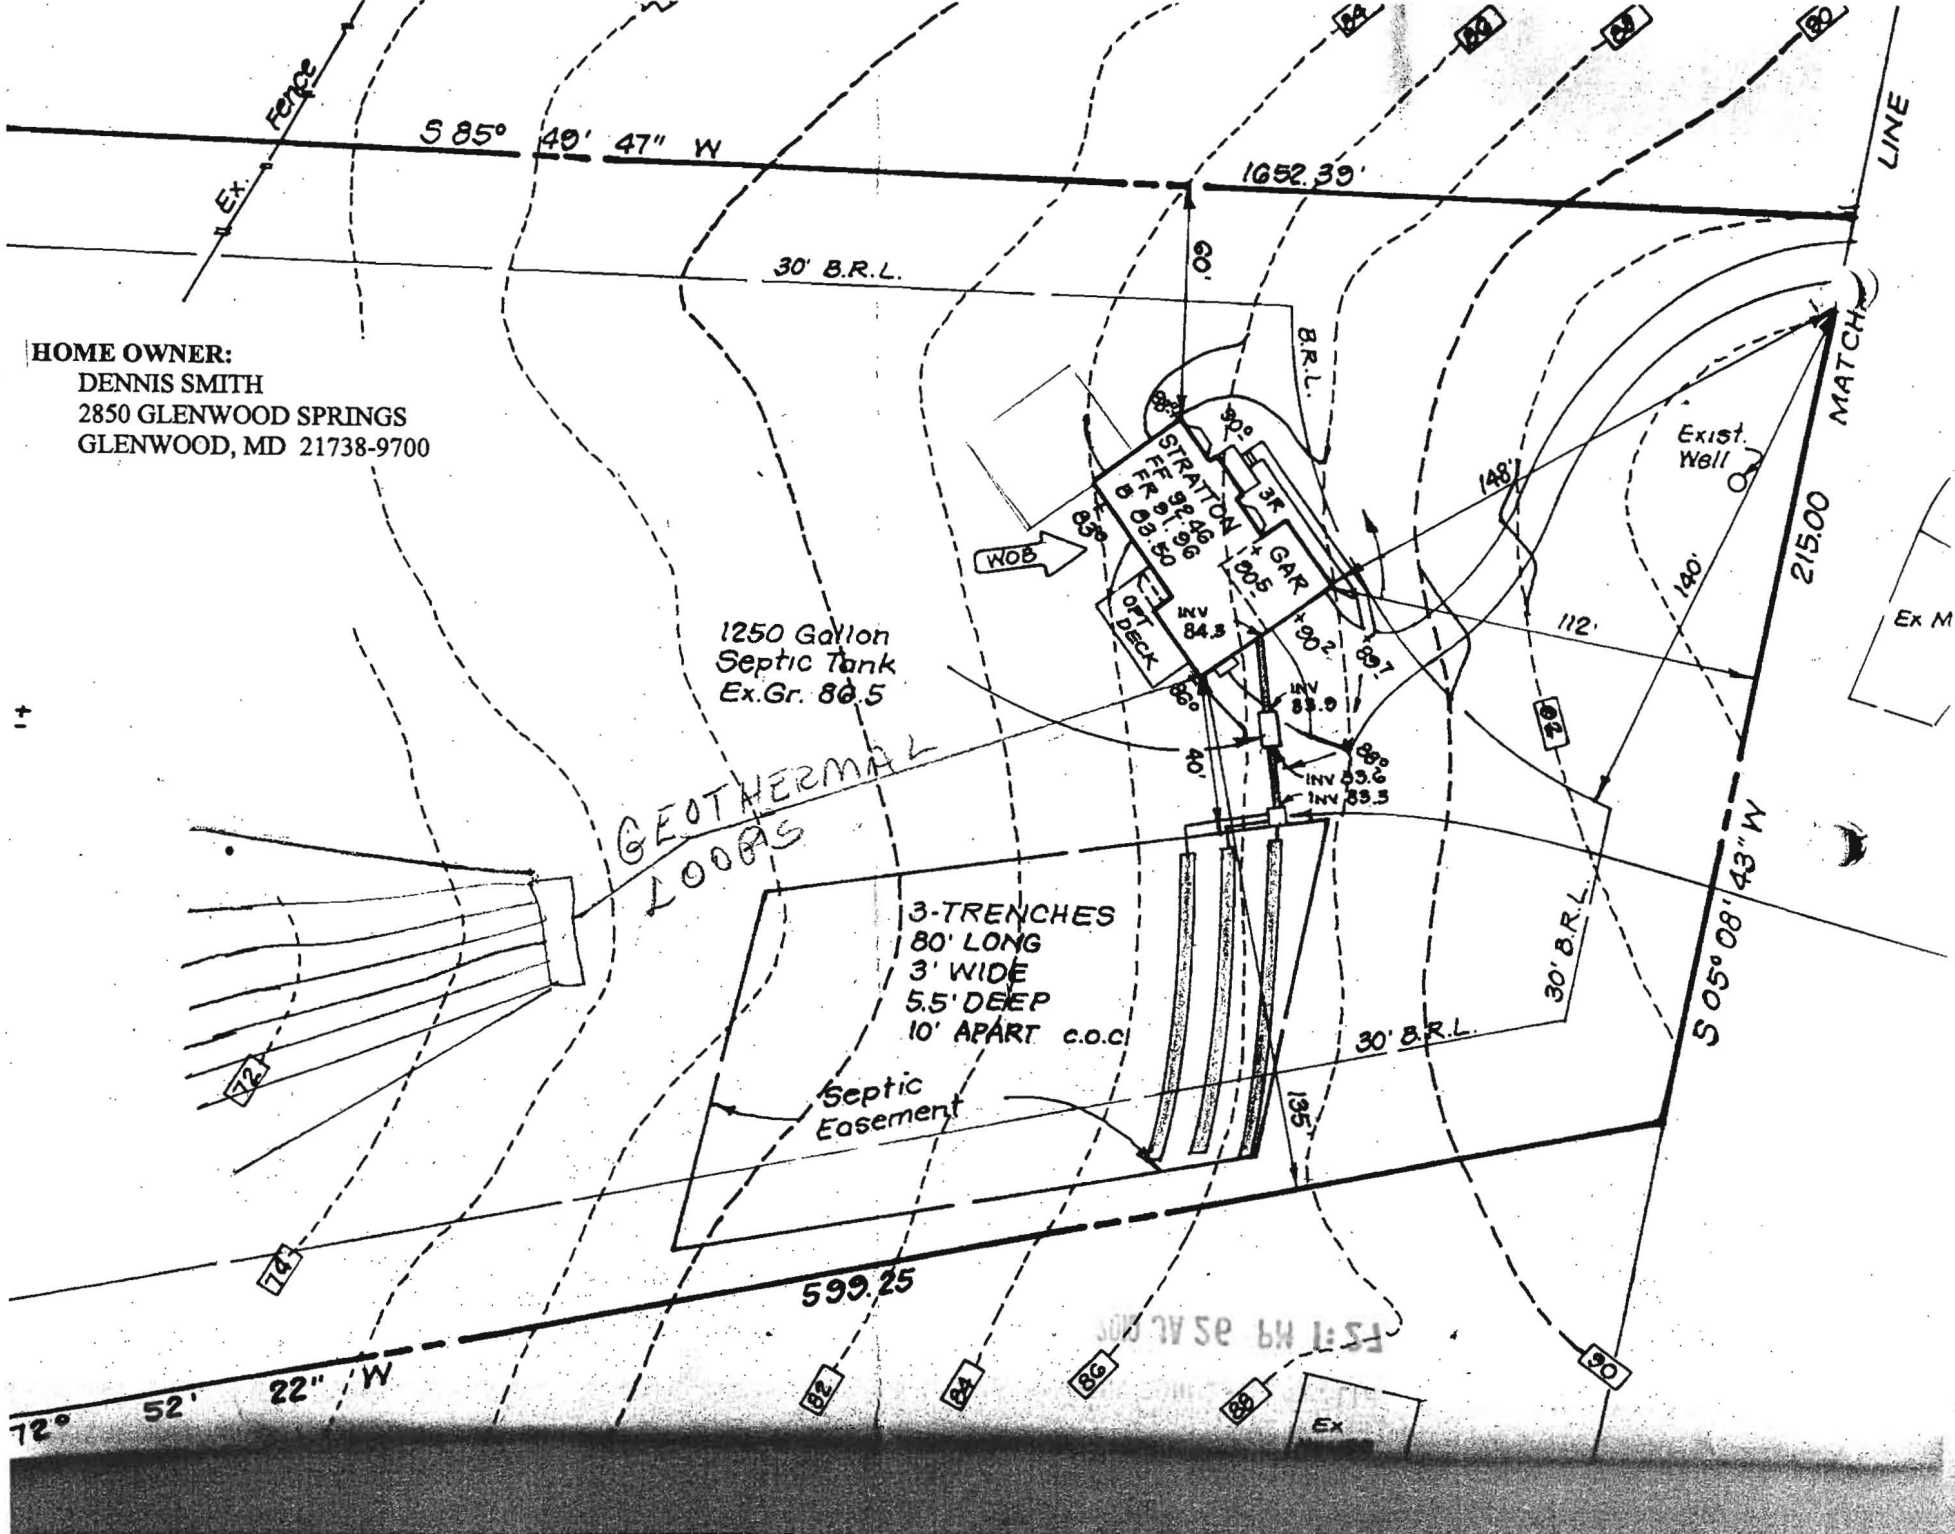

M 10000076

HOME OWNER:
DENNIS SMITH
2850 GLENWOOD SPRINGS
GLENWOOD, MD 21738-9700

410-313-2648
To: BRIAN
410-313-2640


2/12/2010
Permit
Approved
BB

1250 Gallon
Septic Tank
Ex.Gr. 80.5

GEO THERMAL
LOOPS

3-TRENCHES
80' LONG
3' WIDE
5.5' DEEP
10' APART c.o.c

Septic
Easement

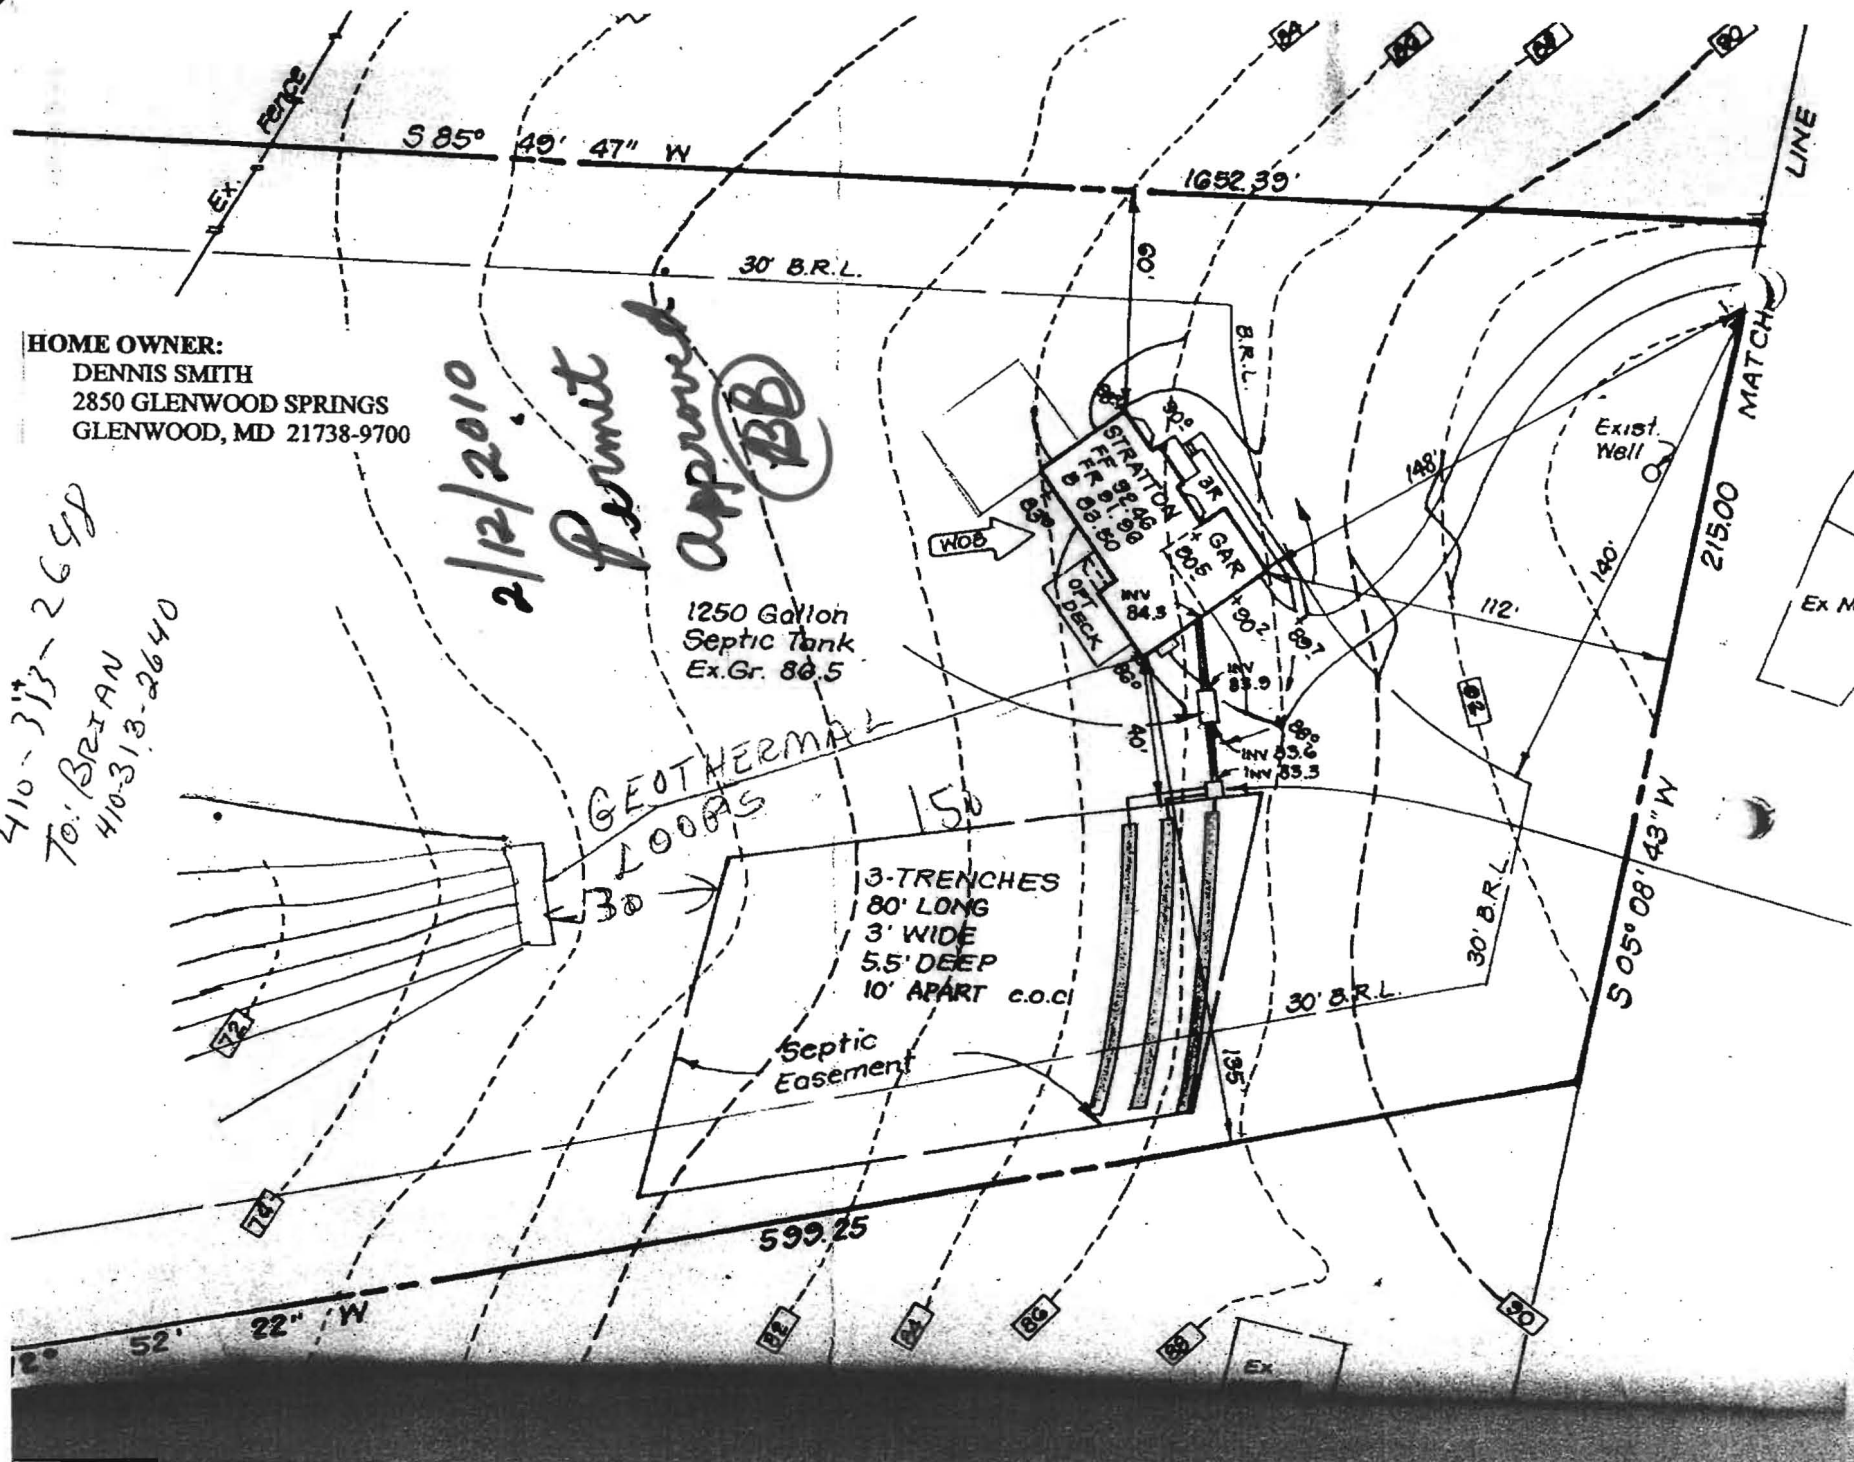



Fax

1701-A WHITEFORD ROAD
DARLINGTON, MD 21034
410-836-1706
FAX 410-457-0581
EMAIL ADDRESS
MIKE@GROUNDLOOP.COM

To: Howard County
Atten: Brian

From: Linda Politowicz

Fax: 410-313-2648

Pages: 2 (including cover sheet)

Phone: 410-313-2640

Date: February 4, 2010

Re:

CC:

Per our conversation, please find attached the revisions you requested.

If you have any questions, please contact me – 800-836-1706.