


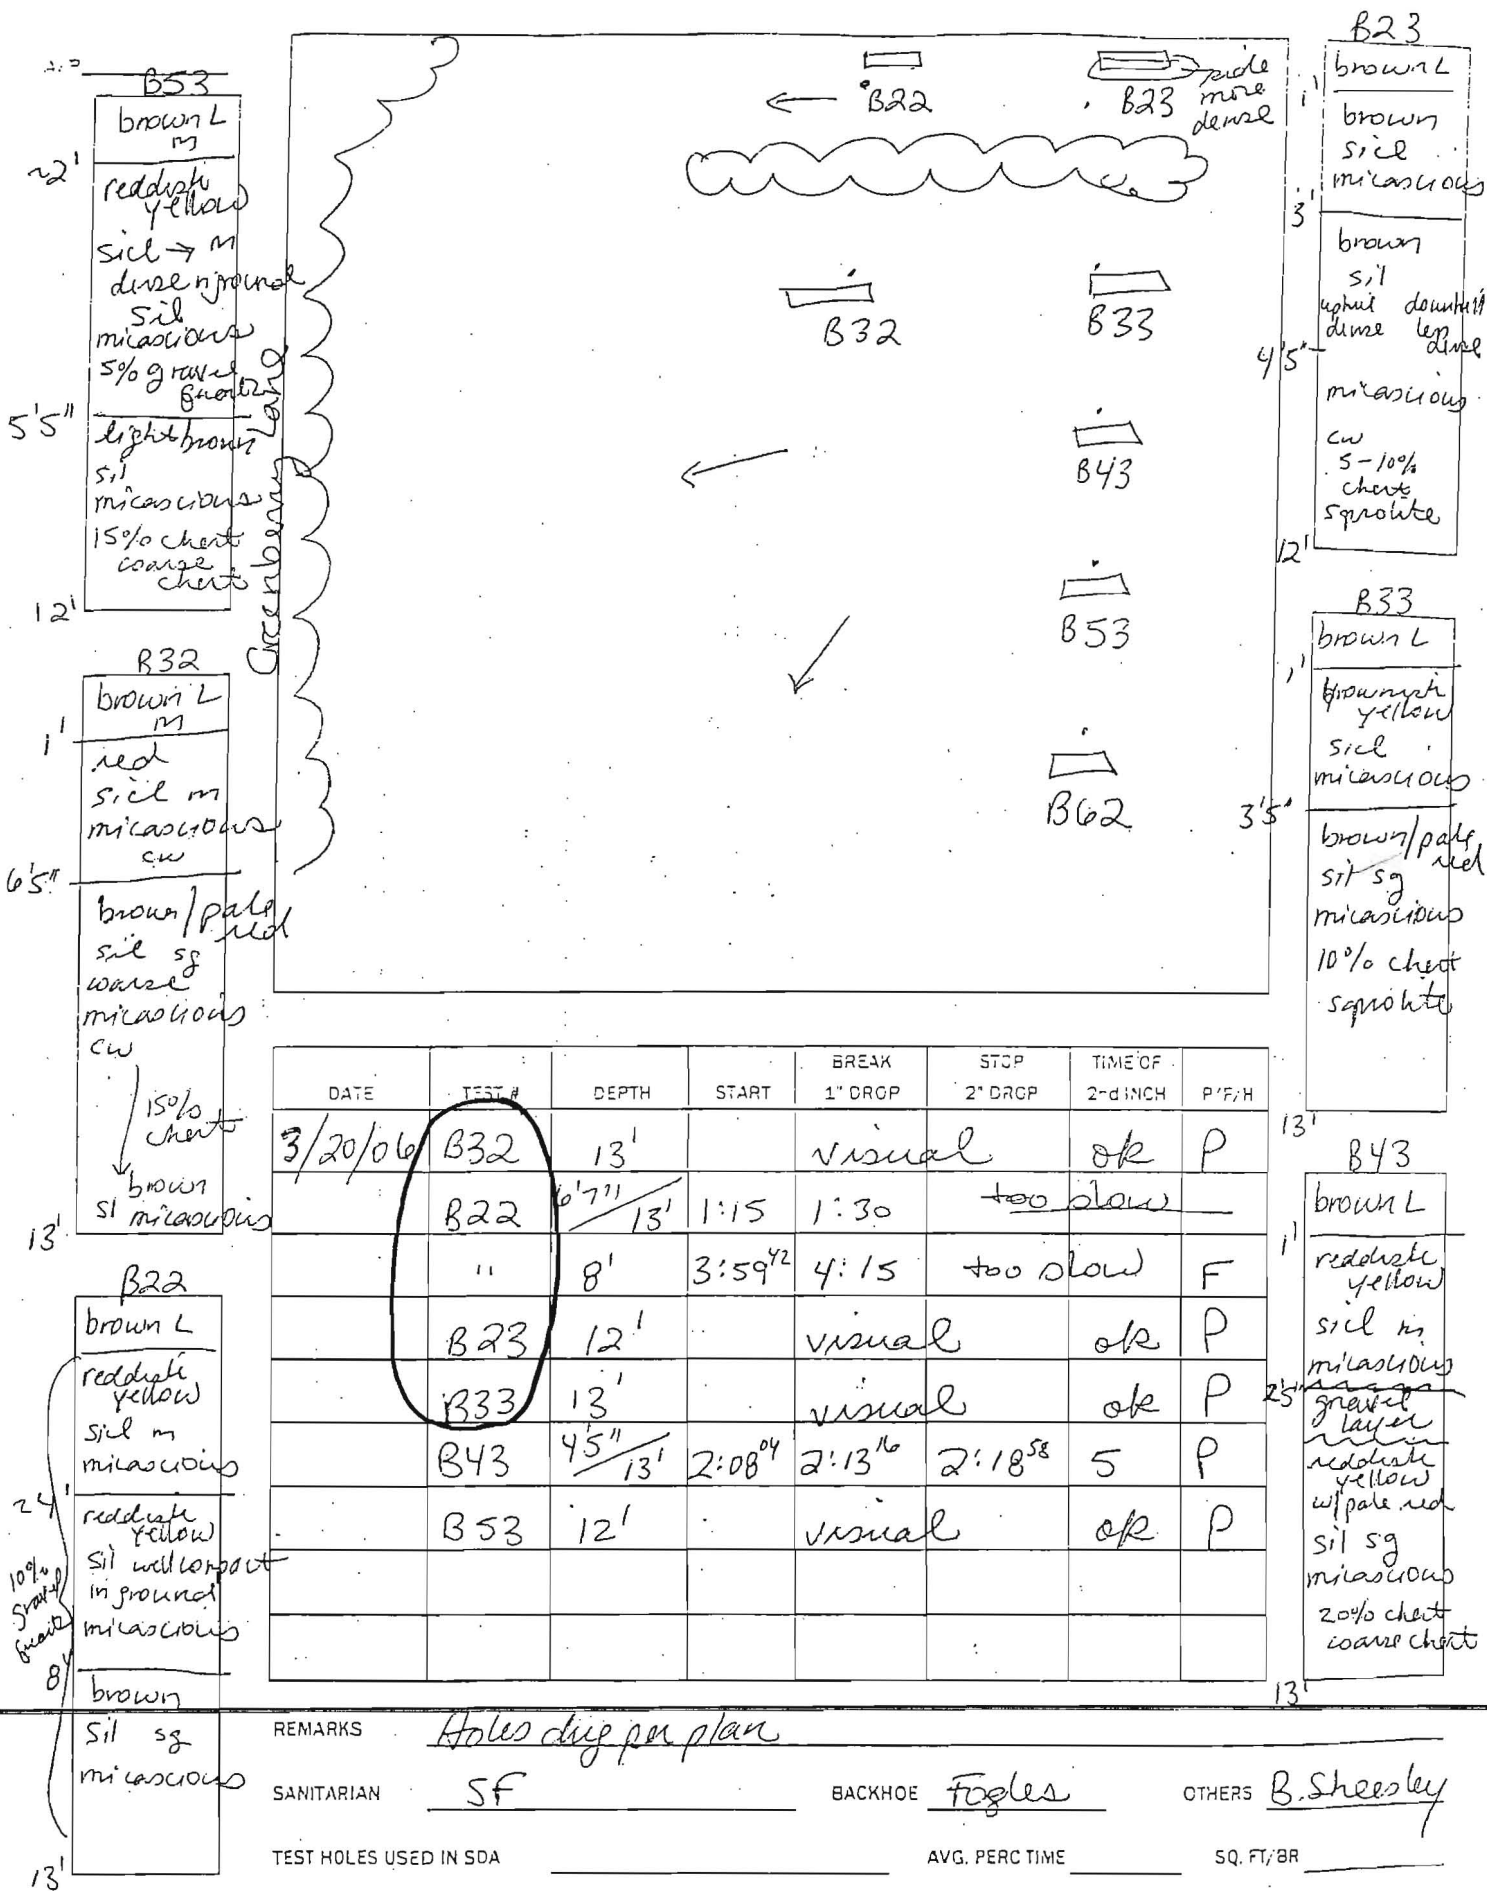

Green berry lot 10

10-A

dk. grey-brn
L. sm 0.6'

pale yel-brn cl
2 csbk to 2 usbk
2.2'


brn L
1 usbk
2.7'

brn L, sm
w/ yel-brn sl
interlayered
5'

red, blk tan
lfs many
mic
6.3'

red, blk
alt grey
lfs
micaceous
10'

red lfs
2 m pl
manu coats
sew flags
12'

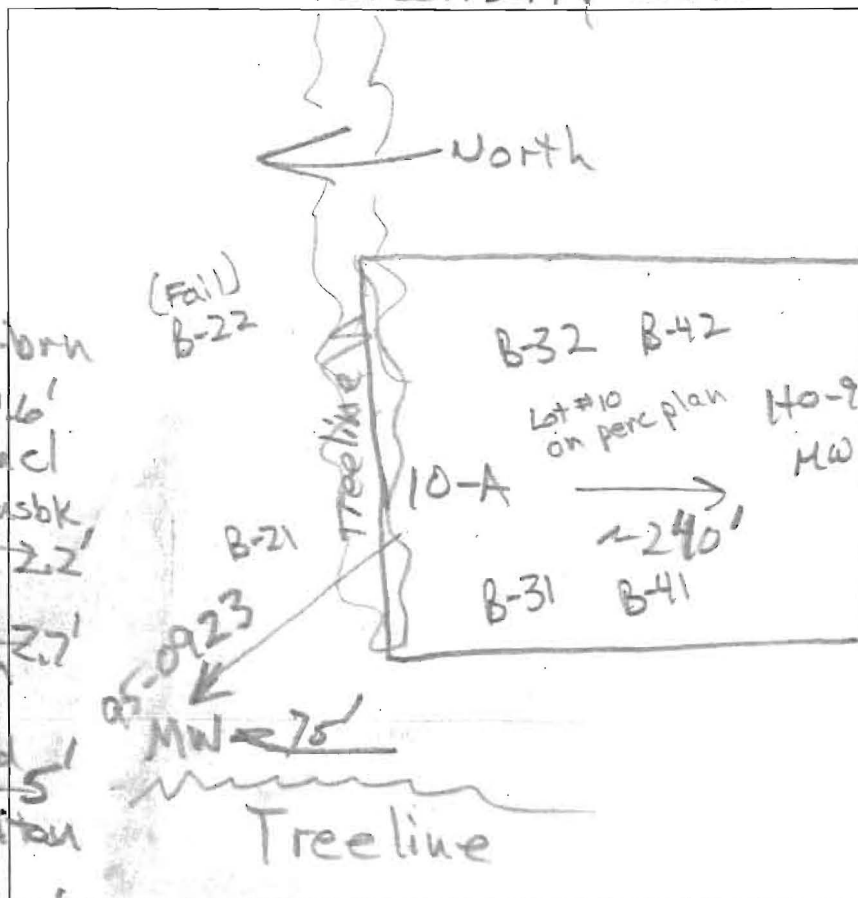

DATE	TEST #	DEPTH	START	BREAK 1" DROP	STOP 2" DROP	TIME OF 2ND INCH	P/F/H
11/2/12	10-A	12'	Visual	5' to 8'	1.29	OK	P

REMARKS _____

SANITARIAN

RB

BACKHOE

J3A

OTHERS

Jacob Hikmet

TEST HOLES USED IN SDA _____

AVG. PERC TIME _____

SQ. FT/BR _____


TRENCH WIDTH _____

INLET DEPTH _____

MAX. BOT DEPTH _____

EFFECTIVE SW _____

0.8' dk, grey brn L
 1.5' brn L, 2msbk
 2.7' brn & sl common mica
 red & yel ls
 many mica
 m2p (blk)
 4' alternating
 layers
 red ls
 & yellow ls
 micaceous
 02 & 3 (blk)
 12.5' few channers

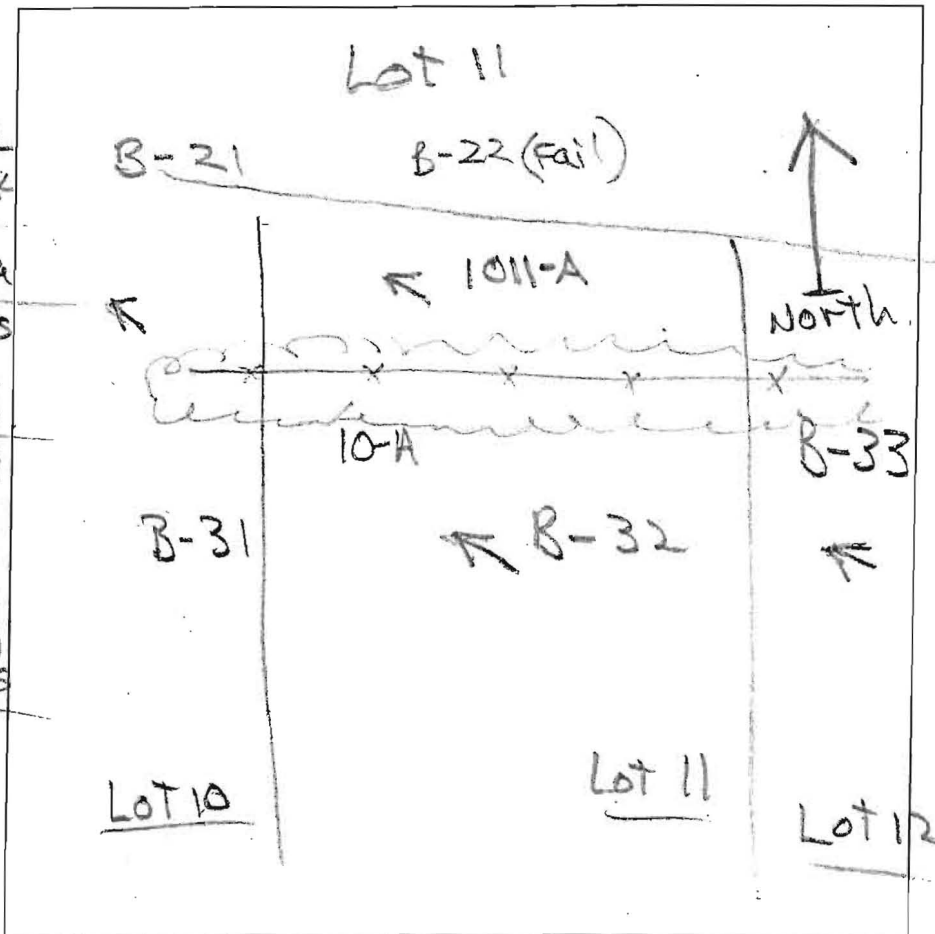

DATE	TEST #	DEPTH	START	BREAK 1" DROP	STOP 2" DROP	TIME OF 2ND INCH	P/F/H
8/12/13	1011-A	4' / 12.5'	12:25	12:27	12:31	4	P

REMARKS

SANITARIAN R. Bricker BACKHOE Nathan OTHERS Sacab Wikmat
Jeff Sloman
 TEST HOLES USED IN SDA _____ AVG. PERC TIME _____ SQ. FT/BR _____
 TRENCH WIDTH _____ INLET DEPTH _____ MAX. BOT DEPTH _____ EFFECTIVE S/W _____

MATCHLINE SHEET

