

Bureau of Environmental Health
 8930 Stanford Boulevard, Columbia, MD 21045
 Main: 410-313-2640 | Fax: 410-313-2648
 TDD 410-313-2323 | Toll Free 1-866-313-6300
www.hchealth.org
 Facebook: www.facebook.com/hocohealth

Maura J. Rossman, M.D., Health Officer

RECEIPT DATE: 9/15/16 **ONSITE SEWAGE DISPOSAL SYSTEM** P 557374-A

APPROVAL DATE: 2/12/16 ^{REC} **PERMIT:** **CONSTRUCTION** A _____

PROPERTY ADDRESS: 13609 Mitchells Way

SUBDIVISION: Cloverfield II LOT: 8 TAX ID: 03-353494

CONTRACTOR: WTC Contractors EMAIL: _____

CONTRACTOR ADDRESS: 3033 Salem Bottom Road, Westminster, MD 21157 PHONE: 443-458-7024

CONTRACTOR CERTIFIED FOR BAT INSTALLATION: MDE MANUFACTURER:

PROPERTY OWNER: Catonsville Homes EMAIL: _____

OWNER ADDRESS: 11175 Stratfield Court, Marriottsville, MD 21104 PHONE: _____

Norweco TNTLP-

BAT UNIT MODEL: 500/600 PUMP SIZE: _____ PUMP TANK CAPACITY: _____

OPERATION & MAINTENANCE AGREEMENT DATE SIGNED: 11/4/13 DATE RECORDED: 11/4/13

DISTRIBUTION SYSTEM: GRAVITY PRESSURE DOSED BEDROOMS: 5 APPLICATION RATE: _____

TRENCHES:	LINEAR FEET REQUIRED: <u>110</u> <i>OK</i>	INLET DEPTH: <u>3</u> <i>OK</i>
	TRENCH WIDTH: <u>3</u>	MAXIMUM BOTTOM DEPTH: <u>6</u> <i>OK</i>
	MINIMUM SPACE BETWEEN TRENCHES: <u>12</u> <i>ft</i>	EFFECTIVE AREA BEGINNING DEPTH: <u>3</u>

LOCATION: **PER APPROVED SITE PLAN. SEWAGE DISPOSAL AREA AND BAT UNIT LOCATION MUST BE STAKED BY LICENSED SURVEYOR PRIOR TO PRE-CONSTRUCTION INSPECTION.**

NOTES: Install per plan. Distribution box near the center of upper SDA boundary.

Kmw


ISSUED BY: Dana Bernard ISSUE DATE: 9/15/15 EXPIRATION DATE: 9/15/16

- NOTE: CONTRACTOR MUST SCHEDULE A PRE-CONSTRUCTION INSPECTION PRIOR TO BEGINNING ANY INSTALLATION
- NOTE: CONTRACTOR MUST SCHEDULE AN INSPECTION AND GAIN APPROVAL OF ALL COMPONENTS PRIOR TO COVERING
- NOTE: STONE MUST BE APPROVED BY HEALTH DEPARTMENT AND GRAVEL TICKET MUST BE AVAILABLE FOR REVIEW.
- NOTE: WATERTIGHT SEPTIC TANKS REQUIRED
- NOTE: ALL PARTS OF SEPTIC SYSTEM SHALL BE AT LEAST 100 FEET DOWNGRADIENT FROM ANY WATER WELL
- NOTE: MANHOLE RISERS REQUIRED ON ALL SEPTIC TANKS AND PUMP CHAMBERS
- NOTE: AN ELECTRICAL PERMIT IS REQUIRED FOR INSTALLATION OF ANY ELECTRICAL COMPONENTS OF THE SYSTEM
- ELECTRICAL PERMIT ISSUED E 15004358
- NOTE: AN INDIVIDUAL CERTIFIED BY MDE AND THE MANUFACTURER FOR BAT INSTALLATION MUST BE PRESENT AT ALL TIMES DURING BAT INSTALLATION.
- NOTE: MDE RECOMMENDS SEPTIC TANKS, BAT, AND OTHER PRETREATMENT UNITS BE PUMPED AT A FREQUENCY ADEQUATE TO ENSURE THAT SOLIDS ARE NOT DISCHARGED TO THE DISPOSAL AREA

NEITHER THE HOWARD COUNTY COUNCIL NOR THE HEALTH DEPARTMENT IS RESPONSIBLE FOR THE SUCCESSFUL OPERATION OF ANY SYSTEM.

PERMITTEE RESPONSIBLE FOR OBTAINING FINAL APPROVAL ON THIS PERMIT.

CALL 410-313-1771 TO SCHEDULE INSPECTIONS.

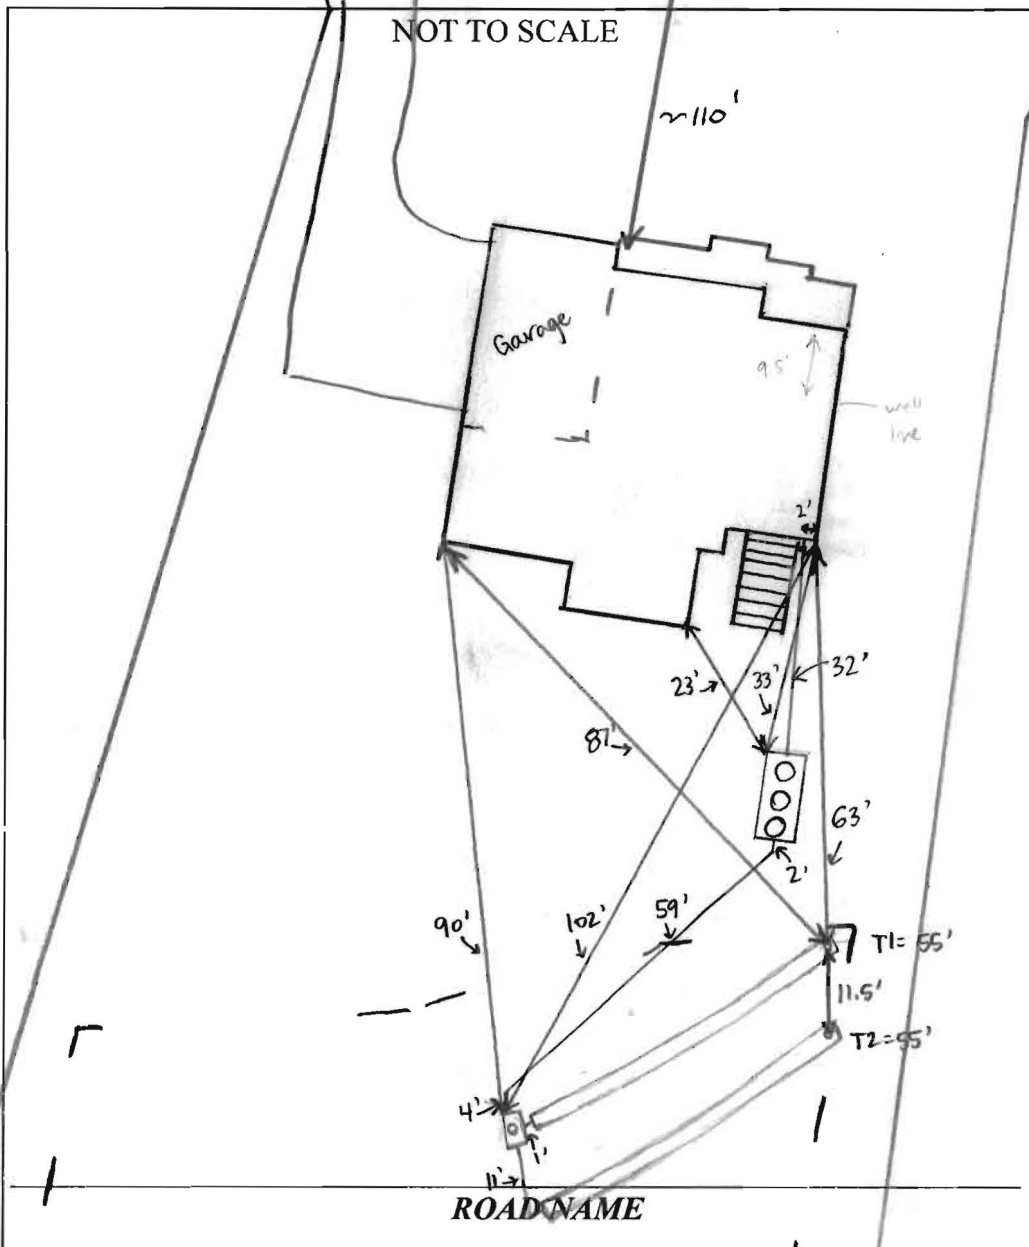

TRENCH/DRAINFIELD DATA		
WIDTH	INLET	BOTTOM
3'	3'	6'
NUMBER OF TRENCHES		2
TOTAL LENGTH		110'
ABSORPTION AREA		330' + SIDEWALL
DISTRIBUTION BOX LEVEL		YES
DISTRIBUTION BOX BAFFLE		YES
DISTRIBUTION BOX PORT		YES

SEPTIC TANK DATA	
SEPTIC TANK I LEVEL	YES
MANUFACTURER	BACKLIVER/NORWECO
CAPACITY	1300 GAL
SEAM LOC	TOP
TANK LID DEPTH	1'
BAFFLES	NO
BAFFLE FILTER	NO
MANHOLE LOC	FRONT, MID, REAR
6" PORT LOC	NONE
WATERTIGHT TEST	NO
SLOTTED	NO
DATE ON LID	8/21/15


PUMP/SEPTIC TANK LEVEL	
MANUFACTURER	
CAPACITY	GAL
SEAM LOC	
TANK LID DEPTH	
BAFFLES	
BAFFLE FILTER	
MANHOLE LOC	
6" PORT LOC	
WATERTIGHT TEST	
SLOTTED	
DATE ON LID	

PRE-CONSTRUCTION:

9/29/15
 Install BAT unit per stakeout. Install 2 x 55' trenches on contour running towards lot. Keep trench ends square w/ SRA. Trenches to be 3' wide. (SC)

INSTALLATION: 10/7/15 System completely installed. House connection made. Levelled D-box with speed levelers. T1 left open at ends. T2 left open. 3' wide, 2.5' to stone. Tank bedded with #2 stone. line from house bedded from house to 10' out. Need BAT startup certification. (SC) 2/5/16 BAT startup received. (SC) 2/5/16 Met WTC on site for Norweco startup Alarm sounds, aerator runs. Need to fix grading around risers - currently water could pool around risers. Rick Scranton will fix at final grading. (SC) 2/12/16 Grading adjusted around tank risers. (SC)

FINAL INSPECTOR Sarah Collins DATE OF APPROVAL 2/12/16

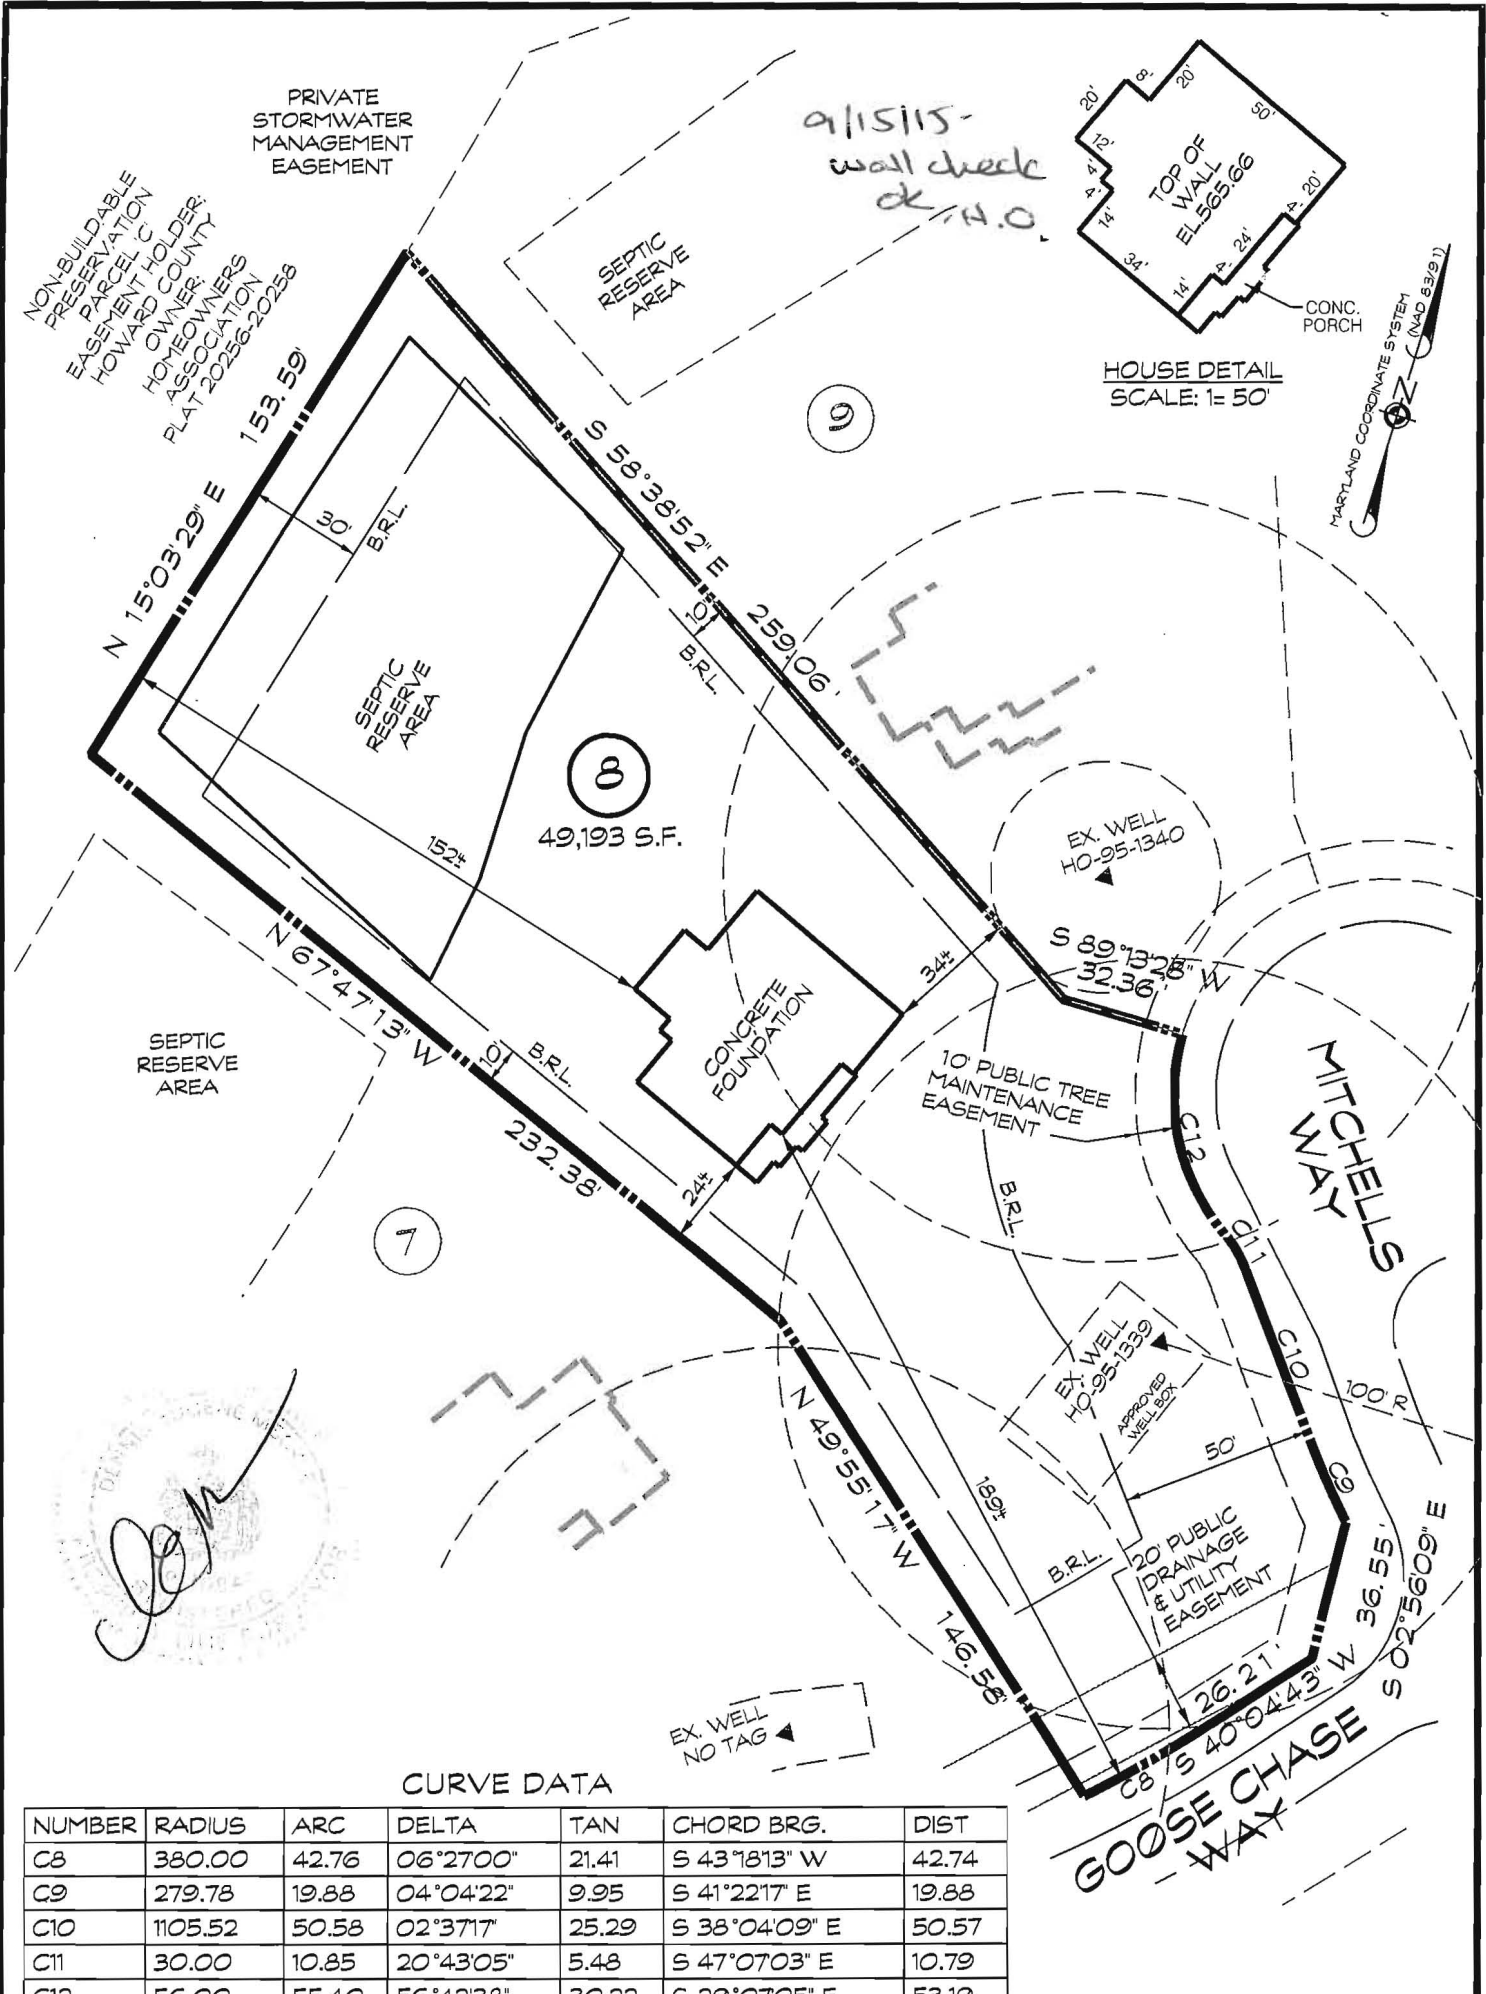

CURVE DATA

NUMBER	RADIUS	ARC	DELTA	TAN	CHORD BRG.	DIST
C8	380.00	42.76	06°27'00"	21.41	S 43°18'13" W	42.74
C9	279.78	19.88	04°04'22"	9.95	S 41°22'17" E	19.88
C10	1105.52	50.58	02°37'17"	25.29	S 38°04'09" E	50.57
C11	30.00	10.85	20°43'05"	5.48	S 47°07'03" E	10.79
C12	56.00	55.40	56°42'38"	30.22	S 29°07'05" E	53.19

I hereby certify that I have surveyed the property shown hereon for the sole purpose of locating the improvements. This plan is a benefit to the customer only in so far as it is required by a lender or a title insurance company or its agent in connection with contemplated transfer, financing or refinancing. It is not to be relied upon for the establishment of boundary, easement or right-of-way lines for any reason, such as the location of fences, garages, buildings, or other existing or future improvements. Offsets of buildings to property lines are to the nearest foot (1') unless otherwise noted.

FOUNDATION CERTIFICATION
 #13609 MITCHELLS WAY
 LOT 8
CLOVERFIELD
 SECTION II
 3RD ELECTION DISTRICT • HOWARD COUNTY, MD.
 TAX MAP: 15 BLOCK: 7 PARCEL: 119
 RECORDED PLAT NO. 22710

By: *Dennis E. Meckley* Date: 9/2/15
 Dennis E. Meckley Property Line Surveyor No. 10844
 License expires March 29, 2016

A licensed Maryland Surveyor either personally prepared this Location Drawing, or was in responsible charge over its preparation and the surveying work reflected in it, in compliance with the Maryland Minimum Standards of Practice for Land Surveyors. (COMAR 09-13-06.06 AND .12)

439 East Main Street Westminster, MD 21157-5539
 (410) 848-1790 FAX (410) 848-1791

DRAWN BY:	KMB
DESIGN BY:	
REVIEW BY:	DEM
DATE:	08-27-15
SCALE:	1" = 50'
JOB NO:	2013039
SHEET:	1 OF 1



Bureau of Environmental Health
7178 Columbia Gateway Drive, Columbia, MD 21046-2147
Main: 410-313-2640 | Fax: 410-313-2648
TDD 410-313-2323 | Toll Free 1-866-313-6300
www.hchealth.org
Facebook: www.facebook.com/hocohealth
Twitter: HowardCoHealthDep

Maura J. Rossman, M.D., Health Officer

**OPERATION AND MAINTENANCE AGREEMENT
FOR AN ON-SITE SEWAGE DISPOSAL SYSTEM
HAVING AN ADVANCED PRE-TREATMENT SYSTEM**

THIS AGREEMENT is made this 4 day of October 2013, among Spring Mill LLC, hereinafter collectively referred to as "Owner", and the Howard County Health Department hereinafter referred to as the "County".

WHEREAS, Owner is the owner or contract owner of a parcel of land located at 13609 Mitchells Way, W. Friendship, MD 21794 (Lot 8), in the 03 Election District of Howard County, Maryland, and the deed to same is recorded or shall be recorded among the Land Records of Howard County, Maryland in Liber 11285 Folio 00664.

23
40
H

WHEREAS, The Lot is suitable for the installation of a conventional on-site sewage disposal system with an advanced pre-treatment system, utilizing best available technology to perform nitrogen reduction, in accordance with the Code of Maryland Regulations 26.04.02.07, effective January 1, 2013.

NOW, THEREFORE, the parties hereto agree as follows:

- A. Owner hereby grants to the County the right to enter upon the Lot at any reasonable time for access to the system to make periodic inspections and the Owner agrees to provide any information and data in Owner's possession reasonably requested and needed by the County to develop accurate and thorough test results.
- B. Owner acknowledges and agrees that neither the County nor any of its agents or employees, either officially or individually, underwrites the operation of any system approved by them.
- C. The Owner will devote reasonable care and effort to the operation and maintenance of the system in perpetuity or until a public sewer connection is made so that a system malfunction is not the result of poor maintenance, faulty operation, or neglect.
- D. The Owner agrees to enter into a contract reasonably acceptable to the Owner and the County with a private entity to operate and maintain on a regularly scheduled basis an approved advanced pre-treatment system. The owner shall supply a copy of the contract to the County when it is renewed or altered.
- E. This agreement shall run with the land and upon Owner's taking title to the Lot shall bind the Owner, their heirs, successors, and assigns to the provisions of the agreement as

long as the property is in existence and after installation of the system. Owner further agrees that they shall inform in writing any subsequent purchaser or lessee of the Lot that the system shall require maintenance or other attention. Upon taking title to the Lot, the Owner agrees to cause this agreement to be recorded in the Land Records of Howard County and assure that it becomes part of the Deed for the subject property in order that prospective buyers may be aware of the special conditions affecting this property.

F. This agreement shall not be construed to limit any authority of the County to protect the public health, safety or comfort or to issue any other orders to take any other action which is now or may hereafter be within its authority.

G. This agreement may be voided at any time at the discretion of the County.

H. This agreement contains the entire agreement and understanding between the County and the Owner. There are no additional terms other than as contained in this agreement. This agreement may not be modified, except in writing signed by each of the parties or by their authorized representatives.

I. The laws of the State of Maryland govern the provisions of all transactions pursuant to this agreement.

J. Owner acknowledges and agrees that interior renovations to increase the number of bedrooms or an increase in living space shall not be permitted without approval from the County.

IN WITNESS WHEREOF, the parties have signed and sealed this agreement on the date indicated above.

Spring Mill LLC
James R. Maxley III 11/4/13
Owner James R. Maxley, III Date

Owner Date

Beet Rifon 11/4/2013
Howard County Health Department

LR - Agreement Recording Fee 20.00
Grantor/Grantee Name: HCHD
Reference/Control #: 175
LR - Agreement Surcharge 40.00
LR - Additional Recording Fee 0.00
- linked
SubTotal: 60.00
=====
Total: 900.00
#2168213-46 02-53 CC13-CH
11/04/2013 02-53 CC13-CH
#2168213 CC0503 - Howard Co
Columbial/CC05.03.03 - Register
03 495

Back River Pre-Cast, LLC

PO BOX 329
Glyndon, MD 21071
Phone # 410-833-3394
Fax # 410-833-4116

Letter of Certification

This is to certify that the Norweco Singulair TNT 600 GPD Septic Tank installed at 13609 Mitchells Way, West Friendship, MD 21794 on October 6, 2015 was installed according to the manufacture's specifications.

Installer: Walter Coon

Property Owner: Spring Mill, LLC

Permit #



MATTHEW GECKLE


Vice-President

LOD DENOTES LIMIT OF DISTURBANCE
TOTAL AREA = 26,740 S.F.

LEGEND:
 X 562.5 SPOT ELEVATION
 2.5% FLOW PATH & SLOPE
 ▲ EX. WELL
 ● PERC. TEST LOCATION

CURVE DATA



NUMBER	RADIUS	ARC	DELTA	TAN	CHORD BRG.	DIST
C8	380.00	42.76	06°26'52"	21.40	N 43°18'07" E	42.74
C9	279.79	19.88	04°10'41"	9.95	N 41°22'17" W	19.88
C10	1105.52	50.57	02°37'16"	25.29	N 38°04'09" W	50.57
C11	30.00	10.85	20°43'12"	5.48	N 47°07'03" W	10.79
C12	56.00	55.43	56°42'38"	30.22	N 29°07'05" W	53.19

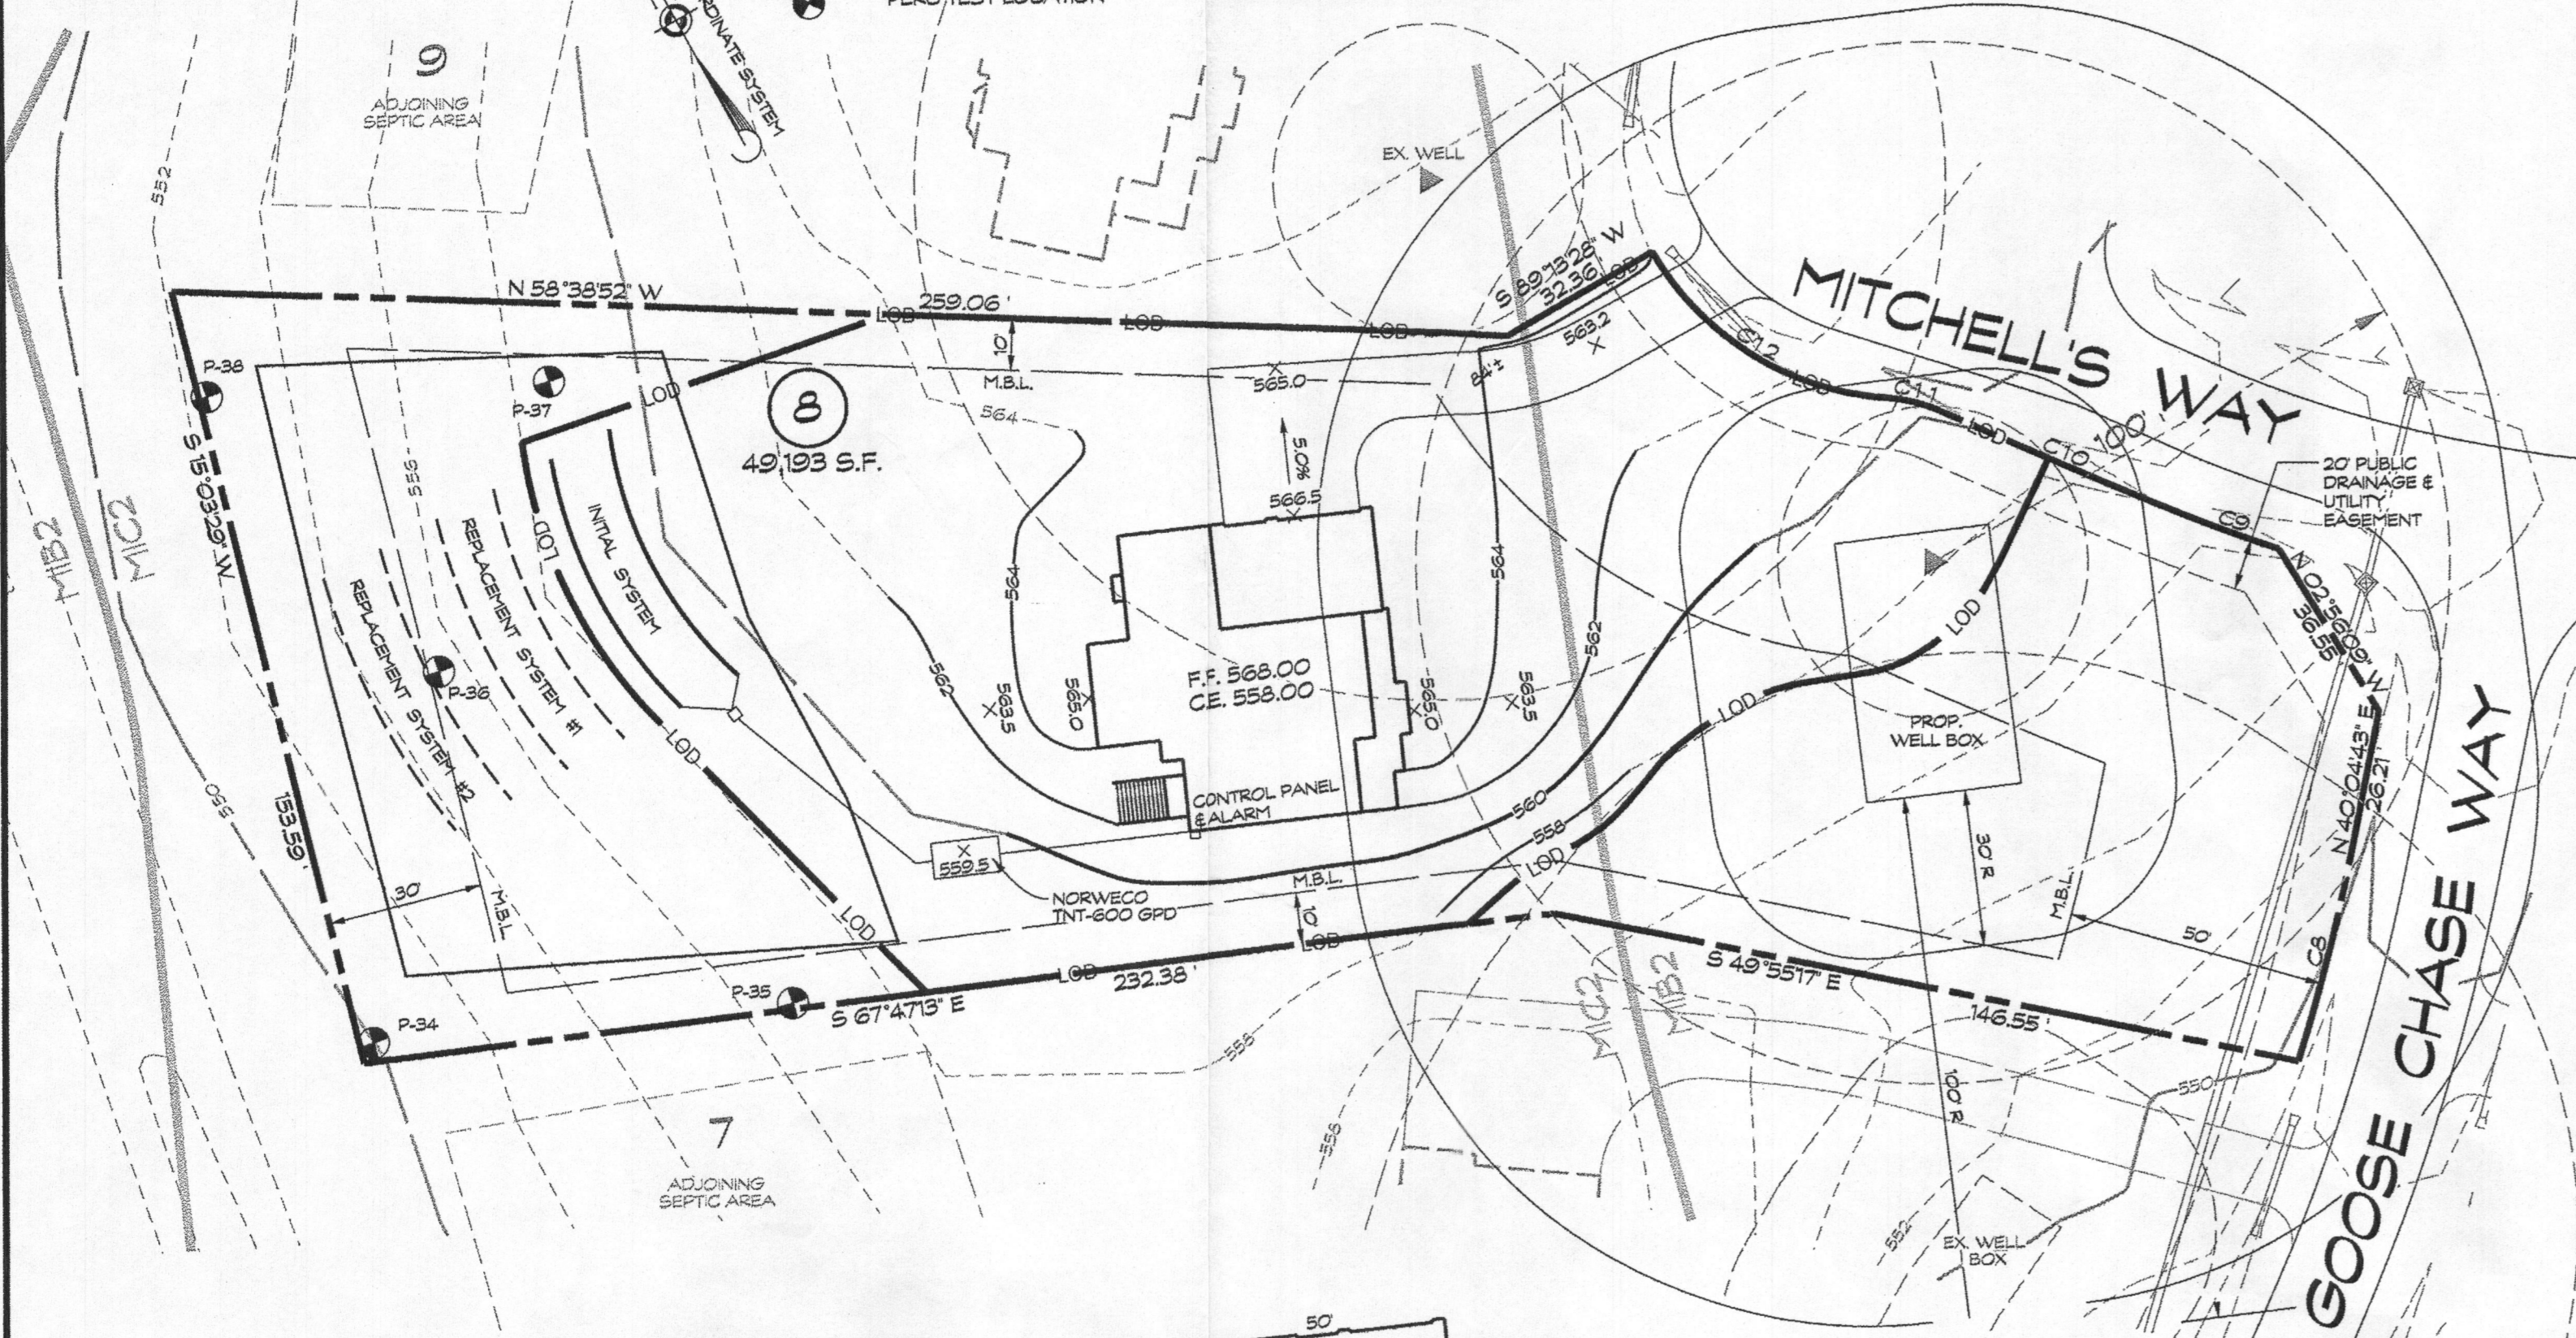

PLAN
SCALE: 1" = 30'

TRENCH CHART

TRENCH	EX. GROUND	INV. ELEV.	BOTTOM OF TRENCH
1	559.4	556.4	553.4
2	556.4	555.4	552.4

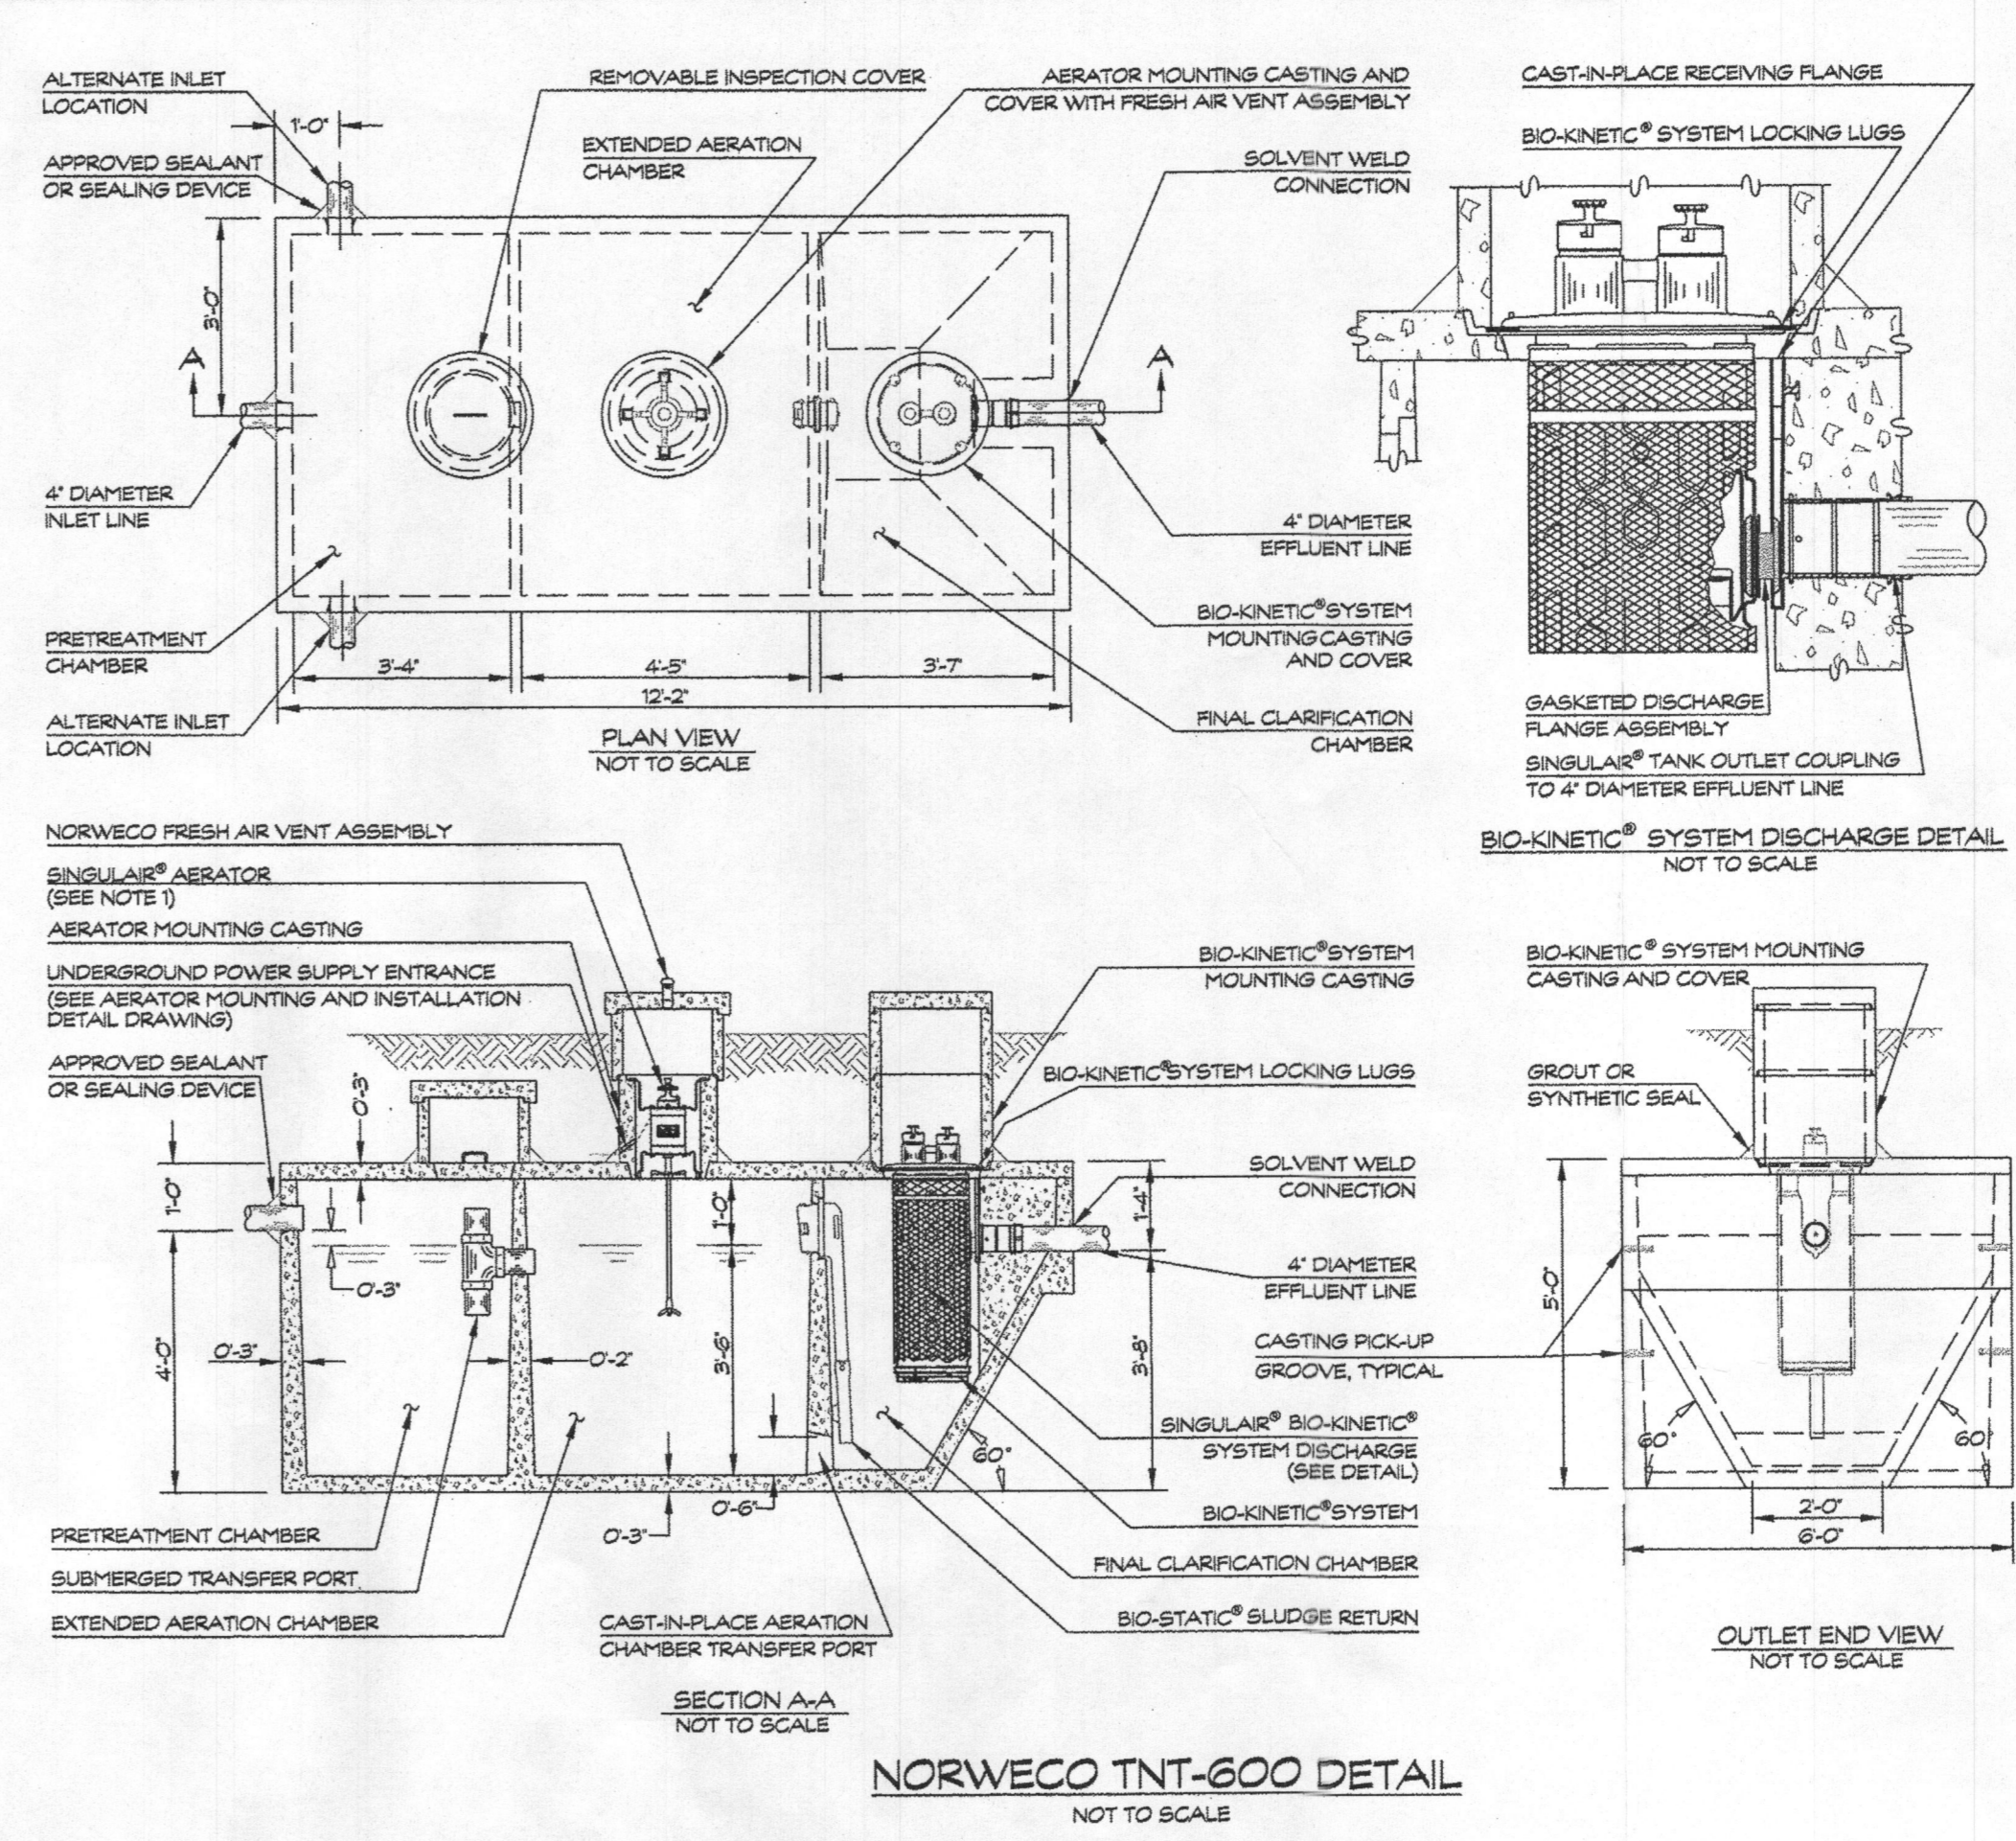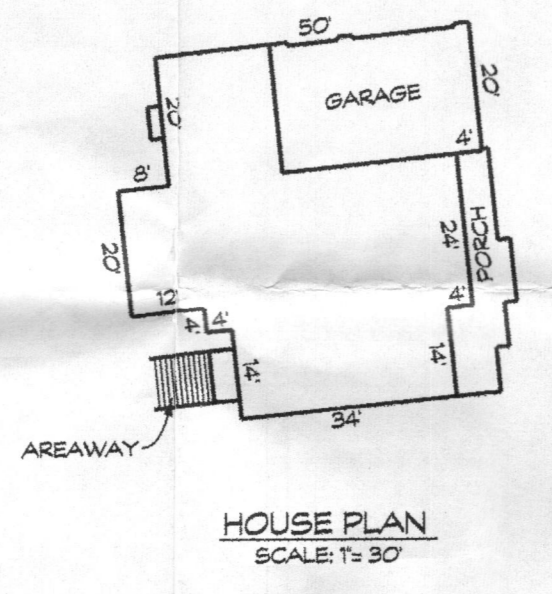

NOTE:
SEPTIC DISPOSAL AREA AND PERCOLATION TEST LOCATIONS ARE FROM REVISED PERCOLATION CERTIFICATION PLAN DATED OCTOBER 2007 AND SIGNED BY HOWARD COUNTY HEALTH DEPARTMENT OCTOBER 5, 2007.

GENERAL NOTES

1. THE STORMWATER MANAGEMENT FOR THIS LOT IS PROVIDED OFF-SITE IN THE TWO MICROPOOL EXTENDED DETENTION FACILITIES AND GRASSED SWALES PER THE RECORDED PLAT NO. 20256.
2. THERE ARE NO STREAMS, PONDS, FLOODPLAINS, OR WETLANDS ON THIS LOT.
3. THERE ARE NO 20% OR GREATER SLOPES ON THIS LOT.
4. EXISTING WELL LOCATION IS FIELD LOCATED.

SEPTIC SYSTEM TRENCH DESIGN:

PROPOSED NUMBER OF BEDROOMS = 4
 AVERAGE PERCOLATION TEST TIME = 3
 APPLICATION RATE = 1.2
 DESIGN FLOW: 150 GALS x 4 BEDROOM = 600 GAL/DAY
 600 GAL/DAY / 1.2 GAL / DAY/SQ. FT. = 500 SQ. FT.
 500 SQ. FT. / 2 FT. = 250 L.F. OF TRENCH
 250 L.F. x 0.44 = 103.5 L.F. OF TRENCH = 110 L.F. USE 2 - 55 L.F. OF TRENCH FOR INITIAL SYSTEM
 USE 2 - 55 L.F. OF TRENCH FOR EACH REPLACEMENT SYSTEM

SEPTIC TANK NOTES

1. SINGULAR® AERATOR, AS TESTED AND ACCEPTED BY NSF, OPERATING 60 MINUTES ON / 60 MINUTES OFF.
2. FALL THROUGH SINGULAR® PLANT FROM INLET INVERT TO OUTLET INVERT IS FOUR INCHES. INLET INVERT IS TWELVE INCHES BELOW TANK TOP.
3. ON DEEPER INSTALLATIONS, PRECAST RISERS MUST BE USED TO EXTEND AERATOR MOUNTING CASTING AND BIO-KINETIC® SYSTEM MOUNTING CASTING TO GRADE.
4. TANK REINFORCED PER ACI STD. 318-05.
5. REMOVABLE COVERS ON RISERS WEIGH IN EXCESS OF SEVENTY-FIVE POUNDS EACH TO PREVENT UNAUTHORIZED ACCESS.
6. CONTACT THE LOCAL, LICENSED SINGULAR® DISTRIBUTOR FOR ELECTRICAL REQUIREMENTS.


BAT SITE PLAN NOTES

1. ANY CHANGE TO THE LOCATIONS OR DEPTHS TO ANY COMPONENTS MUST BE APPROVED BY THE ENGINEER AND THE HOWARD COUNTY HEALTH DEPARTMENT PRIOR TO INSTALLATION. A REVISED SITE PLAN MAY BE REQUIRED.
2. THE MAXIMUM DEPTH OF THE BAT PER THE MANUFACTURER'S SPECIFICATION IS 3 FEET.
3. THE BAT SYSTEM SHALL BE MAINTAINED AND OPERATED FOR THE LIFE OF THE SYSTEM.
4. THE BAT SHALL BE OPERATED BY AND MAINTAINED BY A CERTIFIED SERVICE PROVIDER.
5. WITHIN ONE MONTH OF INSTALLATION, A PERSON INSTALLING THE BAT SYSTEM SHALL REPORT TO THE MARYLAND DEPARTMENT OF THE ENVIRONMENT (MDE) IN A MANNER ACCEPTABLE TO MDE, THE ADDRESS AND DATE OF COMPLETION OF THE BAT INSTALLATION AND THE TYPE OF BAT INSTALLED.
6. ELECTRICAL WORK FOR THE BAT INSTALLATION MUST BE PERFORMED BY A LICENSED ELECTRICIAN.
7. AN AGREEMENT AND EASEMENT MUST BE COMPLETED AND SIGNED BY ALL APPLICABLE PARTIES, AND RECORDED IN LAND RECORDS OR HOWARD COUNTY.
8. THE HEALTH DEPARTMENT REQUIRES DOCUMENTATION FOR THE START-UP CERTIFICATION FROM THE MANUFACTURER PRIOR TO FINAL APPROVAL OF THE INSTALLATION.
9. THE BLOWER MAY NOT BE LOCATED MORE THAN 100 FEET FROM THE TANK BASED ON MANUFACTURER'S SPECIFICATIONS.
10. IF A BUILDING PERMIT IS SUBMITTED ANY TIME IN THE FUTURE, A SEPTIC SYSTEM UPGRADE WILL BE REQUIRED TO FINISH THE AREA CURRENTLY IDENTIFIED AS THE BASEMENT. AT THAT TIME A SEPTIC SYSTEM UPGRADE WILL BE REQUIRED AS FINISHING THE BASEMENT COULD POSSIBLY CREATE A FIFTH BEDROOM PER HOWARD COUNTY CODE 3.80 1(B).

OWNER/DEVELOPER
 SPRING MILL LLC
 P.O. BOX 417
 BLOCCOTT CITY, MD 21041

Approved Septic System Plan
 Howard County Health Department
 Signature: _____ Date: _____

Approved Septic System Plan
 Howard County Health Department
 Dana Beard 7-17-15
 Signature: _____ Date: _____

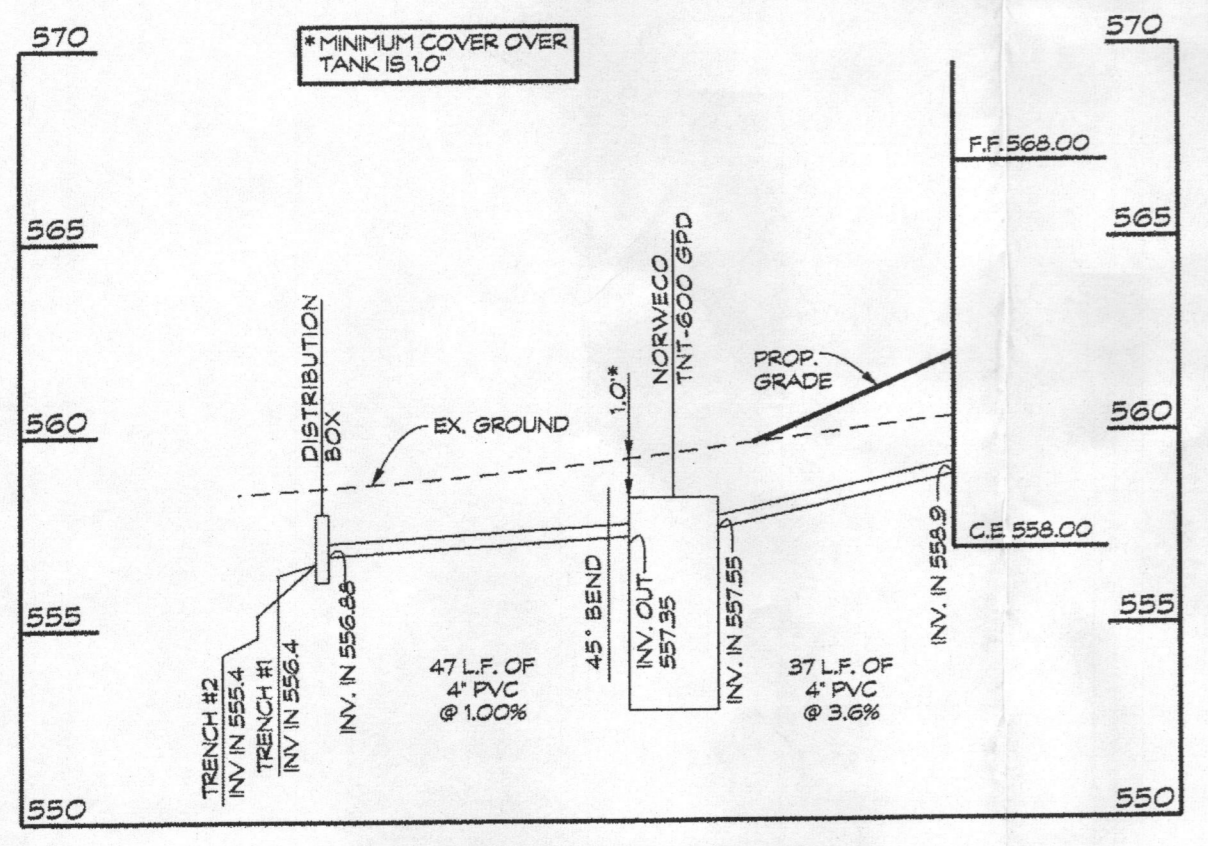

SITE PLAN AND PLOT PLAN FOR BAT INSTALLATION
 SPRING MILL LLC
 13609 MITCHELLS WAY
 TAX ACCOUNT NO.: 353451
 LOT 8
CLOVERFIELD- SECTION II
 3RD ELECTION DISTRICT * HOWARD COUNTY, MD.
 TAX MAP: 15 BLOCK: 7 PARCEL: 119

Engineers • Surveyors
CLSI
 Land Planning & Environmental Consultants
 www.clsi-civileng.com
 439 East Main Street Westminster, MD 21157-5539
 (410) 848-1790 FAX (410) 848-1791


Date	Revisions	Drawn By: BM
6/23/15	REVISED HOUSE LOCATION	Designed By: LDA
7/17/15	REVISED TO ADD NOTE BUILDING PERMIT NOTE PER HEALTH DEPT.	Reviewed By: LDA
		Date: 6/12/15
		Scale: 1" = 30'
		Job No.: 2013039
		Sheet: 1 OF 1

LOD DENOTES LIMIT OF DISTURBANCE
TOTAL AREA = 26,740 S.F.

- LEGEND:**
- X 562.5 SPOT ELEVATION
 - 2.5% FLOW PATH & SLOPE
 - ▲ EX. WELL
 - PERC. TEST LOCATION

CURVE DATA


NUMBER	RADIUS	ARC	DELTA	TAN	CHORD BRG.	DIST
C8	380.00	42.76	06°26'52"	21.40	N 43°18'07" E	42.74
C9	279.79	19.88	04°04'19"	9.95	N 41°22'17" W	19.88
C10	1105.52	50.57	02°37'16"	25.29	N 38°04'09" W	50.57
C11	30.00	10.85	20°43'12"	5.48	N 47°07'03" W	10.79
C12	56.00	55.43	56°42'38"	30.22	N 29°07'05" W	53.19

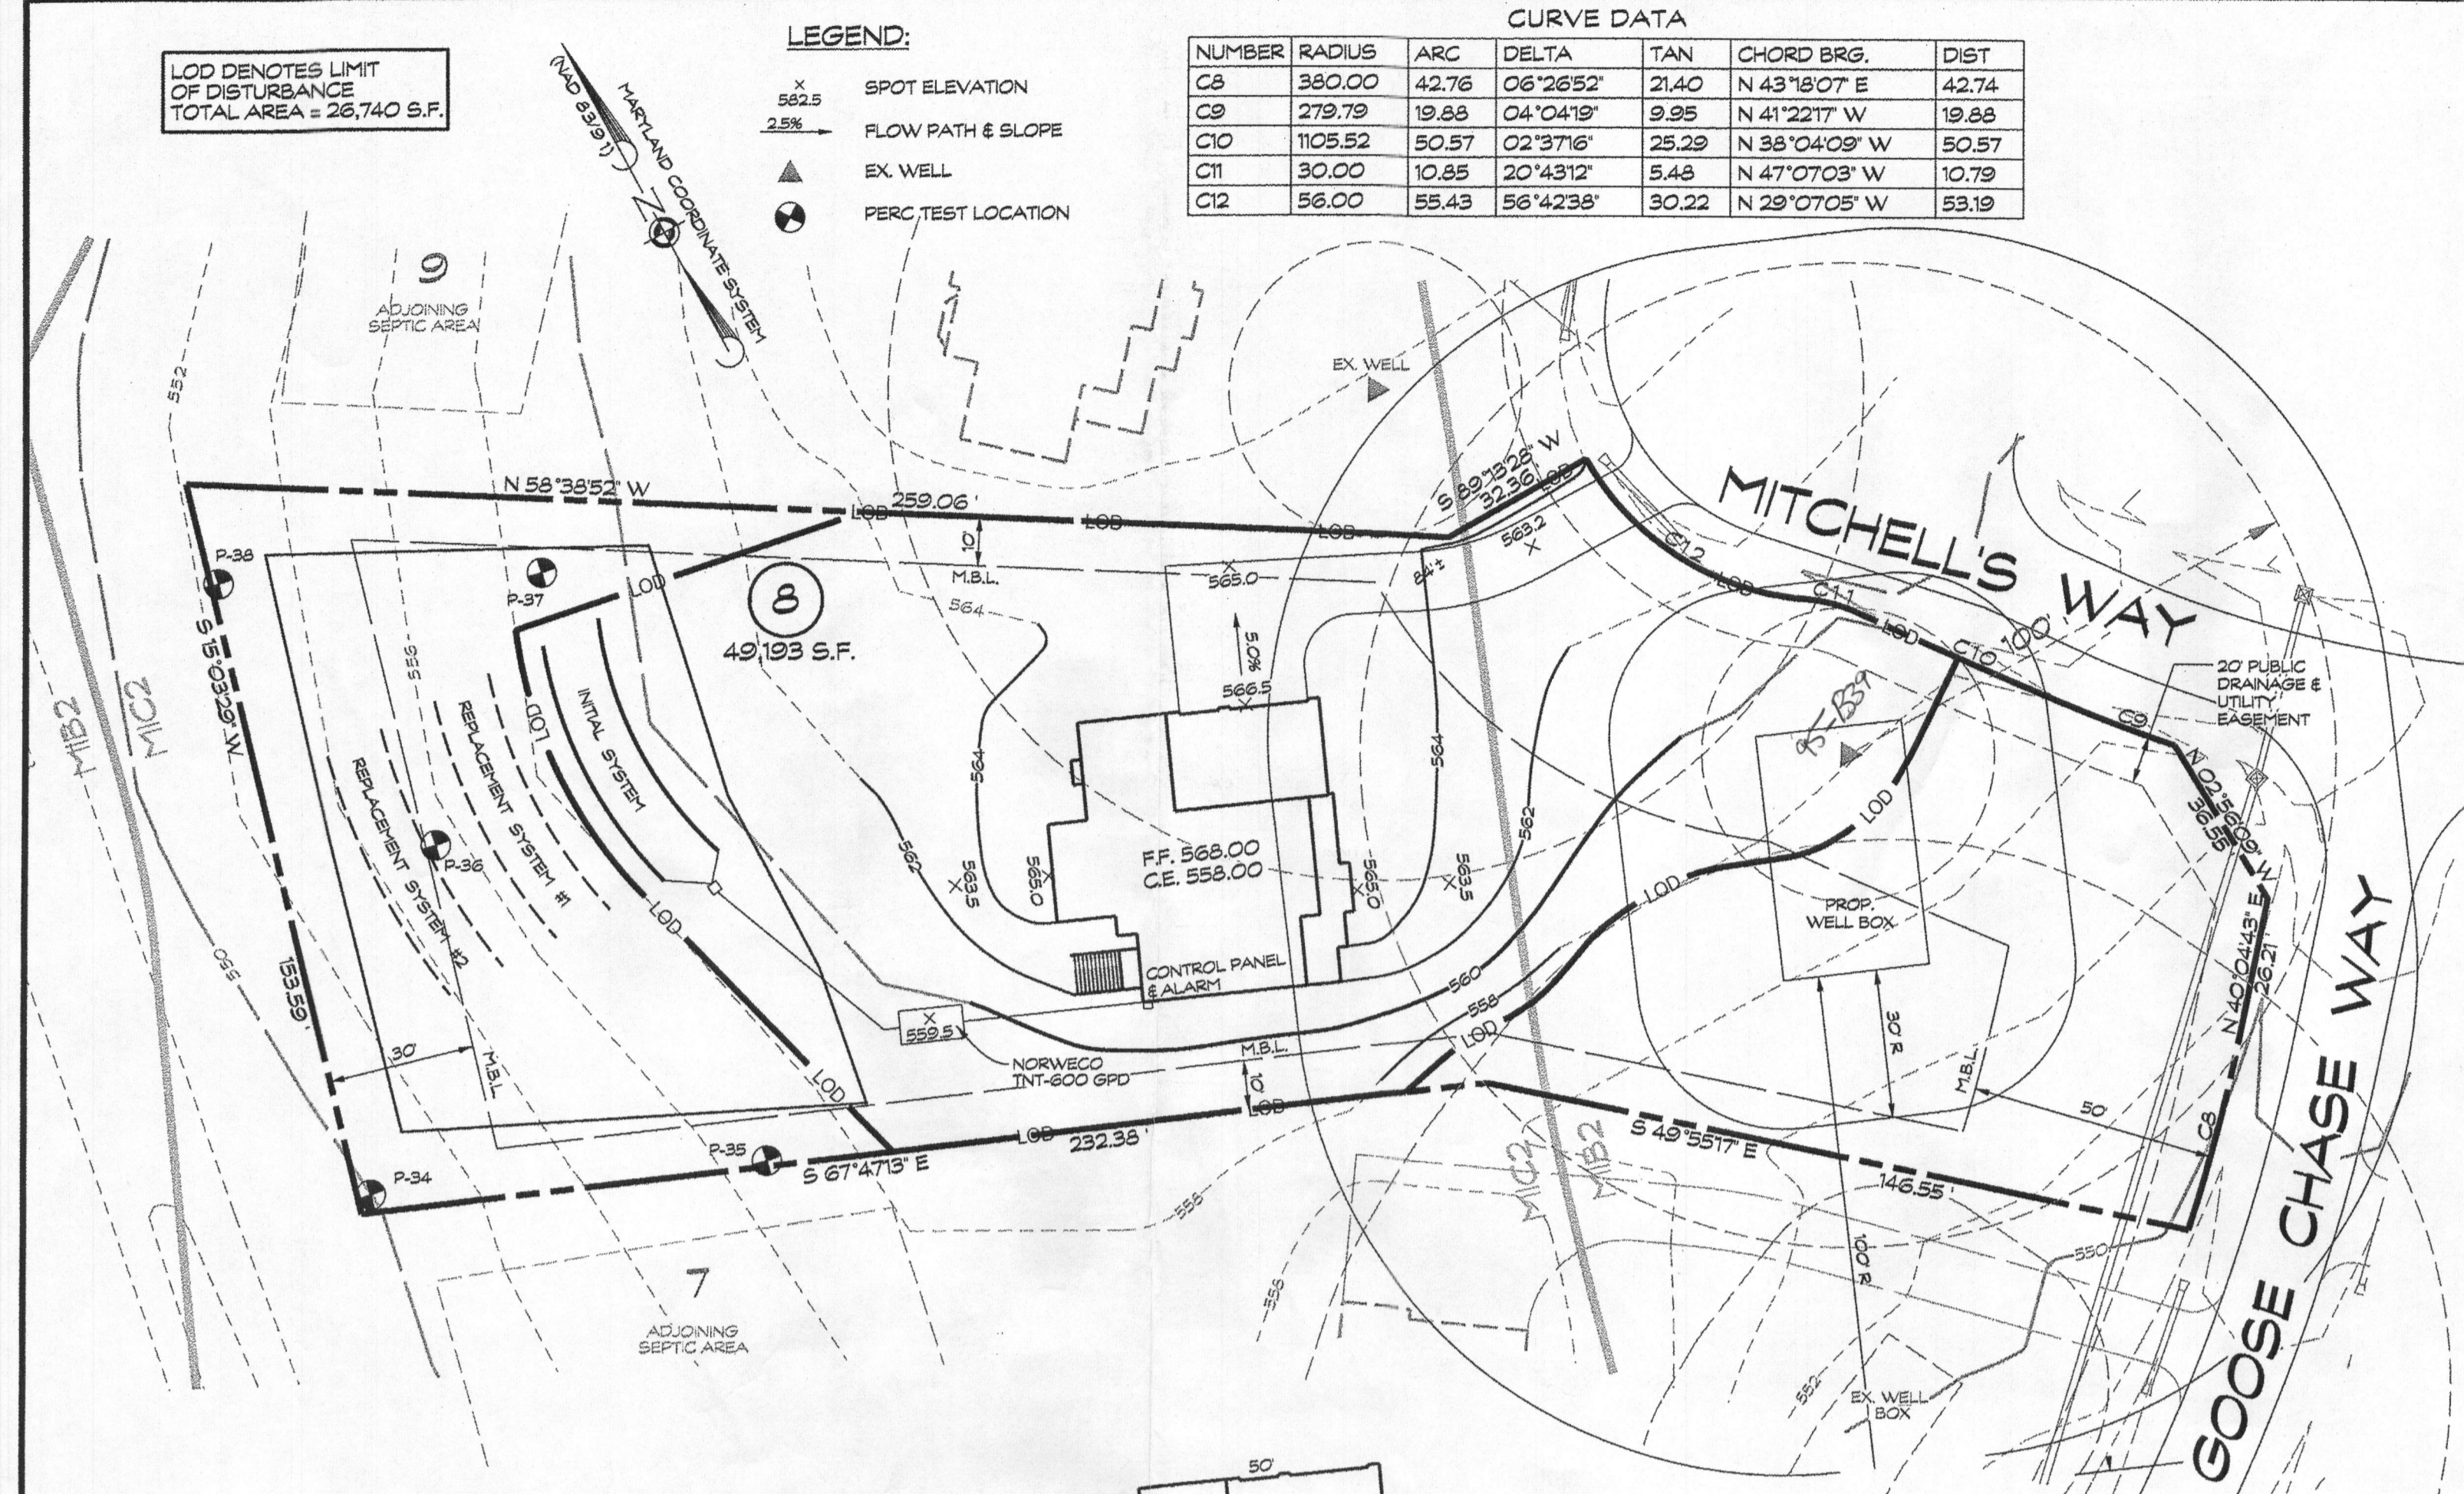

PLAN
SCALE: 1" = 30'

TRENCH CHART

TRENCH	EX. GROUND	INV. ELEV.	BOTTOM OF TRENCH
1	559.4	556.4	553.4
2	558.4	555.4	552.4

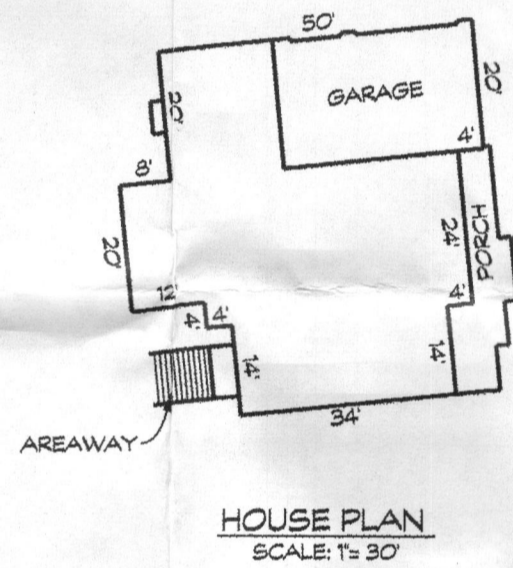

HOUSE PLAN
SCALE: 1" = 30'


NOTE:
SEPTIC DISPOSAL AREA AND PERCOLATION TEST LOCATIONS ARE FROM REVISED PERCOLATION CERTIFICATION PLAN DATED OCTOBER 2007 AND SIGNED BY HOWARD COUNTY HEALTH DEPARTMENT OCTOBER 5, 2007.

GENERAL NOTES


1. THE STORMWATER MANAGEMENT FOR THIS LOT IS PROVIDED OFF-SITE IN THE TWO MICROPOOL EXTENDED DETENTION FACILITIES AND GRASSED SWALES PER THE RECORDED PLAT NO. 20256.
2. THERE ARE NO STREAMS, PONDS, FLOODPLAINS, OR WETLANDS ON THIS LOT.
3. THERE ARE NO 20% OR GREATER SLOPES ON THIS LOT.
4. EXISTING WELL LOCATION IS FIELD LOCATED.

SEPTIC SYSTEM TRENCH DESIGN:

PROPOSED NUMBER OF BEDROOMS = 4
AVERAGE PERCOLATION TEST TIME = 3
APPLICATION RATE = 1.2
DESIGN FLOW: 150 GALS x 4 BEDROOM = 600 GAL/DAY
600 GAL/DAY / 1.2 GAL./DAY/SQ. FT. = 500 SQ. FT.
500 SQ. FT. / 2 FT. = 250 L.F. OF TRENCH
250 L.F. x 0.44 = 103.5 F. OF TRENCH = 110 L.F. USE 2 = 55 L.F. OF TRENCH FOR INITIAL SYSTEM
USE 2 = 55 L.F. OF TRENCH FOR EACH REPLACEMENT SYSTEM

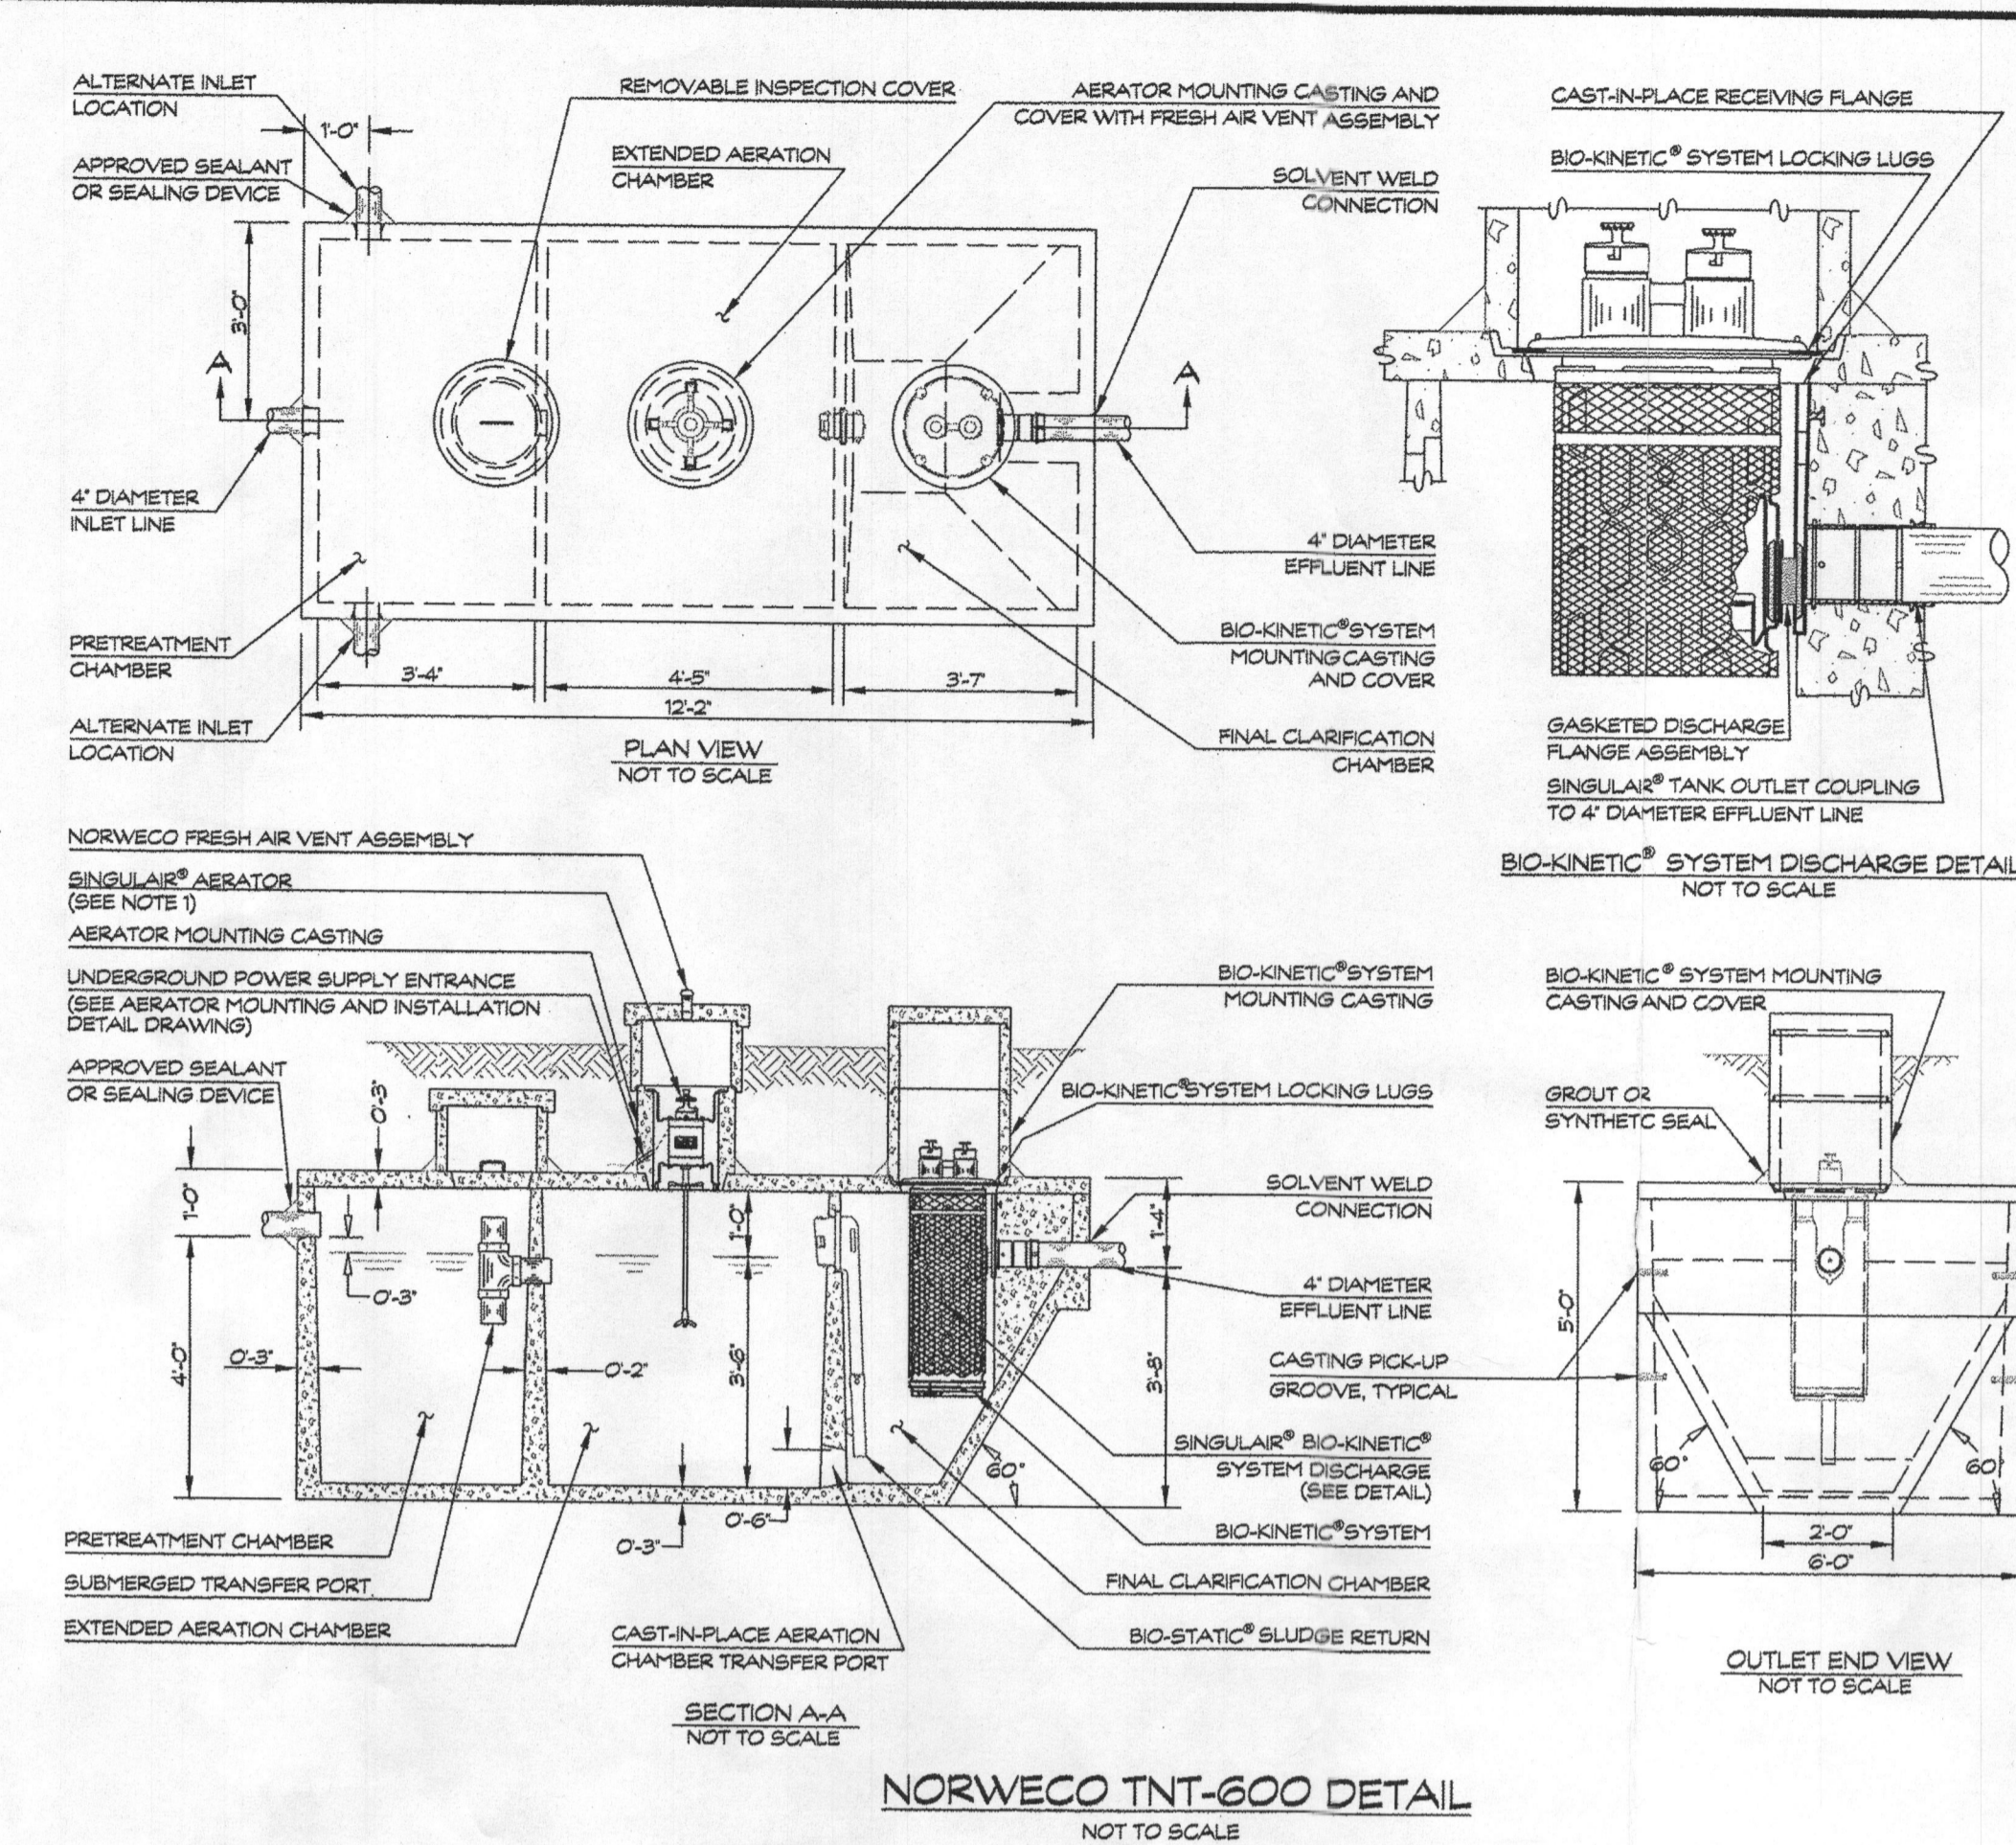

NORWECO TNT-600 DETAIL
NOT TO SCALE

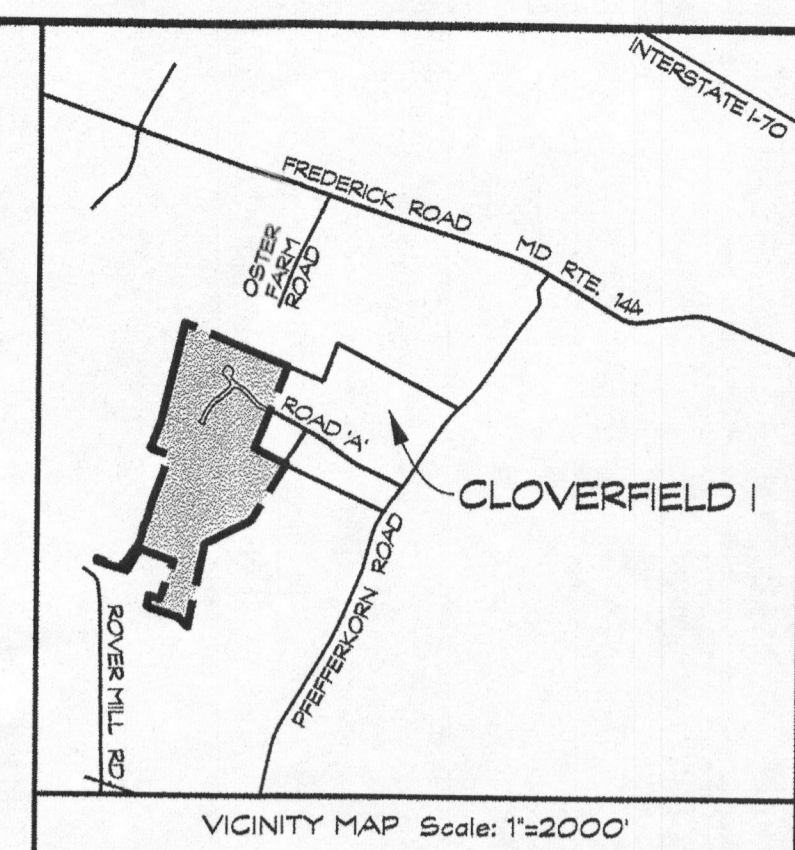

VICINITY MAP Scale: 1" = 2000'

SEPTIC TANK NOTES

1. SINGULAR® AERATOR, AS TESTED AND ACCEPTED BY NSF, OPERATING 60 MINUTES ON / 60 MINUTES OFF.
2. FALL THROUGH SINGULAR® PLANT FROM INLET INVERT TO OUTLET INVERT IS FOUR INCHES. INLET INVERT IS TWELVE INCHES BELOW TANK TOP.
3. ON DEEPER INSTALLATIONS, PRECAST RISERS MUST BE USED TO EXTEND AERATOR MOUNTING CASTING AND BIO-KINETIC® SYSTEM MOUNTING CASTING TO GRADE.
4. TANK REINFORCED PER ACI STD. 318-05.
5. REMOVABLE COVERS ON RISERS WEIGH IN EXCESS OF SEVENTY-FIVE POUNDS EACH TO PREVENT UNAUTHORIZED ACCESS.
6. CONTACT THE LOCAL, LICENSED SINGULAR® DISTRIBUTOR FOR ELECTRICAL REQUIREMENTS.

BAT SITE PLAN NOTES

1. ANY CHANGE TO THE LOCATIONS OR DEPTHS TO ANY COMPONENTS MUST BE APPROVED BY THE ENGINEER AND THE HOWARD COUNTY HEALTH DEPARTMENT PRIOR TO INSTALLATION. A REVISED SITE PLAN MAY BE REQUIRED.
2. THE MAXIMUM DEPTH OF THE BAT PER THE MANUFACTURER'S SPECIFICATION IS 3 FEET.
3. THE BAT SYSTEM SHALL BE MAINTAINED AND OPERATED FOR THE LIFE OF THE SYSTEM.
4. THE BAT SHALL BE OPERATED BY AND MAINTAINED BY A CERTIFIED SERVICE PROVIDER.
5. WITHIN ONE MONTH OF INSTALLATION, A PERSON INSTALLING THE BAT SYSTEM SHALL REPORT TO THE MARYLAND DEPARTMENT OF THE ENVIRONMENT (MDE) IN A MANNER ACCEPTABLE TO MDE, THE ADDRESS AND DATE OF COMPLETION OF THE BAT INSTALLATION AND THE TYPE OF BAT INSTALLED.
6. ELECTRICAL WORK FOR THE BAT INSTALLATION MUST BE PERFORMED BY A LICENSED ELECTRICIAN.
7. AN AGREEMENT AND EASEMENT MUST BE COMPLETED AND SIGNED BY ALL APPLICABLE PARTIES, AND RECORDED IN LAND RECORDS OR HOWARD COUNTY.
8. THE HEALTH DEPARTMENT REQUIRES DOCUMENTATION FOR THE START-UP CERTIFICATION FROM THE MANUFACTURER PRIOR TO FINAL APPROVAL OF THE INSTALLATION.
9. THE BLOWER MAY NOT BE LOCATED MORE THAN 100 FEET FROM THE TANK BASED ON MANUFACTURER'S SPECIFICATIONS.
10. IF A BUILDING PERMIT IS SUBMITTED ANY TIME IN THE FUTURE, A SEPTIC SYSTEM UPGRADE WILL BE REQUIRED TO FINISH THE AREA CURRENTLY IDENTIFIED AS THE BASEMENT. AT THAT TIME A SEPTIC SYSTEM UPGRADE WILL BE REQUIRED AS FINISHING THE BASEMENT COULD POSSIBLY CREATE A FIFTH BEDROOM PER HOWARD COUNTY CODE 3.80 1(B).

OWNER/DEVELOPER
SPRING HILL LLC
P.O. BOX 417
ELLICOTT CITY, MD 21041

SITE PLAN AND PLOT PLAN FOR BAT INSTALLATION
SPRING HILL LLC
13609 MITCHELLS WAY
TAX ACCOUNT NO.: 353451
LOT 8
CLOVERFIELD- SECTION II
3RD ELECTION DISTRICT • HOWARD COUNTY, MD.
TAX MAP: 15 BLOCK: 7 PARCEL: 119

Linda D. Alexander
7-17-15

CLSI
Engineers • Surveyors
Land Planning & Environmental Consultants
www.clsi-civileng.com
439 East Main Street Westminster, MD 21157-5539
(410) 848-1790 FAX (410) 848-1791

Date	Revisions	Drawn By:
8/23/15	REVISED HOUSE LOCATION	Designed By: LDA
7/17/15	REVISED TO ADD NOTE BUILDING PERMIT NOTE PER HEALTH DEPT.	Reviewed By: LDA
		Date: 6/12/15
		Scale: 1" = 30'
		Job No.: 2013039
		Sheet: 1 OF 1