


owner:
Anita Wilcox
685 Gaither Rd
Sykesville MD 21784


Contractor: STK Roofing Siding Windows
5399 Enterprise St.
Eldersburg MD 21784
Daniel A. Rupert.

I certify that the information shown hereon
is based on work performed in my presence
or by my direction, AND is correct to the
best of my knowledge & belief.

Dan A. Rupert 3/26/08

- 1- Topography on this plat as indicated and approved by R. Hodges (11/14/77)
- 2- The lot shown hereon complies with the minimum ownership width and lot area as required by the Maryland Department of Environment.
- 3- any changes to a private sewage easement shall require a revised percolation cert. plan
- 4-  This area designates a private sewage easement as required by the Maryland Dept. of Environment for individual sewage disposal. Improvements of any nature in this easement are restricted. This easement shall become null & void upon connection to a public sewage system. The county health officer shall have authority to grant adjustments to the private sewage easement. Recordation of a revised sewage easement shall not be necessary.
- 5- The area of this lot was first percolation tested for subdivision in June 1975.
- 6- The entire subject property is within a GgB soil map unit.
- 7- The purpose of this percolation certification plat is to construct a 336 sq ft Deck.
- 8- All existing wells on the subject property and within 100 feet of subject property boundaries are represented to the best of my knowledge & belief.
- 9- A soil profile + descriptions + percolation tests will be required prior to any septic system repair or upgrade.

Percolation Certification Plan
685 Gaither Road
PC 21540
March 26, 2008

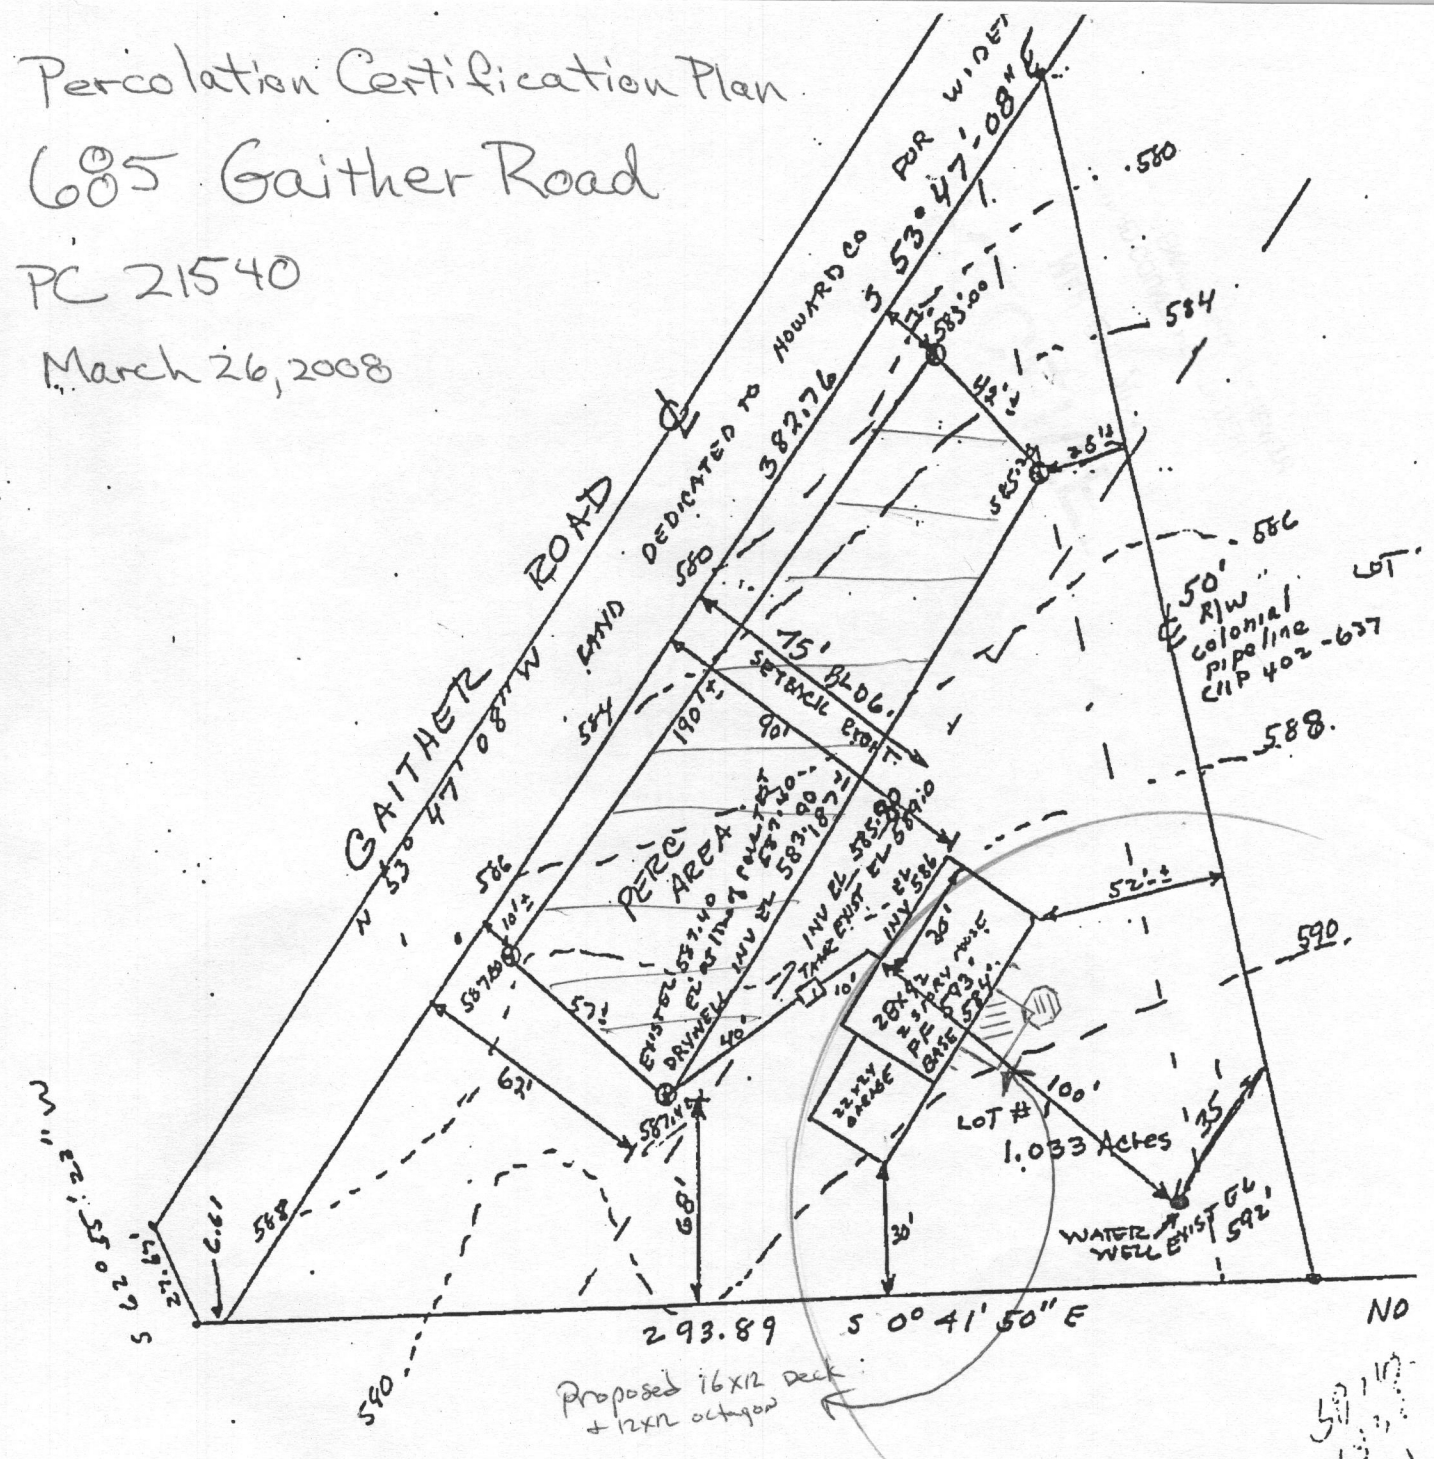

I certify the above measurements
are actual & correct for this property
Mark Z. Chok
PLANS OK R/H 11/14/77

LOT #1 HEUBNER PROPERTY
GAITHER ROAD 320 ELECTION DIST.
HOWARD COUNTY, SYKESVILLE, MD.
FINAL PLAT # F-76-07
LIBERTY 722 FOLIO 607 SCALE 1"=50'

Approved for private water and private sewerage systems

Bruce Peter Brilensen
SIGNATURE

4/3/2008
Date signed